


MAP SHOWING THE PARTS OF  
 LOTS 5 & 6 SEC. 28 T28S R7W W. M.  
 LYING SOUTH OF  
 ROSEBURG-COOS BAY HIGHWAY

OFFICE OF  
 H. L. EPPSTEIN CO SURVEYOR  
 MAR 1926  
 SCALE 1" = 200'

NOTE  
 THE DISTANCE GIVEN IN  
 CHAINS ARE TAKEN FROM  
 GOVT. NOTES THE EAST  
 AND SOUTH LINES WERE  
 CALCULATED.

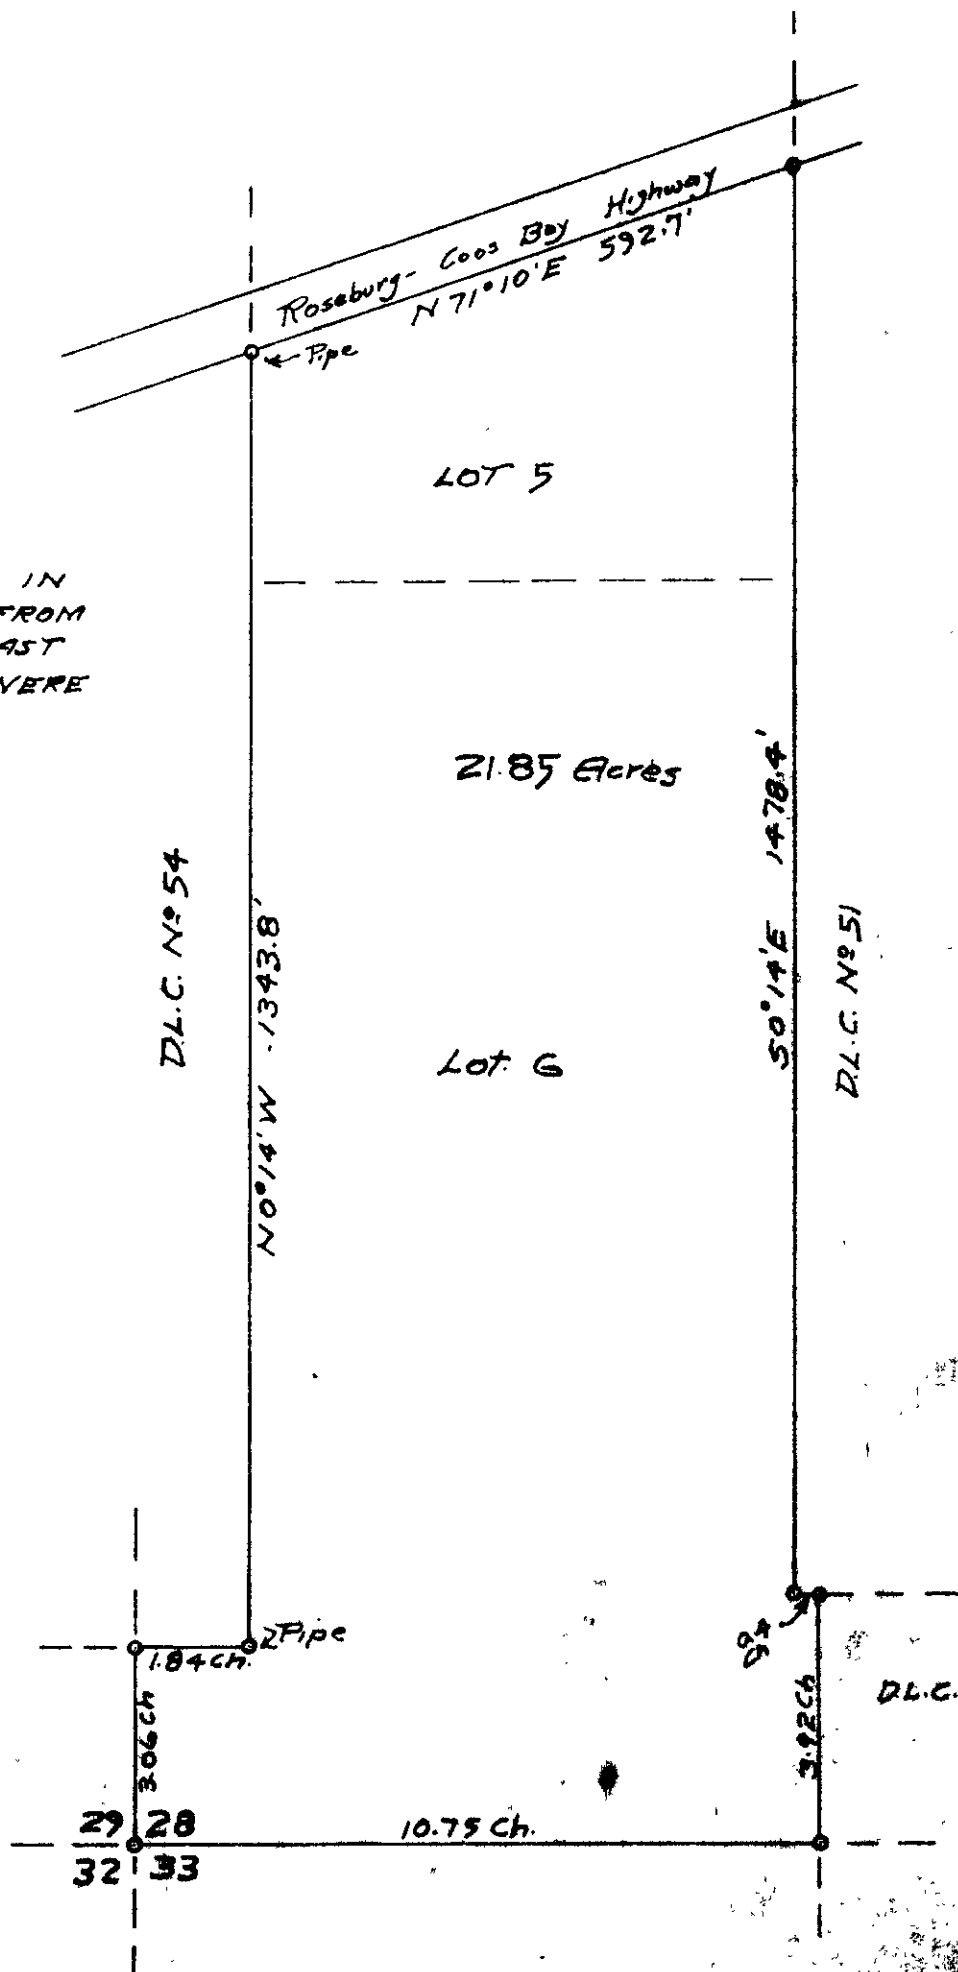

D.L.C. No 53