224

COUNTY SURVEYOR'S RECORD, DOUGLAS COUNTY, OREGON

BUSHONG & CO. PORTLAND, ORE. 87545

CS 41/209

Survey No.	Made on Aug. 8-9- 1926
In Town. 27	Range 5 Sec. 18
Made for	Brush
Purpose of	Lines of Lots 8-9- Block 4 Crescent Heights Add. to Roseburg H.L. Epstein Surveyor.
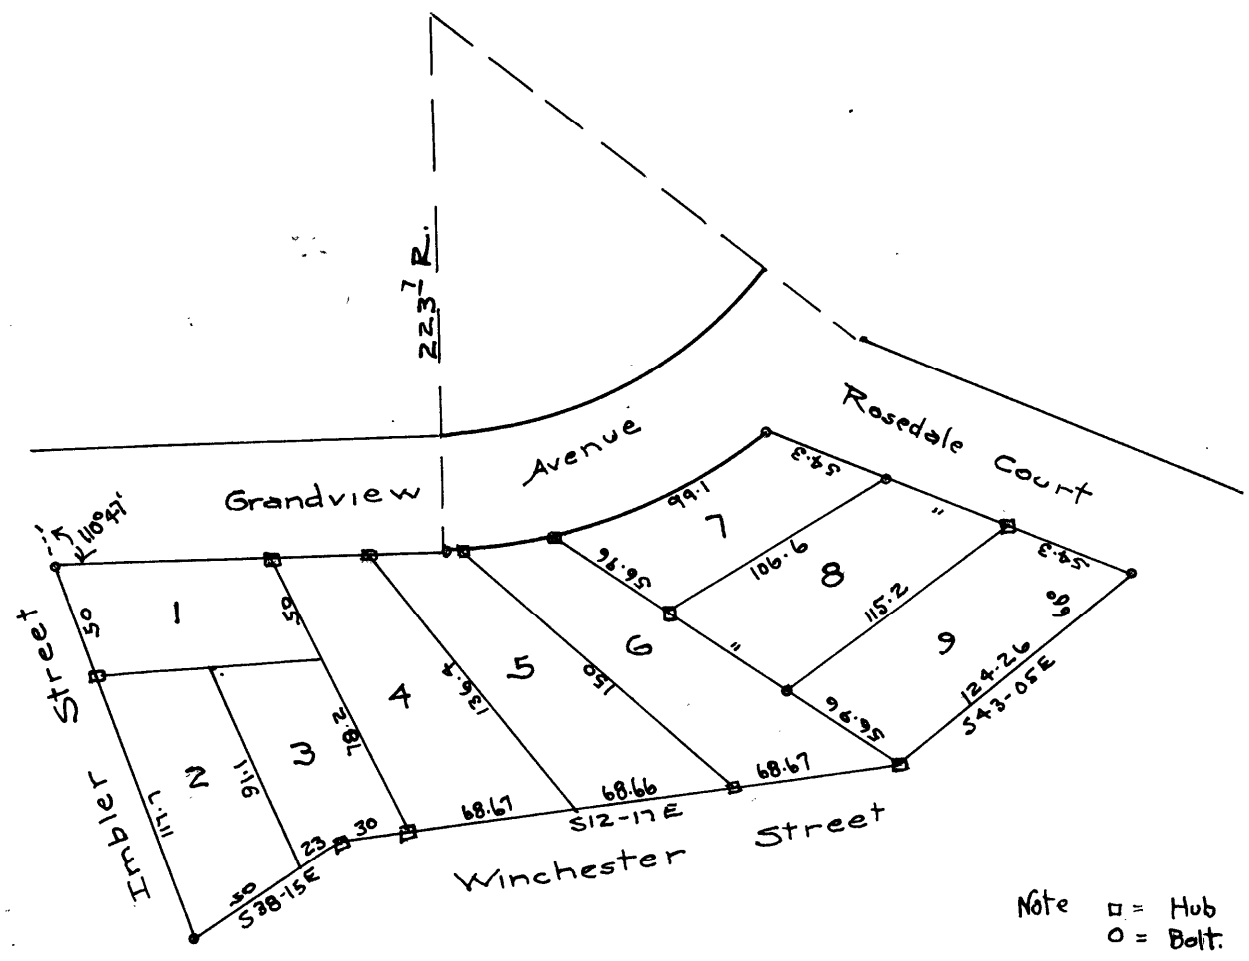
Survey No.	Made on
In Town.	Range Sec.
Made for	
Purpose of