29

COUNTY SURVEYOR'S RECORD, DOUGLAS COUNTY, OREGON

BUSHORG & CO. PORTLAND, ORE. 87545

Survey No. 37 *Made on* July 9 & 10, 1936.

In Town. 28 S. *Range* 6 W. *Sec.* 16

Made for M.B.Green, Winston

Purpose of to determine acreages in the R.U.Green Tract in N½ of the N½ section 16

M.B.Green Rr.Chain
N.E.Richardson Hd Chain A.B. Inst. P

V23-E46

Survey No. 38 *Made on* Oct 7, 1936

In Town. 27 S. *Range* 6 W *Sec.* 13 Fruitvale

Made for Establish corners of W.2.0 acres of Lot 14, Fruitvale Survey made for ~~Purpose of~~ Roseburg National Bank, by Vern Orr. by Arthur Boyer and H.L.Eppstein, County Sur. ℄Inst and Rr.Ch ℄Hd Ch. Notes

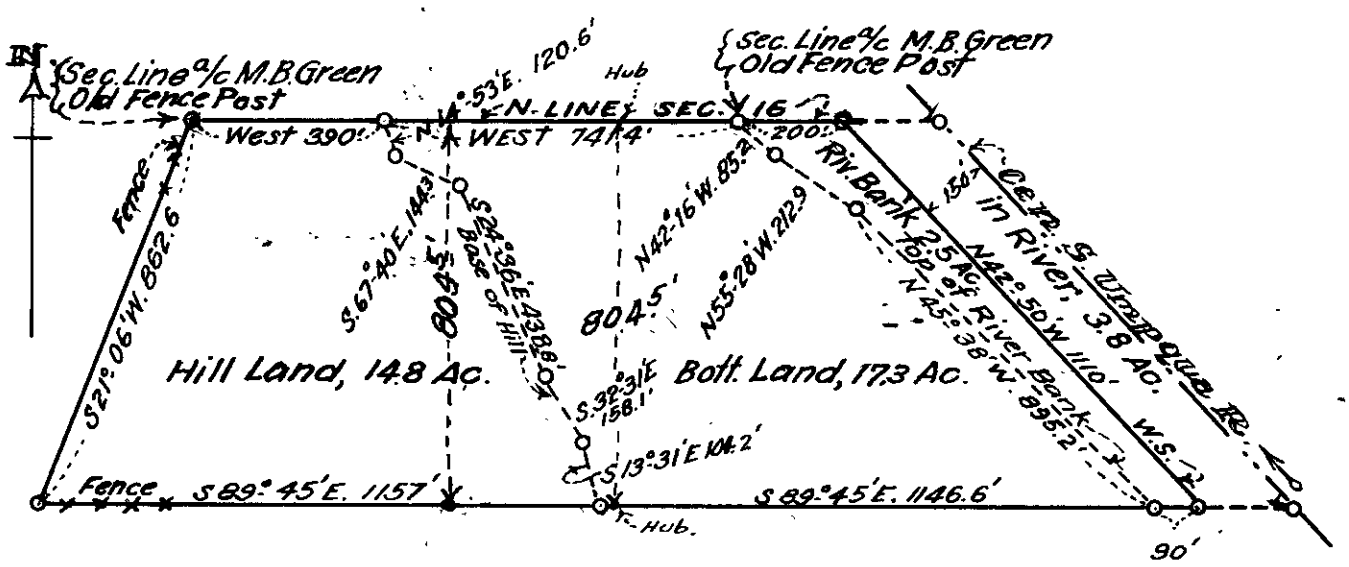

This survey was made to determine acreage in the R.U.Green tract according to the deed record 96/487 and also the acreages for its topographic segregations, starting at the N.W. corner at an oak post and running East, to another oak post, on river bank; M.B.Green testifies that these posts which line up with an old E.& W. fence line, are on the North line of section 16; the remaining boundary lines were run out according to the deed records which checked close with fences which are in. The annexed plat shows surveyed lines and computed areas.

Arthur Boyer
Dep.County Surveyor

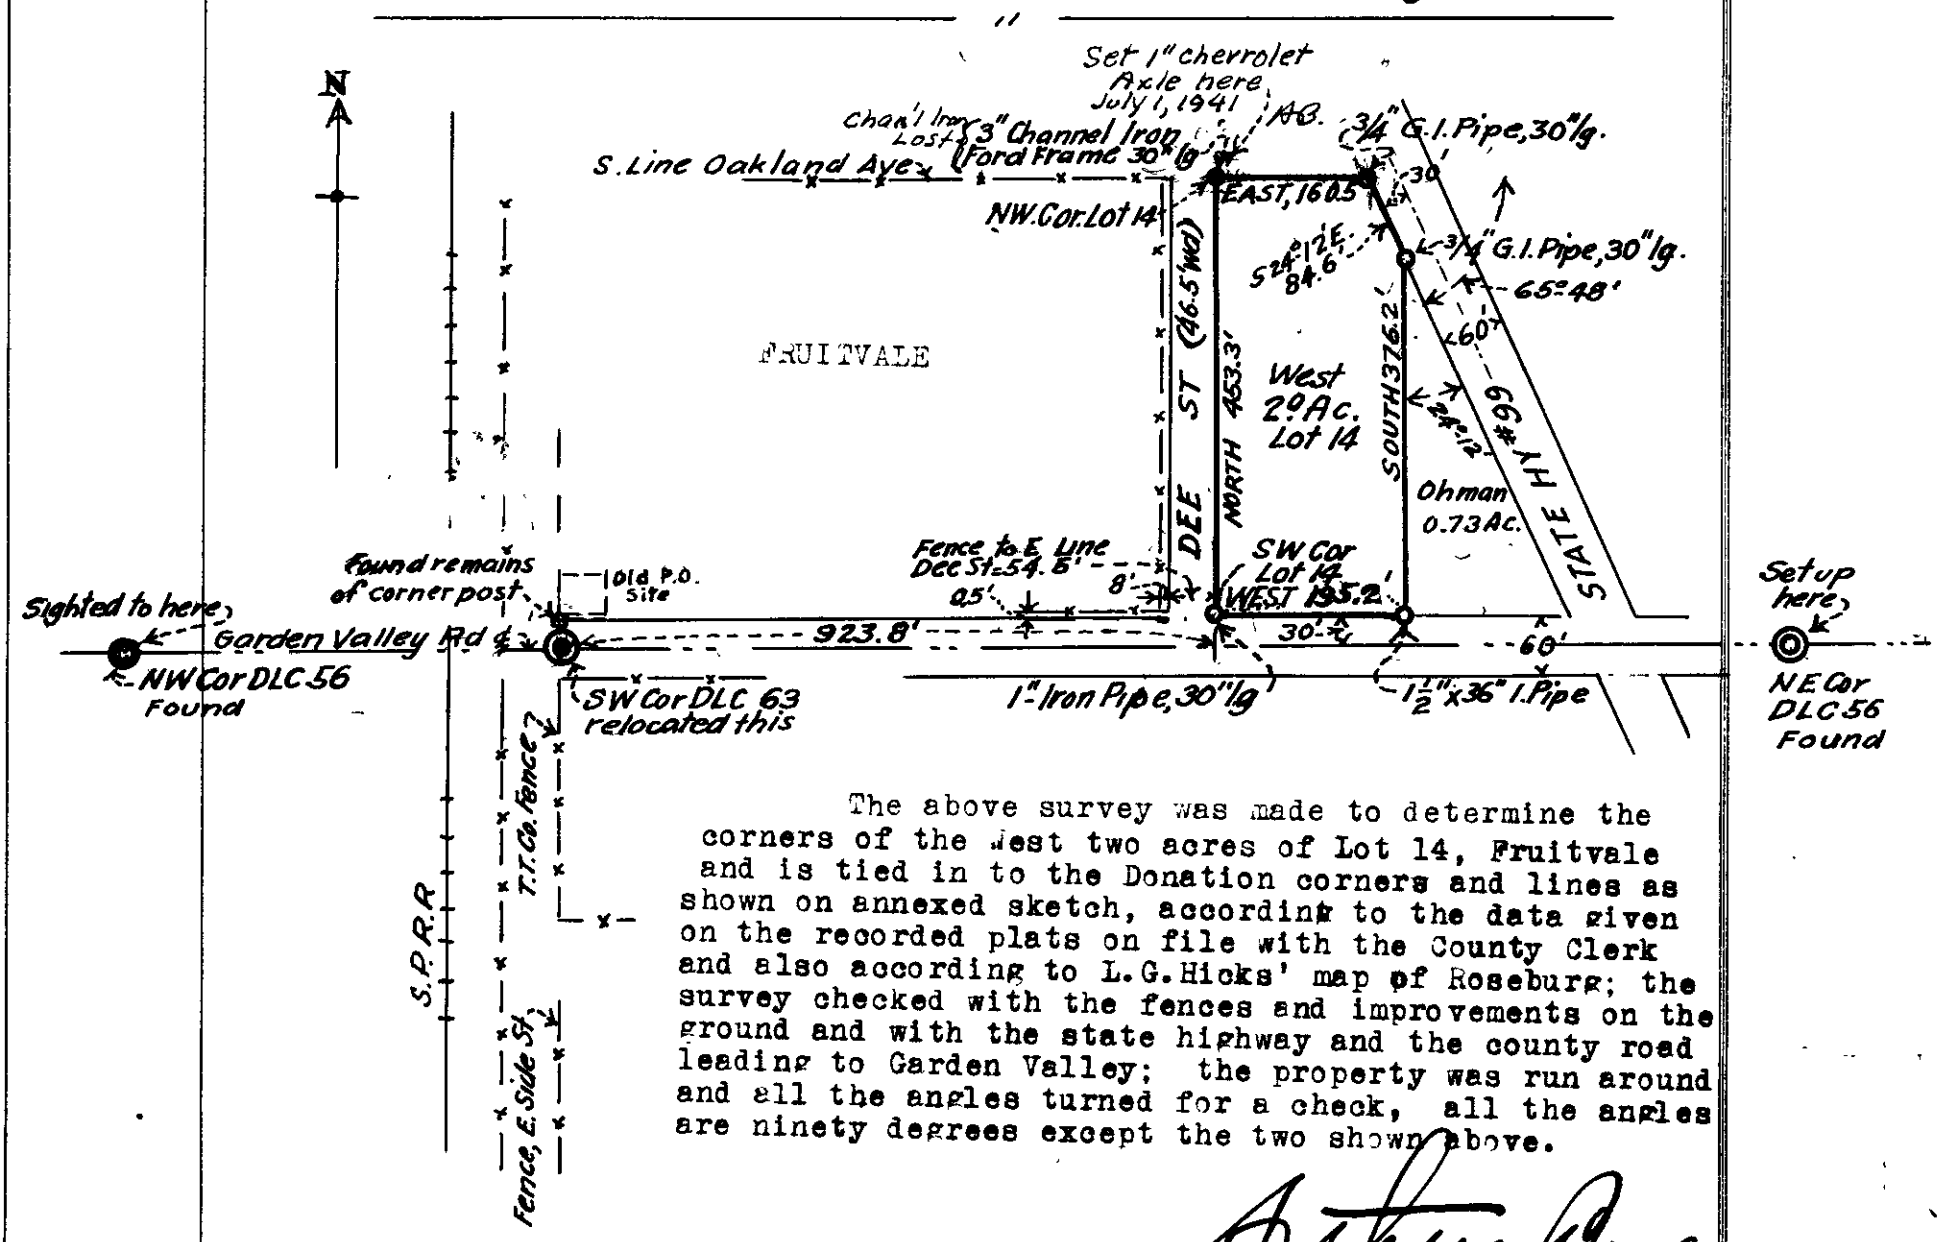

The above survey was made to determine the corners of the West two acres of Lot 14, Fruitvale and is tied in to the Donation corners and lines as shown on annexed sketch, according to the data given on the recorded plats on file with the County Clerk and also according to L.G.Hicks' map of Roseburg; the survey checked with the fences and improvements on the ground and with the state highway and the county road leading to Garden Valley; the property was run around and all the angles turned for a check, all the angles are ninety degrees except the two shown above.

Arthur Boyer
Arthur Boyer, Dep Co. Surveyor

V23
E61