31

COUNTY SURVEYOR'S RECORD, DOUGLAS COUNTY, OREGON

BUSHONG & CO. PORTLAND, ORE. 87545

Survey No. 41 *Made on* Oct 5th 1936

In Town. 27 S; *Range* 7 W. *Sec.* 1

Made for Simon Lundahl

Purpose of to determine acreage of "Florence Burns' share of the Johnston (her father's) estate and to establish the west line of her part which is supposed to be the N. line of lots 11, 19 and 29, Town of Melrose.

Mr Buffington and Mr Lundahl helping on survey; CS 23/66

Survey No. 42 *Made on* Oct 20, 1936

In Town. 27 S *Range* 5 W *Sec.* Roseburg

Made for J.B. Bailey et ux.

Purpose of to locate corners of N½ Lot 3 and lots 4 & 5 Block 13 Orig Town of Roseburg.

N.E. Richardson Helping. C.S 23/69

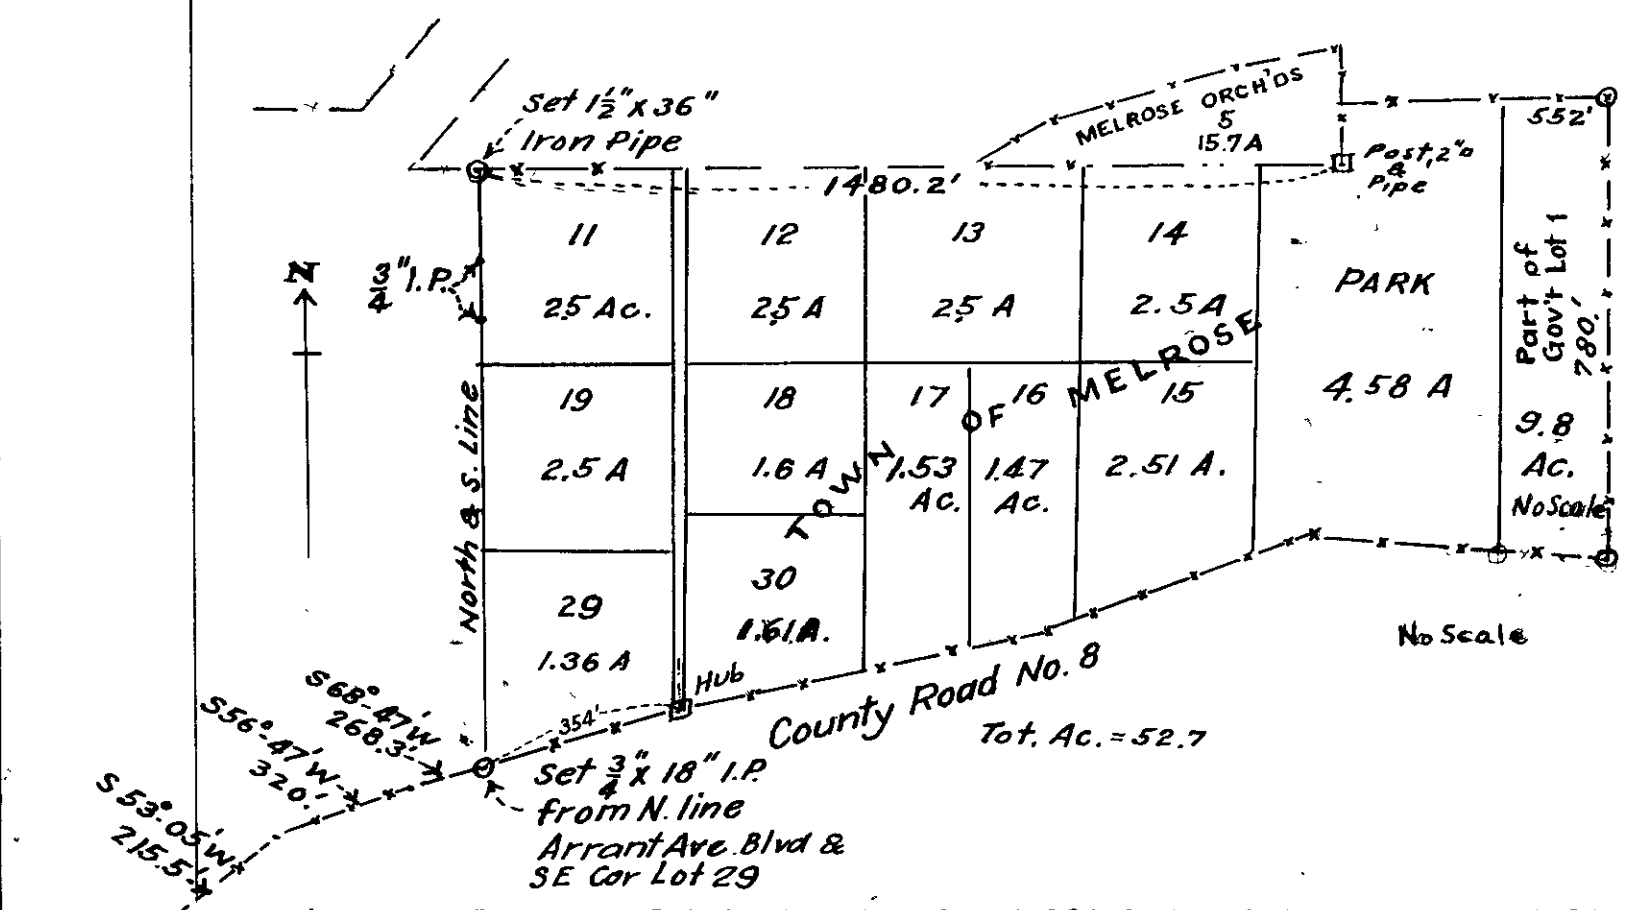

Ran around this tract and established points on the West line as shown on annexed sketch; the south line is the North line of the county road, the east line is bounded by an old fence as is also the North line; there is a fence on the south line. the West line has not been fenced to date.

Arthur Boyce
Dep. Co. Surveyor.
V23 #66

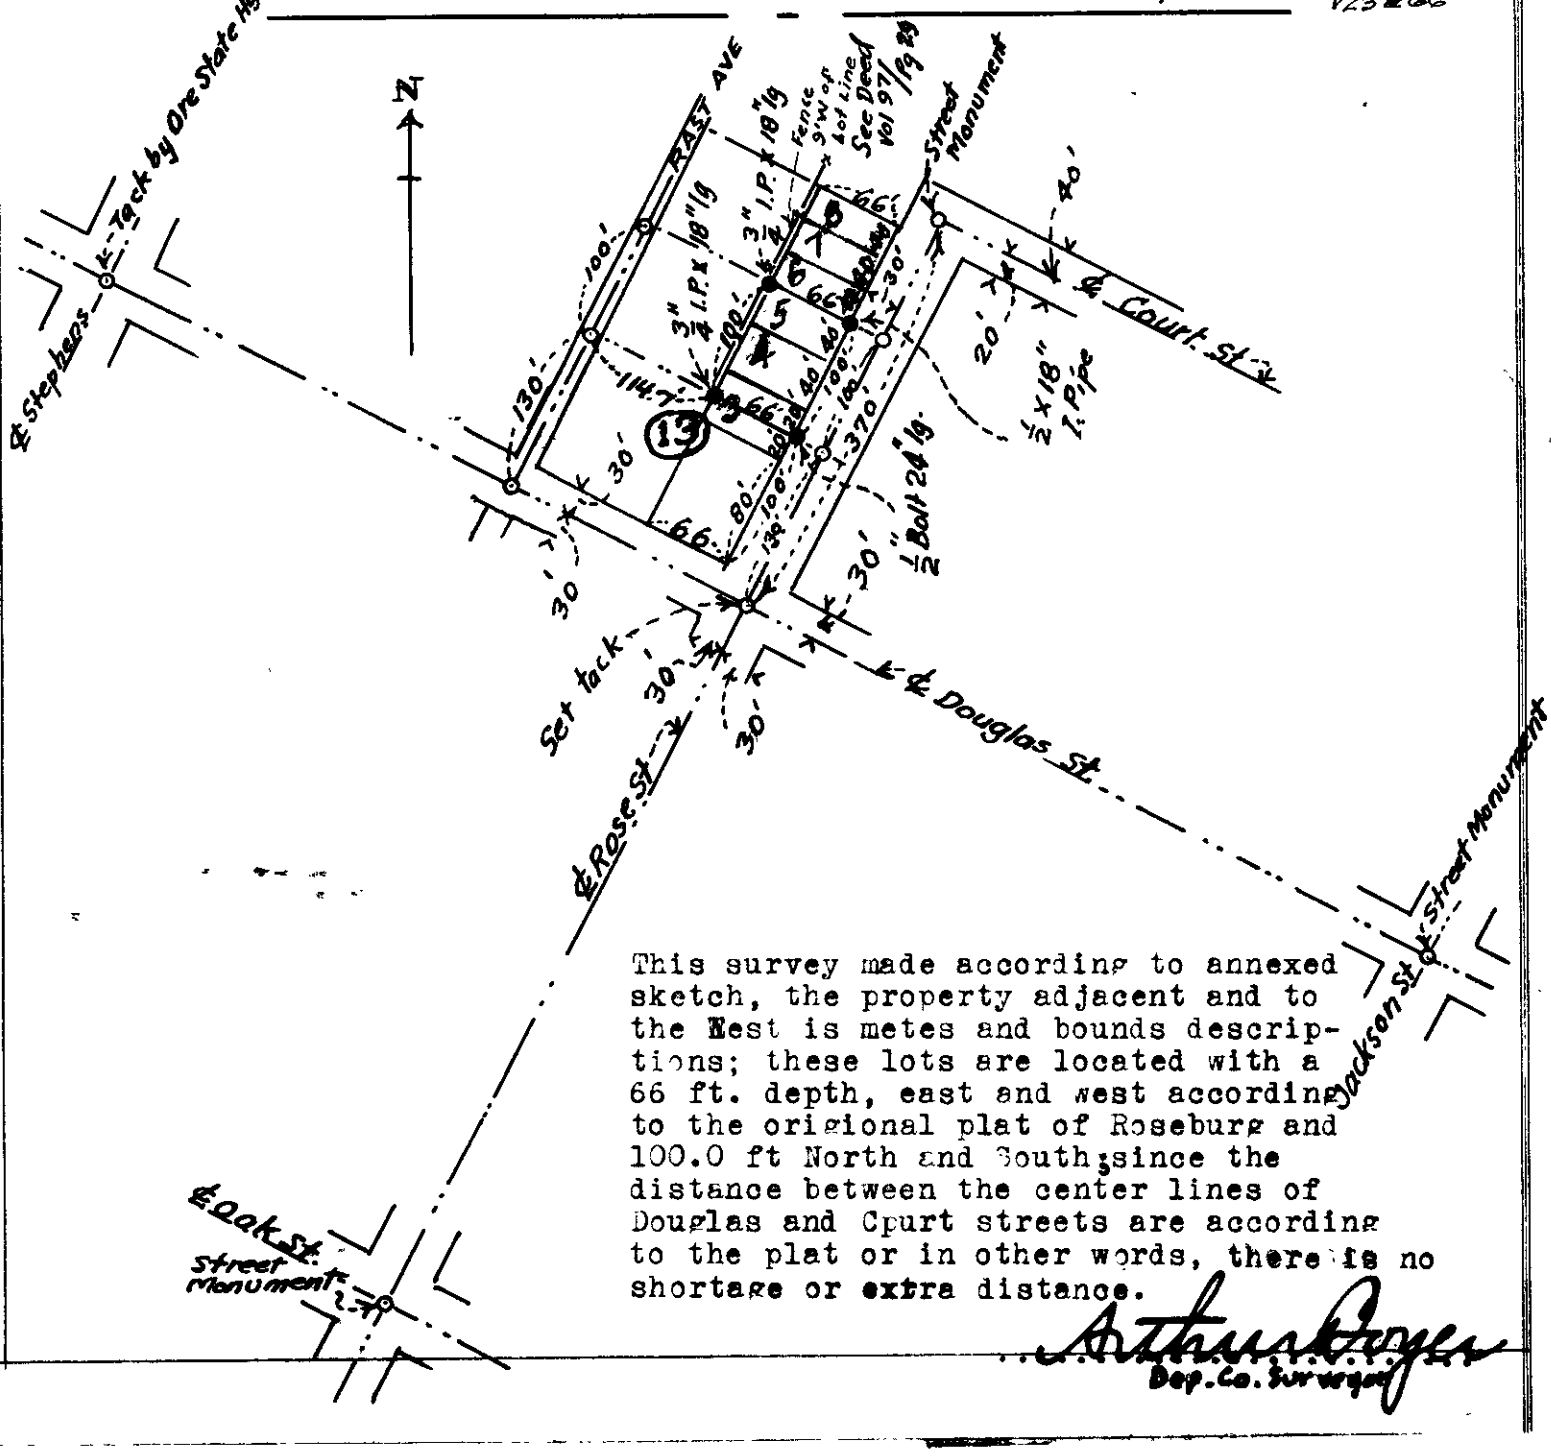

This survey made according to annexed sketch, the property adjacent and to the West is metes and bounds descriptions; these lots are located with a 66 ft. depth, east and west according to the original plat of Roseburg and 100.0 ft North and South; since the distance between the center lines of Douglas and Court streets are according to the plat or in other words, there is no shortage or extra distance.

Arthur Boyce
Dep. Co. Surveyor