(79)

COUNTY SURVEYOR'S RECORD, DOUGLAS COUNTY, OREGON

BUSHONG & CO. PORTLAND, ORE. 87545

Survey No. Made on July 8, 1941

In Town. 24 S. Range 3 W. Sec. 20

Made for Walter and Mrs Annie (widow of Almon) Cook

Purpose of to show, on ground, subdivision of SE¼ Sec 20

Walter Cook and Mrs Annie Cook assisting with survey. Walter C. & Mrs Cook } up to 2:30 PM Mrs Cook 2:30 to 5:30 PM. :34 = 52

Survey No. Made on May 20, 1941

In Town. 27 S Range 5 W Sec. 19

Made for Mr. Cardwell

Purpose of to establish E line Cardwell property E. of Fowler St and S. of Second Ave S. Part of Lot 1, Busheys Add

V 35 - E 1

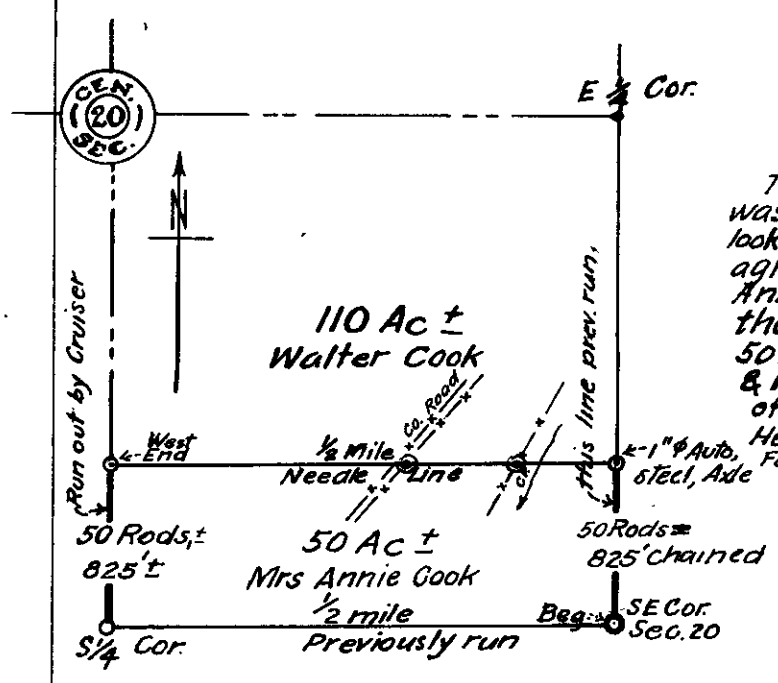

This line, 50 Rods North of the S. line of SE¼ of Sec 20, was run to show how division of SE¼ as shown here would look on the ground - The method used was based on an agreement made between Mr Walter Cook and Mrs Annie Cook who assisted in the survey; they understood that no fine degree of accuracy was gotten for N. line of 50 Ac. tract but they preferred not to spend much time & money & were satisfied with the results. The E end of this North line is O.K. the west end, approx. O.K. Heavy, thick brush & windfalls - on both sides of Creek Foggy AM. Clear, Hot, P.M.

Arthur Boyer
Dep. County Surveyor

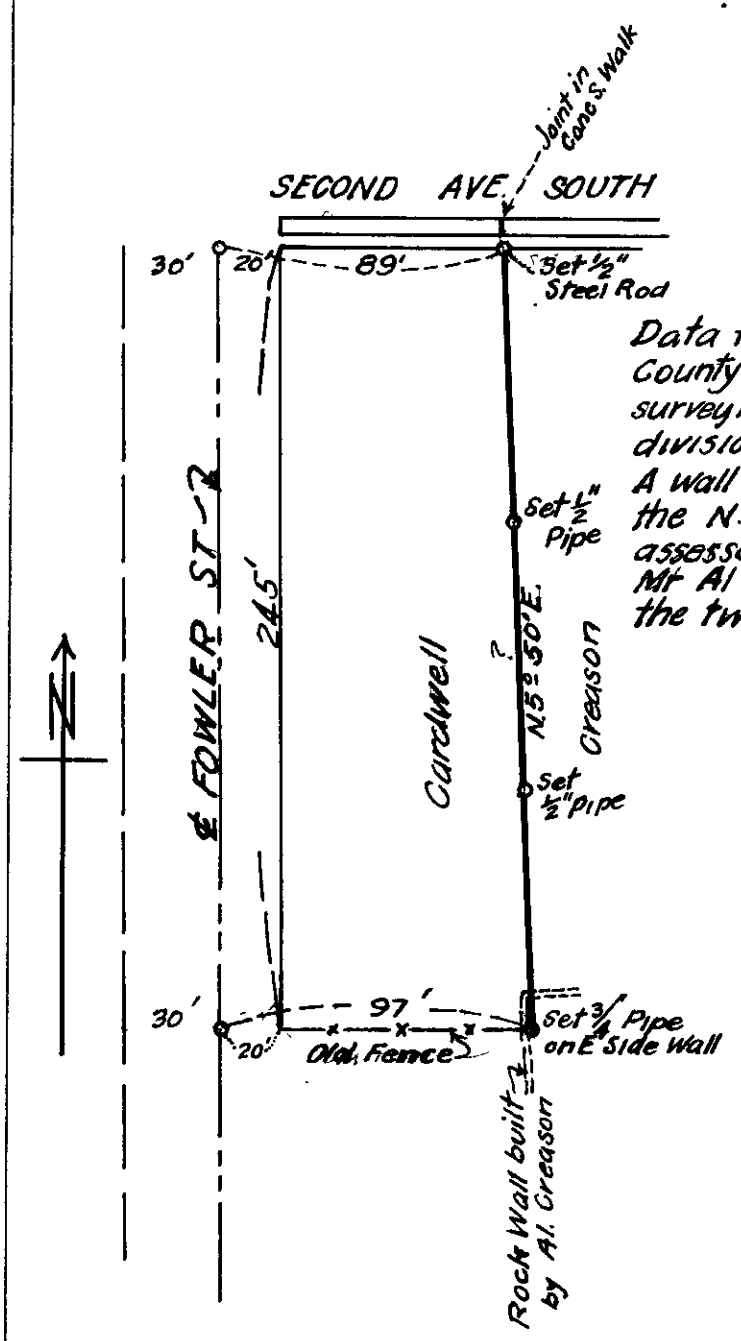

Data for locating this line was gotten from files in County Assessor's office which is an engineers record of survey made to establish this East line which gives the division bet. the Cardwell and the Al. Creason properties A wall at the S. end and a joint in the concrete walk at the N. end check with the figures gotten in the assessors office - Mr Cardwell stated that he helped Mr Al Creason build this wall "on the line" between the two properties

Arthur Boyer
Dep. County Surveyor