COUNTY SURVEYOR'S RECORD, DOUGLAS COUNTY, OREGON

BUSHONG & CO PORTLAND, ORE. 87545

Survey No. Made on Oct 1941

In Town. 25 S. Range 3W Sec. 4

Made for Young & Co Bank, Oakland, Ore

Purpose of establishing lines for Logging operations by Pete Gourley.

A. Boyer ⊼
Wm Crear chain
Chas Hughes & Wilbur Williams Axe

Survey No. Made on May 1941

In Town. 30 S. Range 5W. Sec. 20

Made for W. W. Willis

Purpose of - For correcting deed description previously made.
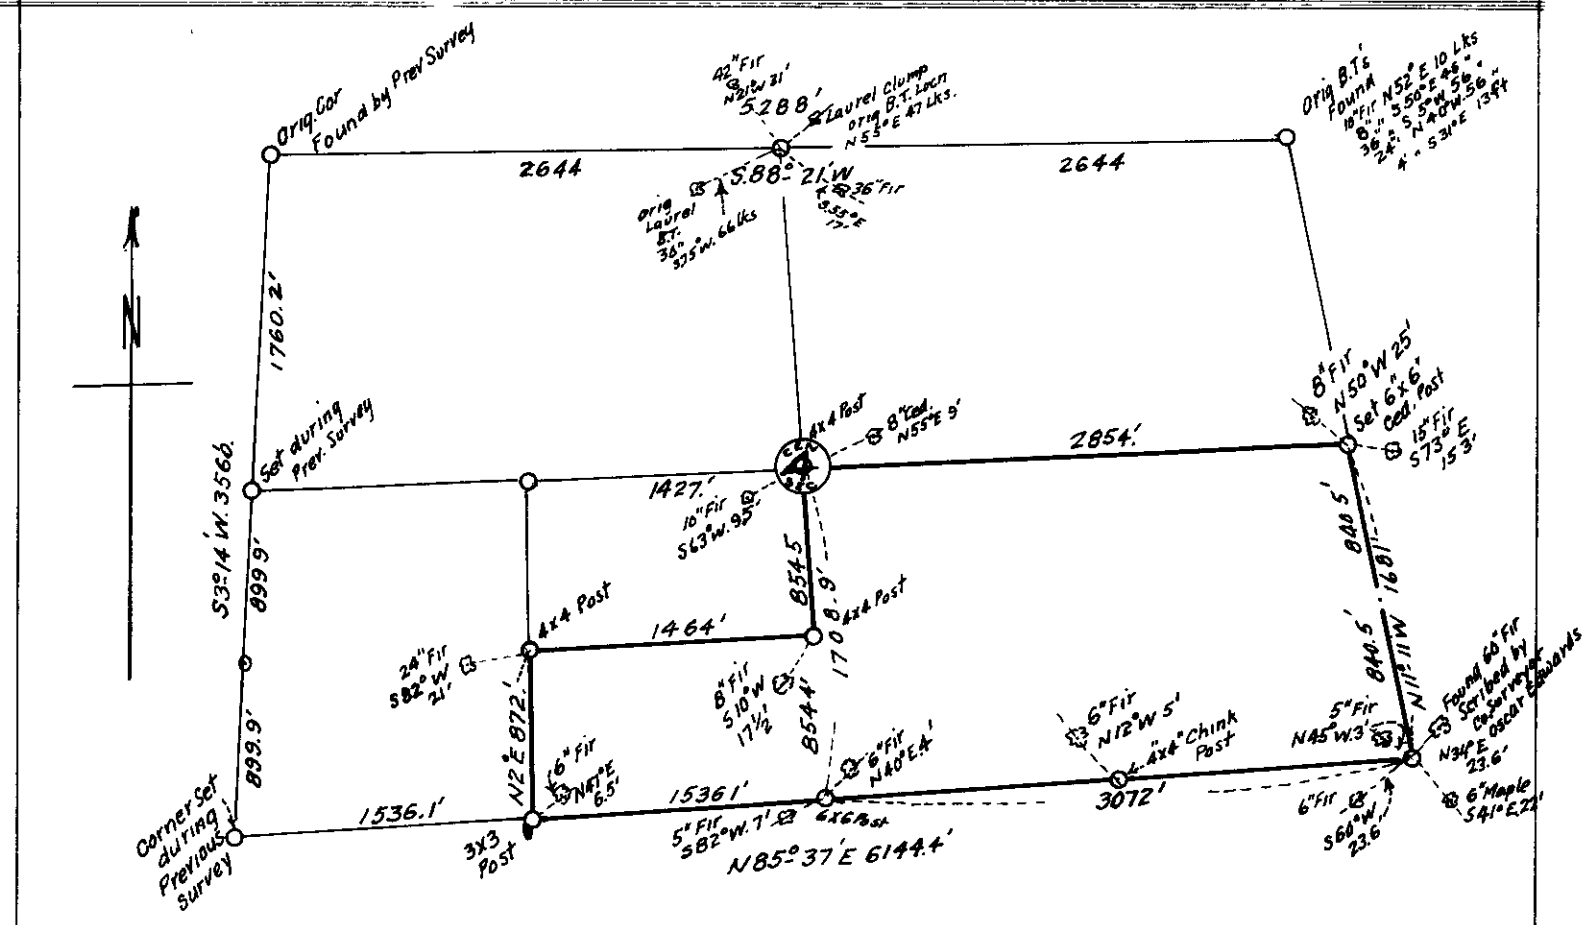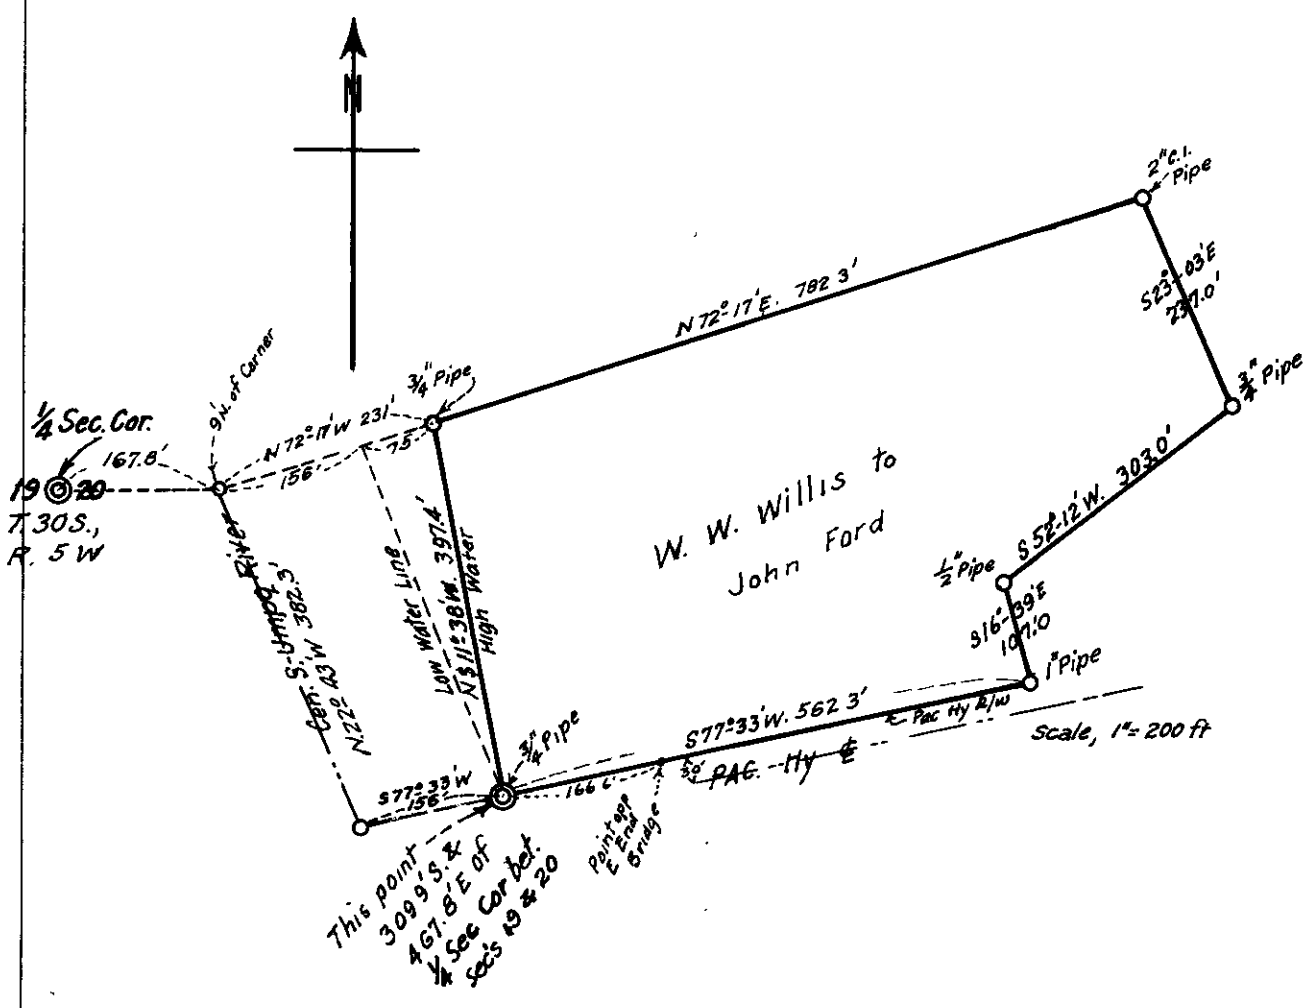
A Boyer.