(81)

COUNTY SURVEYOR'S RECORD, DOUGLAS COUNTY, OREGON

BUSHONG & CO. PORTLAND, ORE. 87545

Survey No. Made on Sept. 1, 1939	Survey No. Made on
In Town. Range Sec. in Roseburg City Limits	In Town. Range Sec.
Made for Stan Oil Co	Made for
Purpose of Lease Lines	Purpose of
A Boyer.	
Map Tracing D-55	
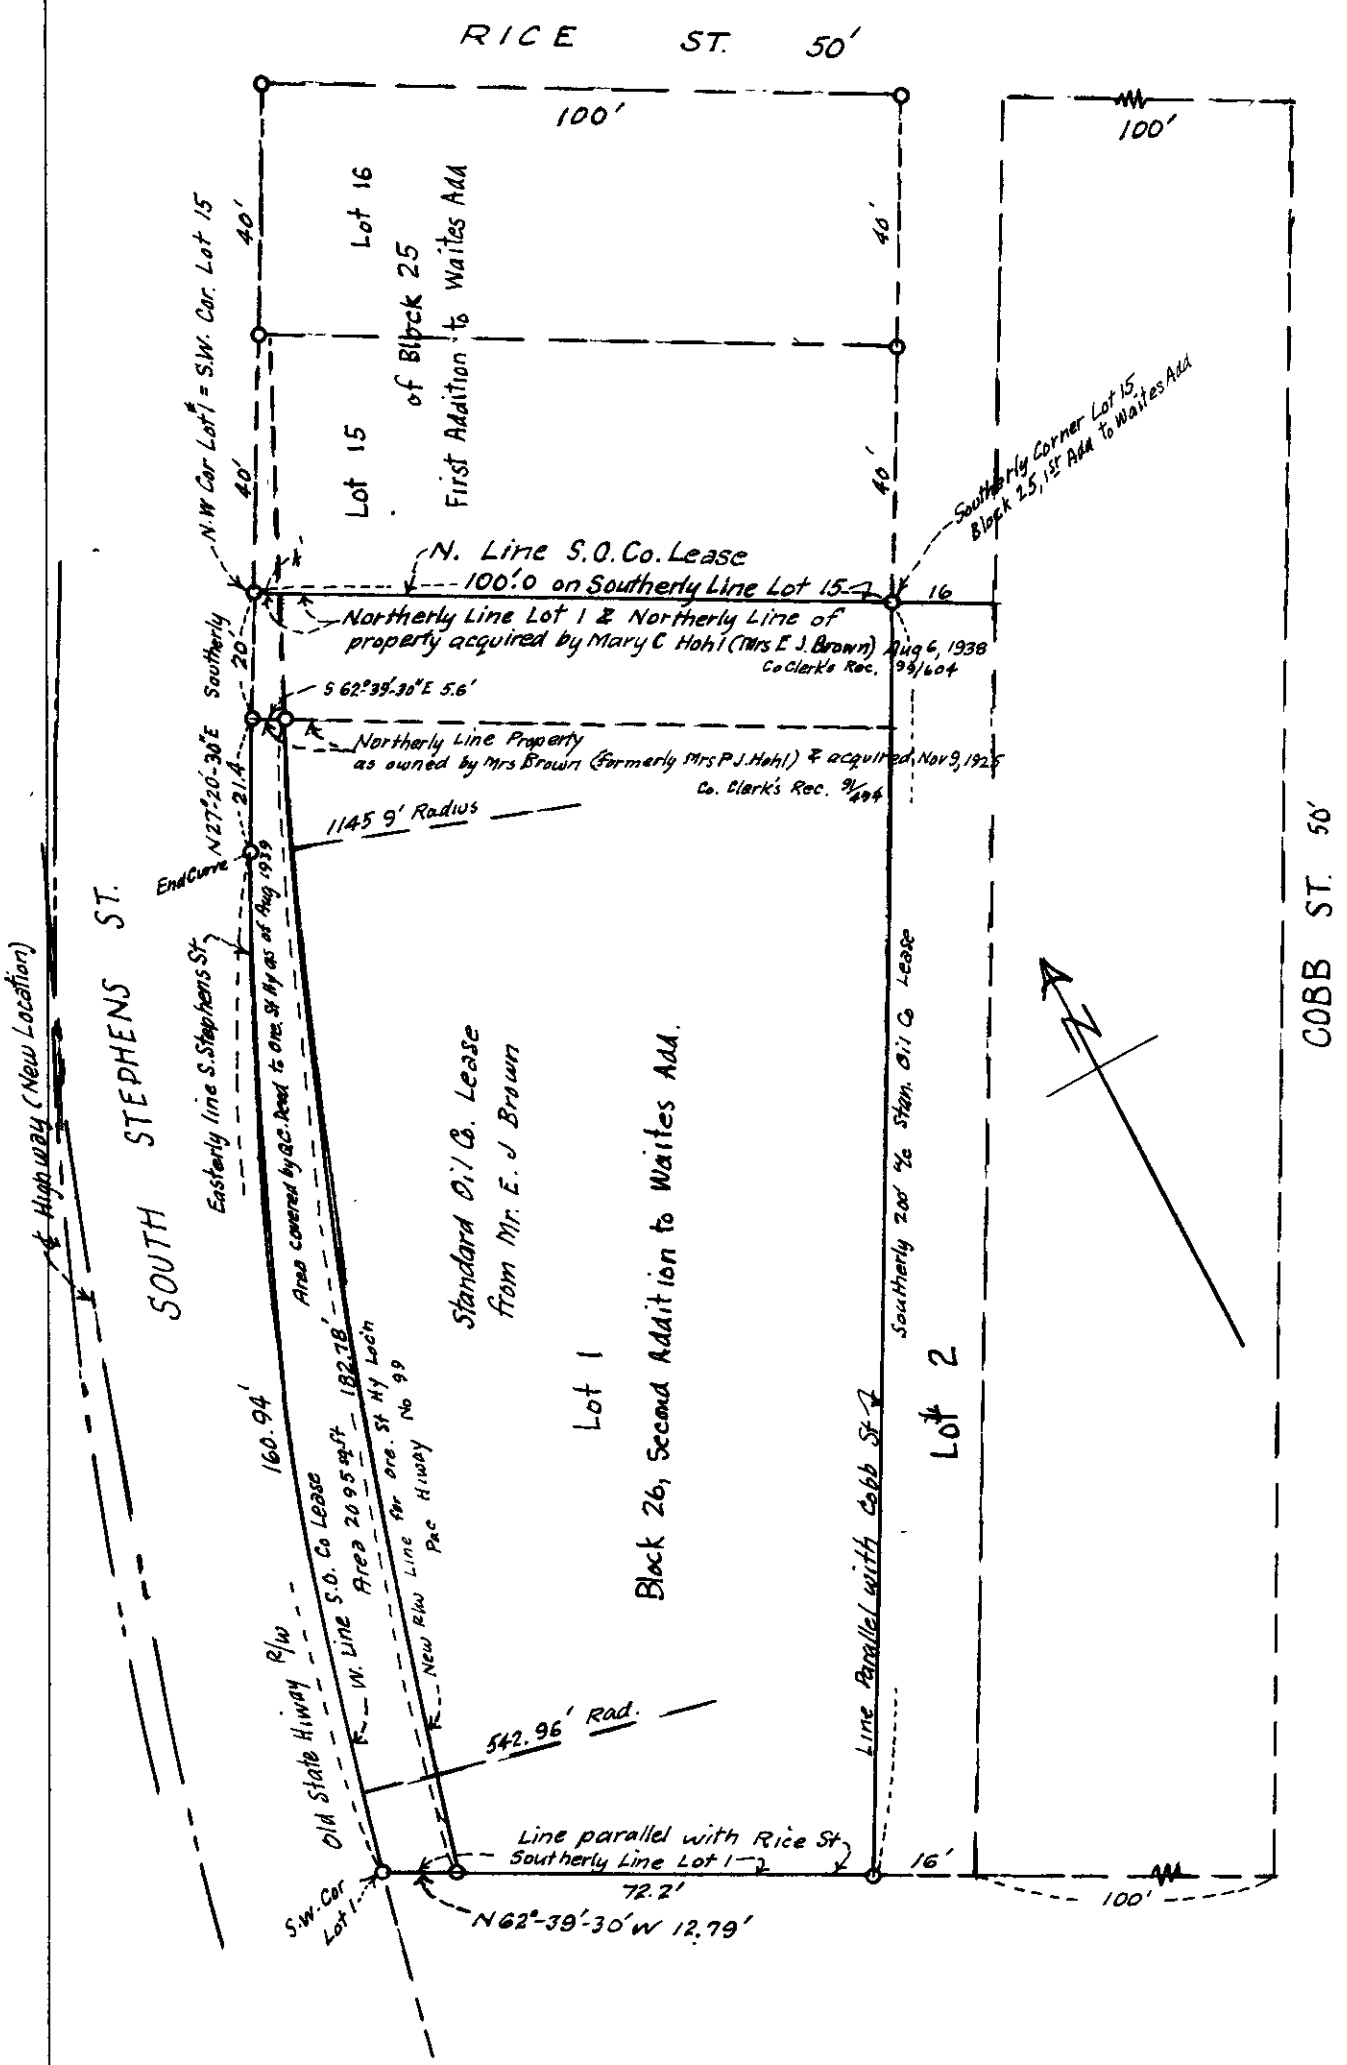
V16 E40