85

COUNTY SURVEYOR'S RECORD, DOUGLAS COUNTY, OREGON

BUSHONG & CO. PORTLAND, ORE. 87545
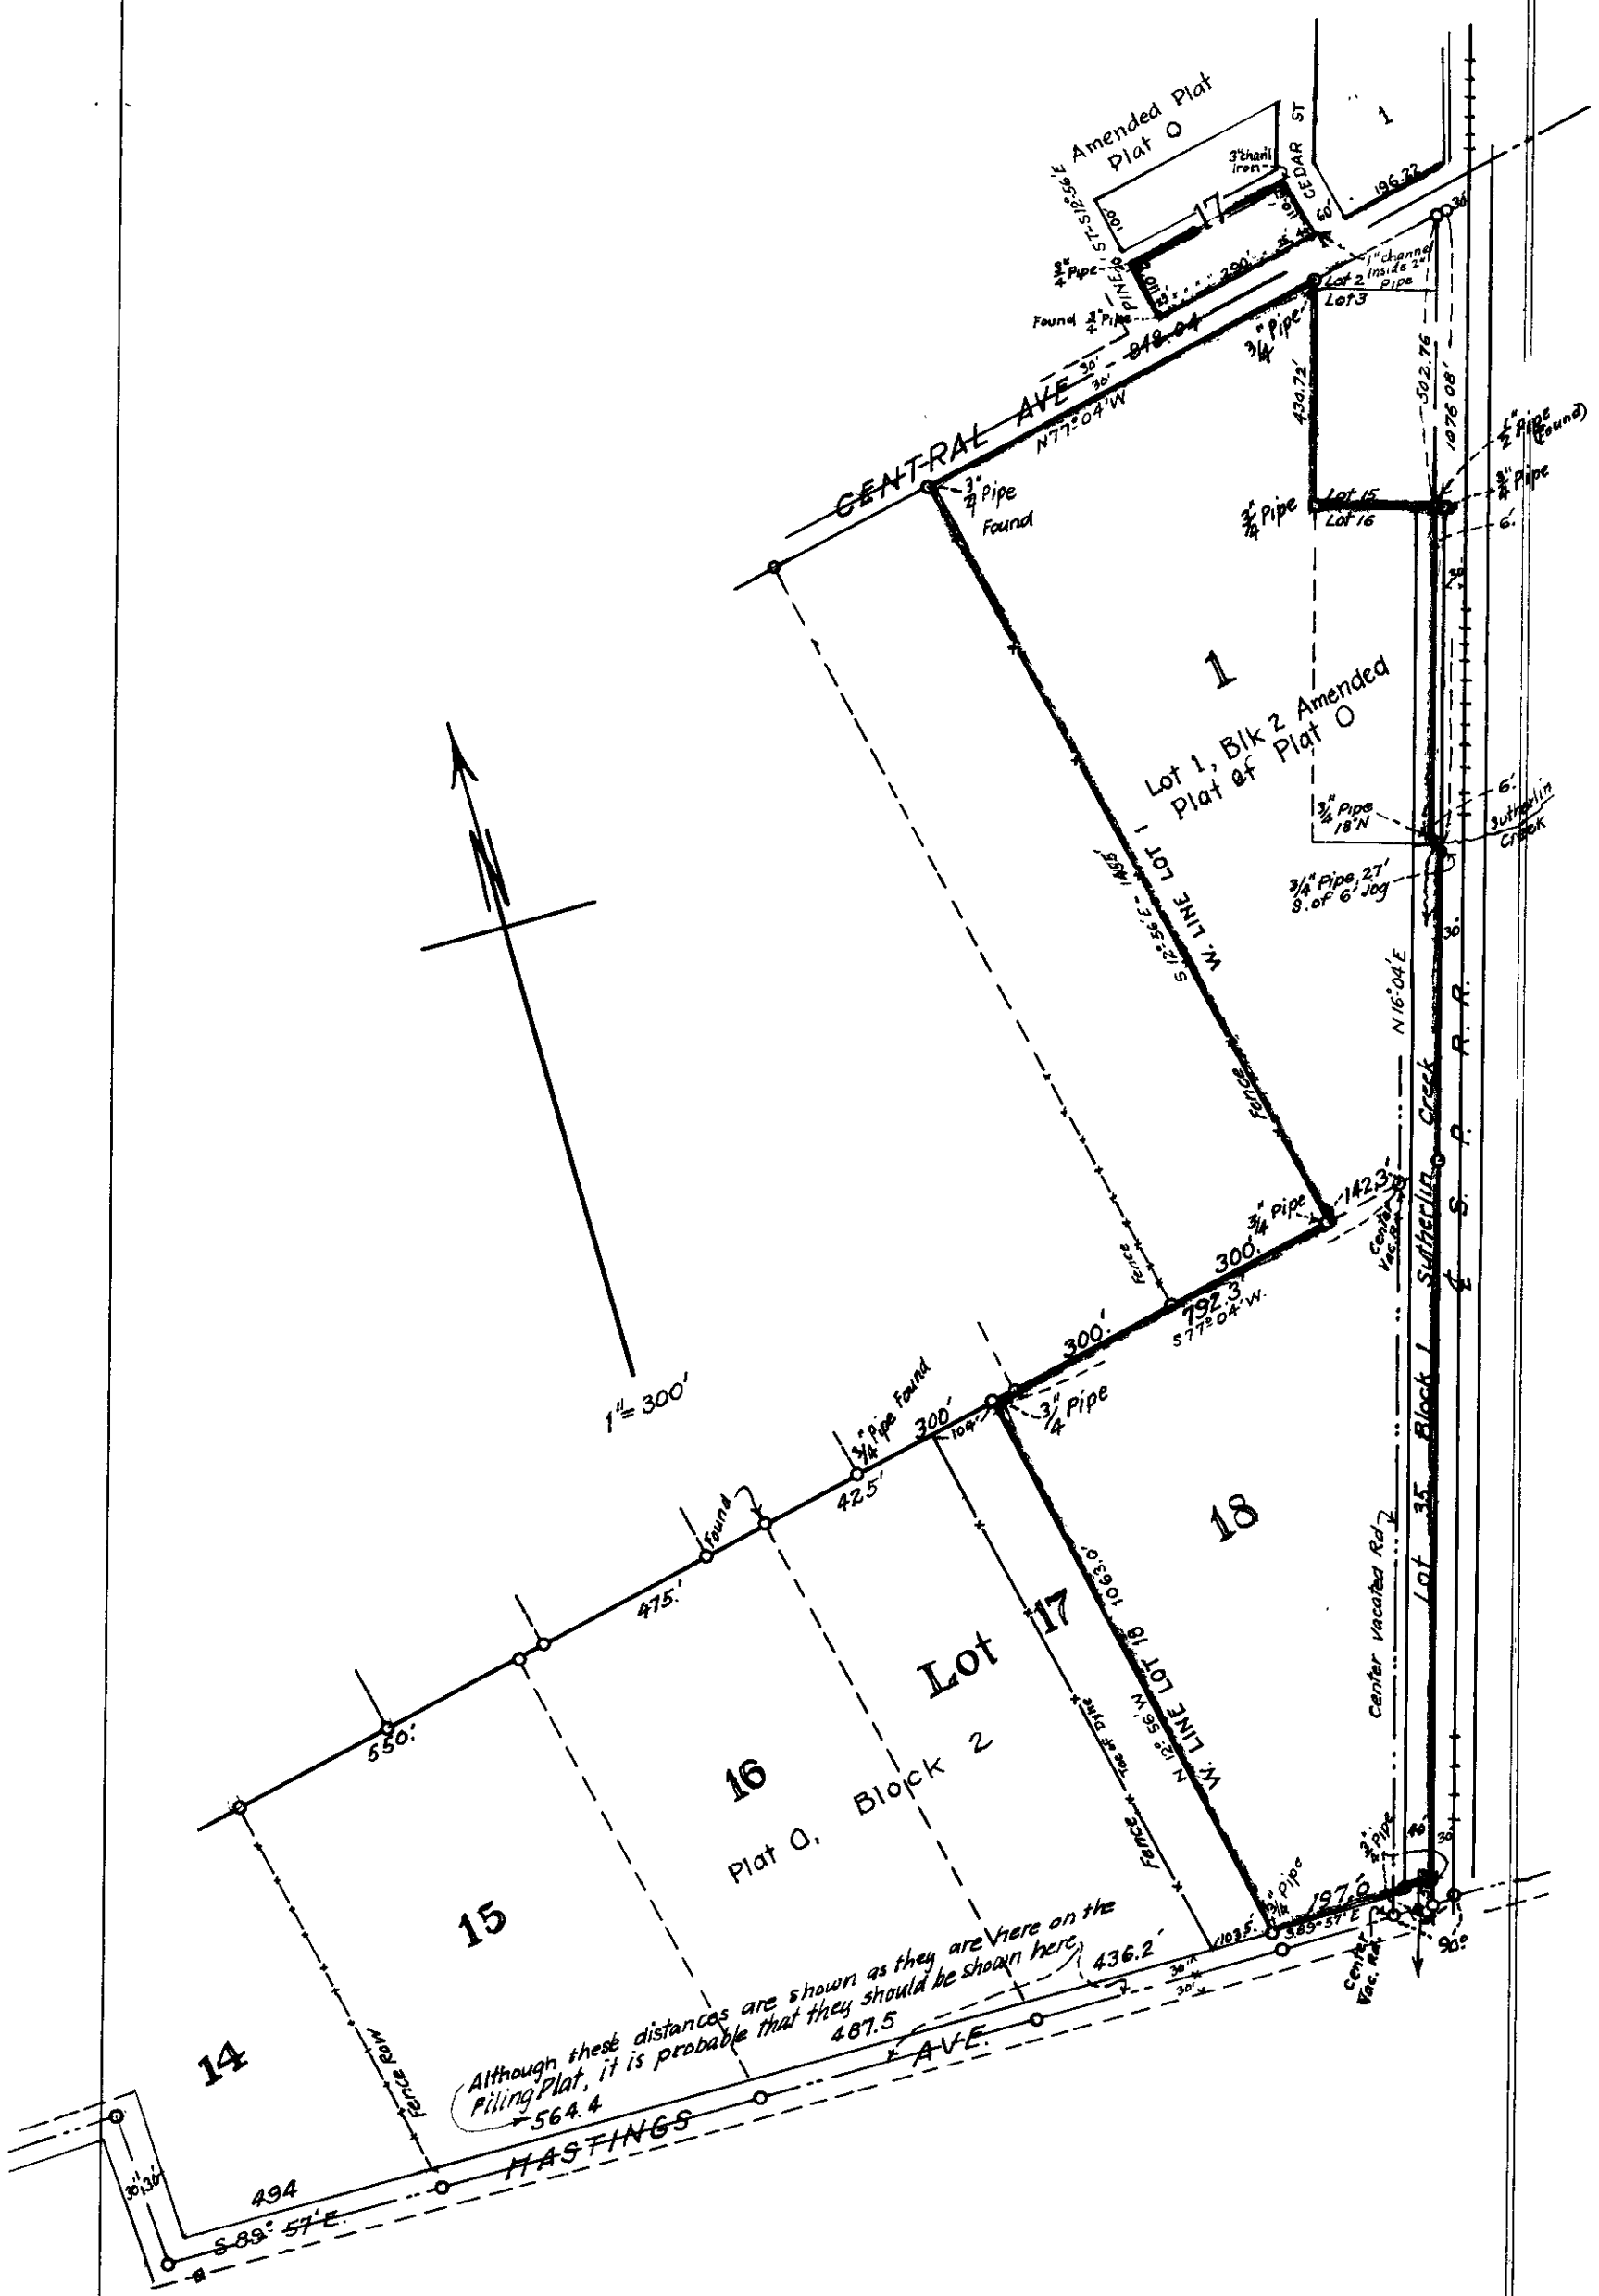
Survey No. Made on Dec 1941 & Jan. 1942	Survey No. Made on
In Town. 25 S Range 5 W Sec.	In Town. Range Sec.
Made for Springfield Plywood,	Made for
Purpose of locating property acquired from Shaw-Wiseman Co of Sutherlin, Ore	Purpose of
Boyer