(89)

COUNTY SURVEYOR'S RECORD, DOUGLAS COUNTY, OREGON

BUSHONG & CO. PORTLAND, ORE. 87545
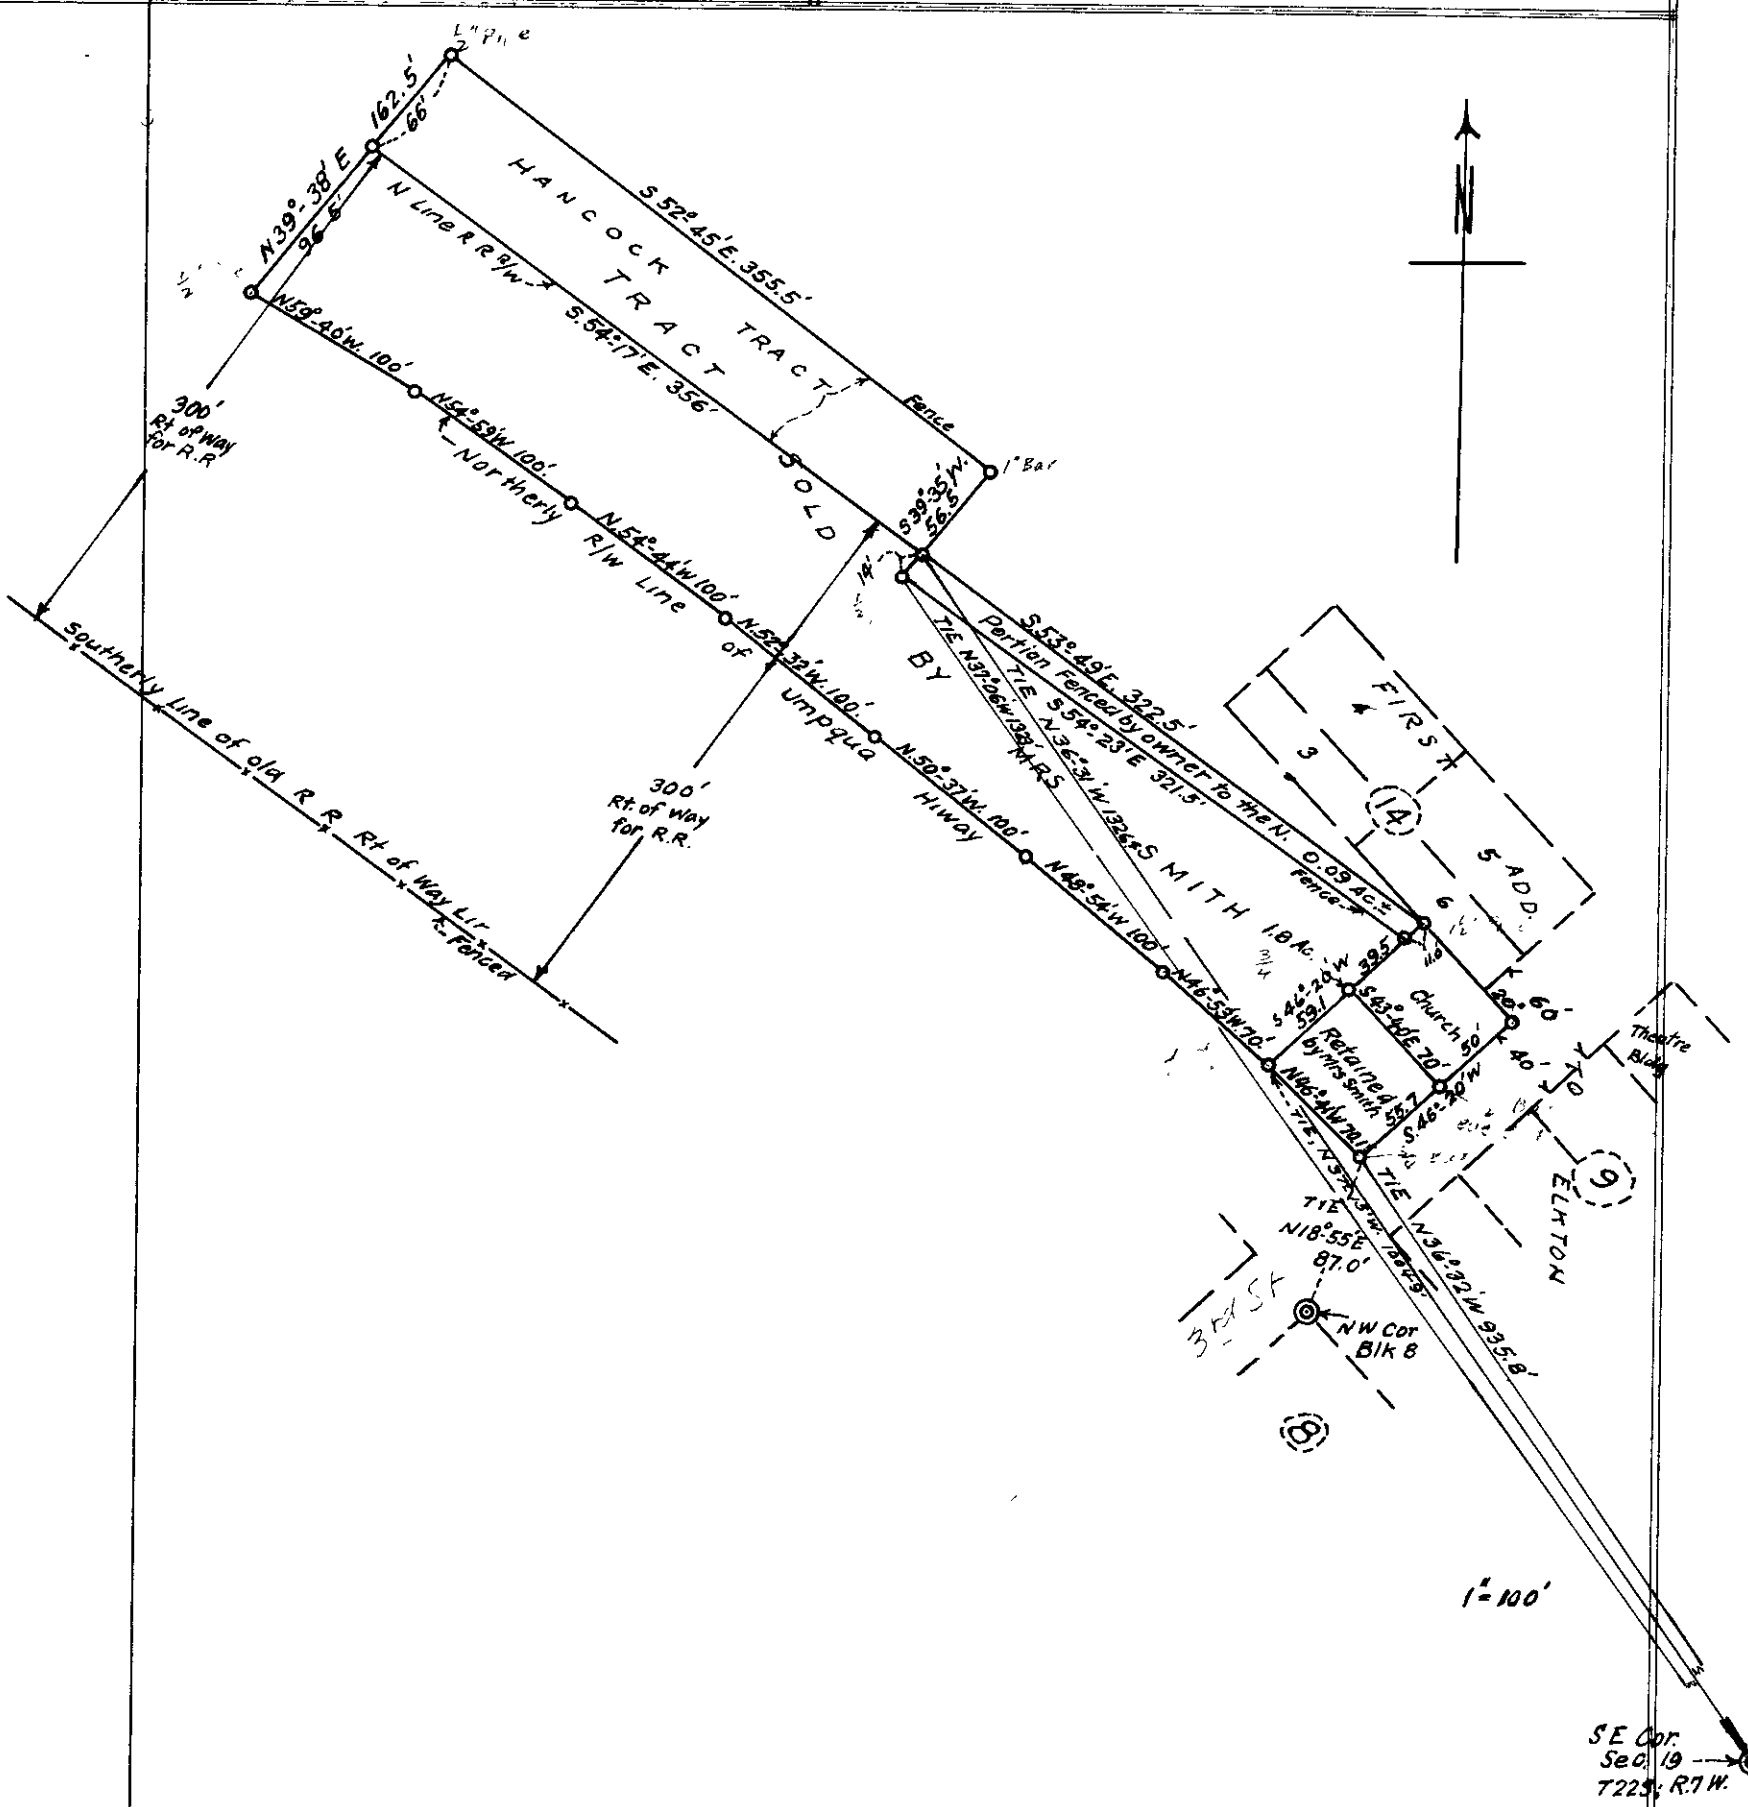
Survey No. Made on Mar. 1942	Survey No. Made on
In Town. 22 S. Range 7 W. Sec. 19 On N Westerly side Elkton	In Town. Range Sec.
Made for Mrs Clara Smith	Made for
Purpose of For Deed Desc's & to locate fenced Smith property	Purpose of
A Boyer C. S. File No. 36/15