COUNTY SURVEYOR'S RECORD, DOUGLAS COUNTY, OREGON

BUSHONG & CO. PORTLAND, ORE. 87545

Survey No. - Made on Feb 24, 25, 26, 1943

In Town. 29 S Range 9 W Sec. 36

Made for Bert Wells & Ore St. Hy Dept.

Purpose of - shown below

For Bert Wells and
Ore State Hiway Dept
(Mr Lytle)
V36 E39 by Arthur Bager

Survey No. Made on Feb. 1943

In Town. 27 S. Range 4 W. Sec. 20

Made for Mr Chrisler-
Mr Rose, Walter Leake, Mr Chrisler

Purpose of to retrace survey previously made for sale of portion of Lindbloom Ranch to Chrisler. Lindbloom (Gus) questions location of East end of tract sold by him to Chrisler as shown here in red because it goes thru portion of his barn.

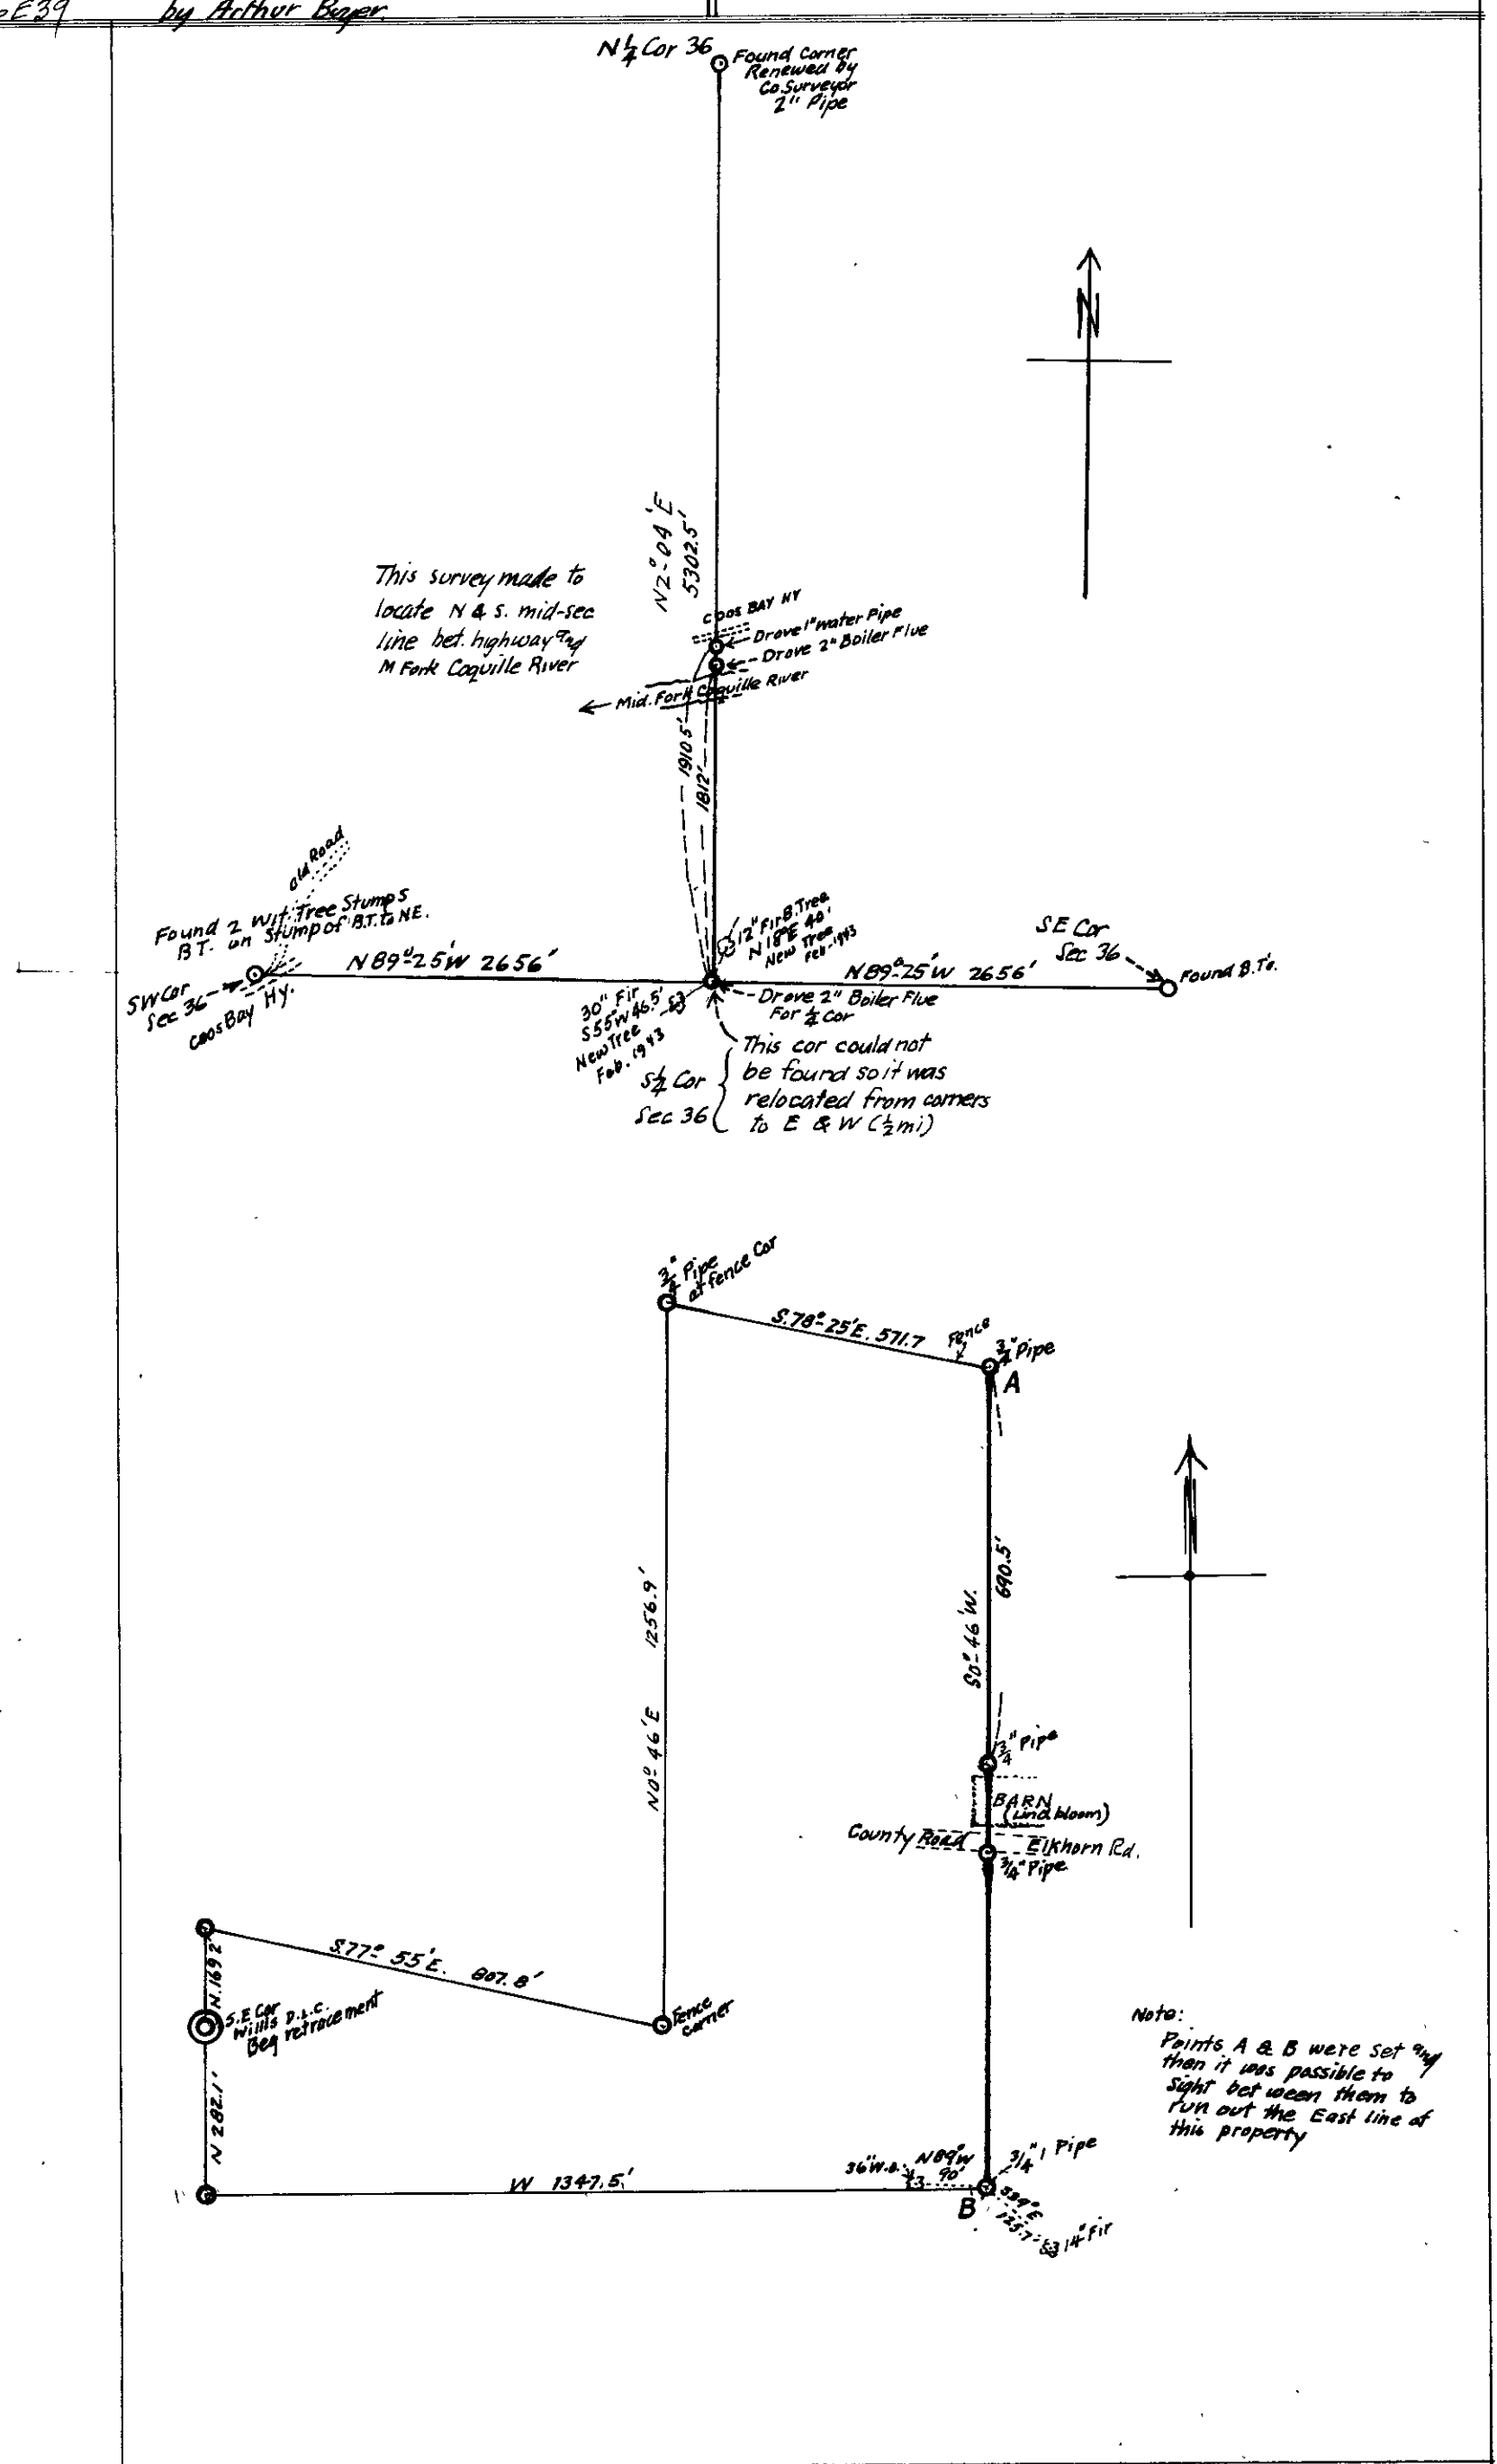

Note:
Points A & B were set and then it was possible to sight between them to run out the East line of this property