(99)

# COUNTY SURVEYOR'S RECORD, DOUGLAS COUNTY, OREGON

BUSHONG & CO. PORTLAND, ORE. 87545
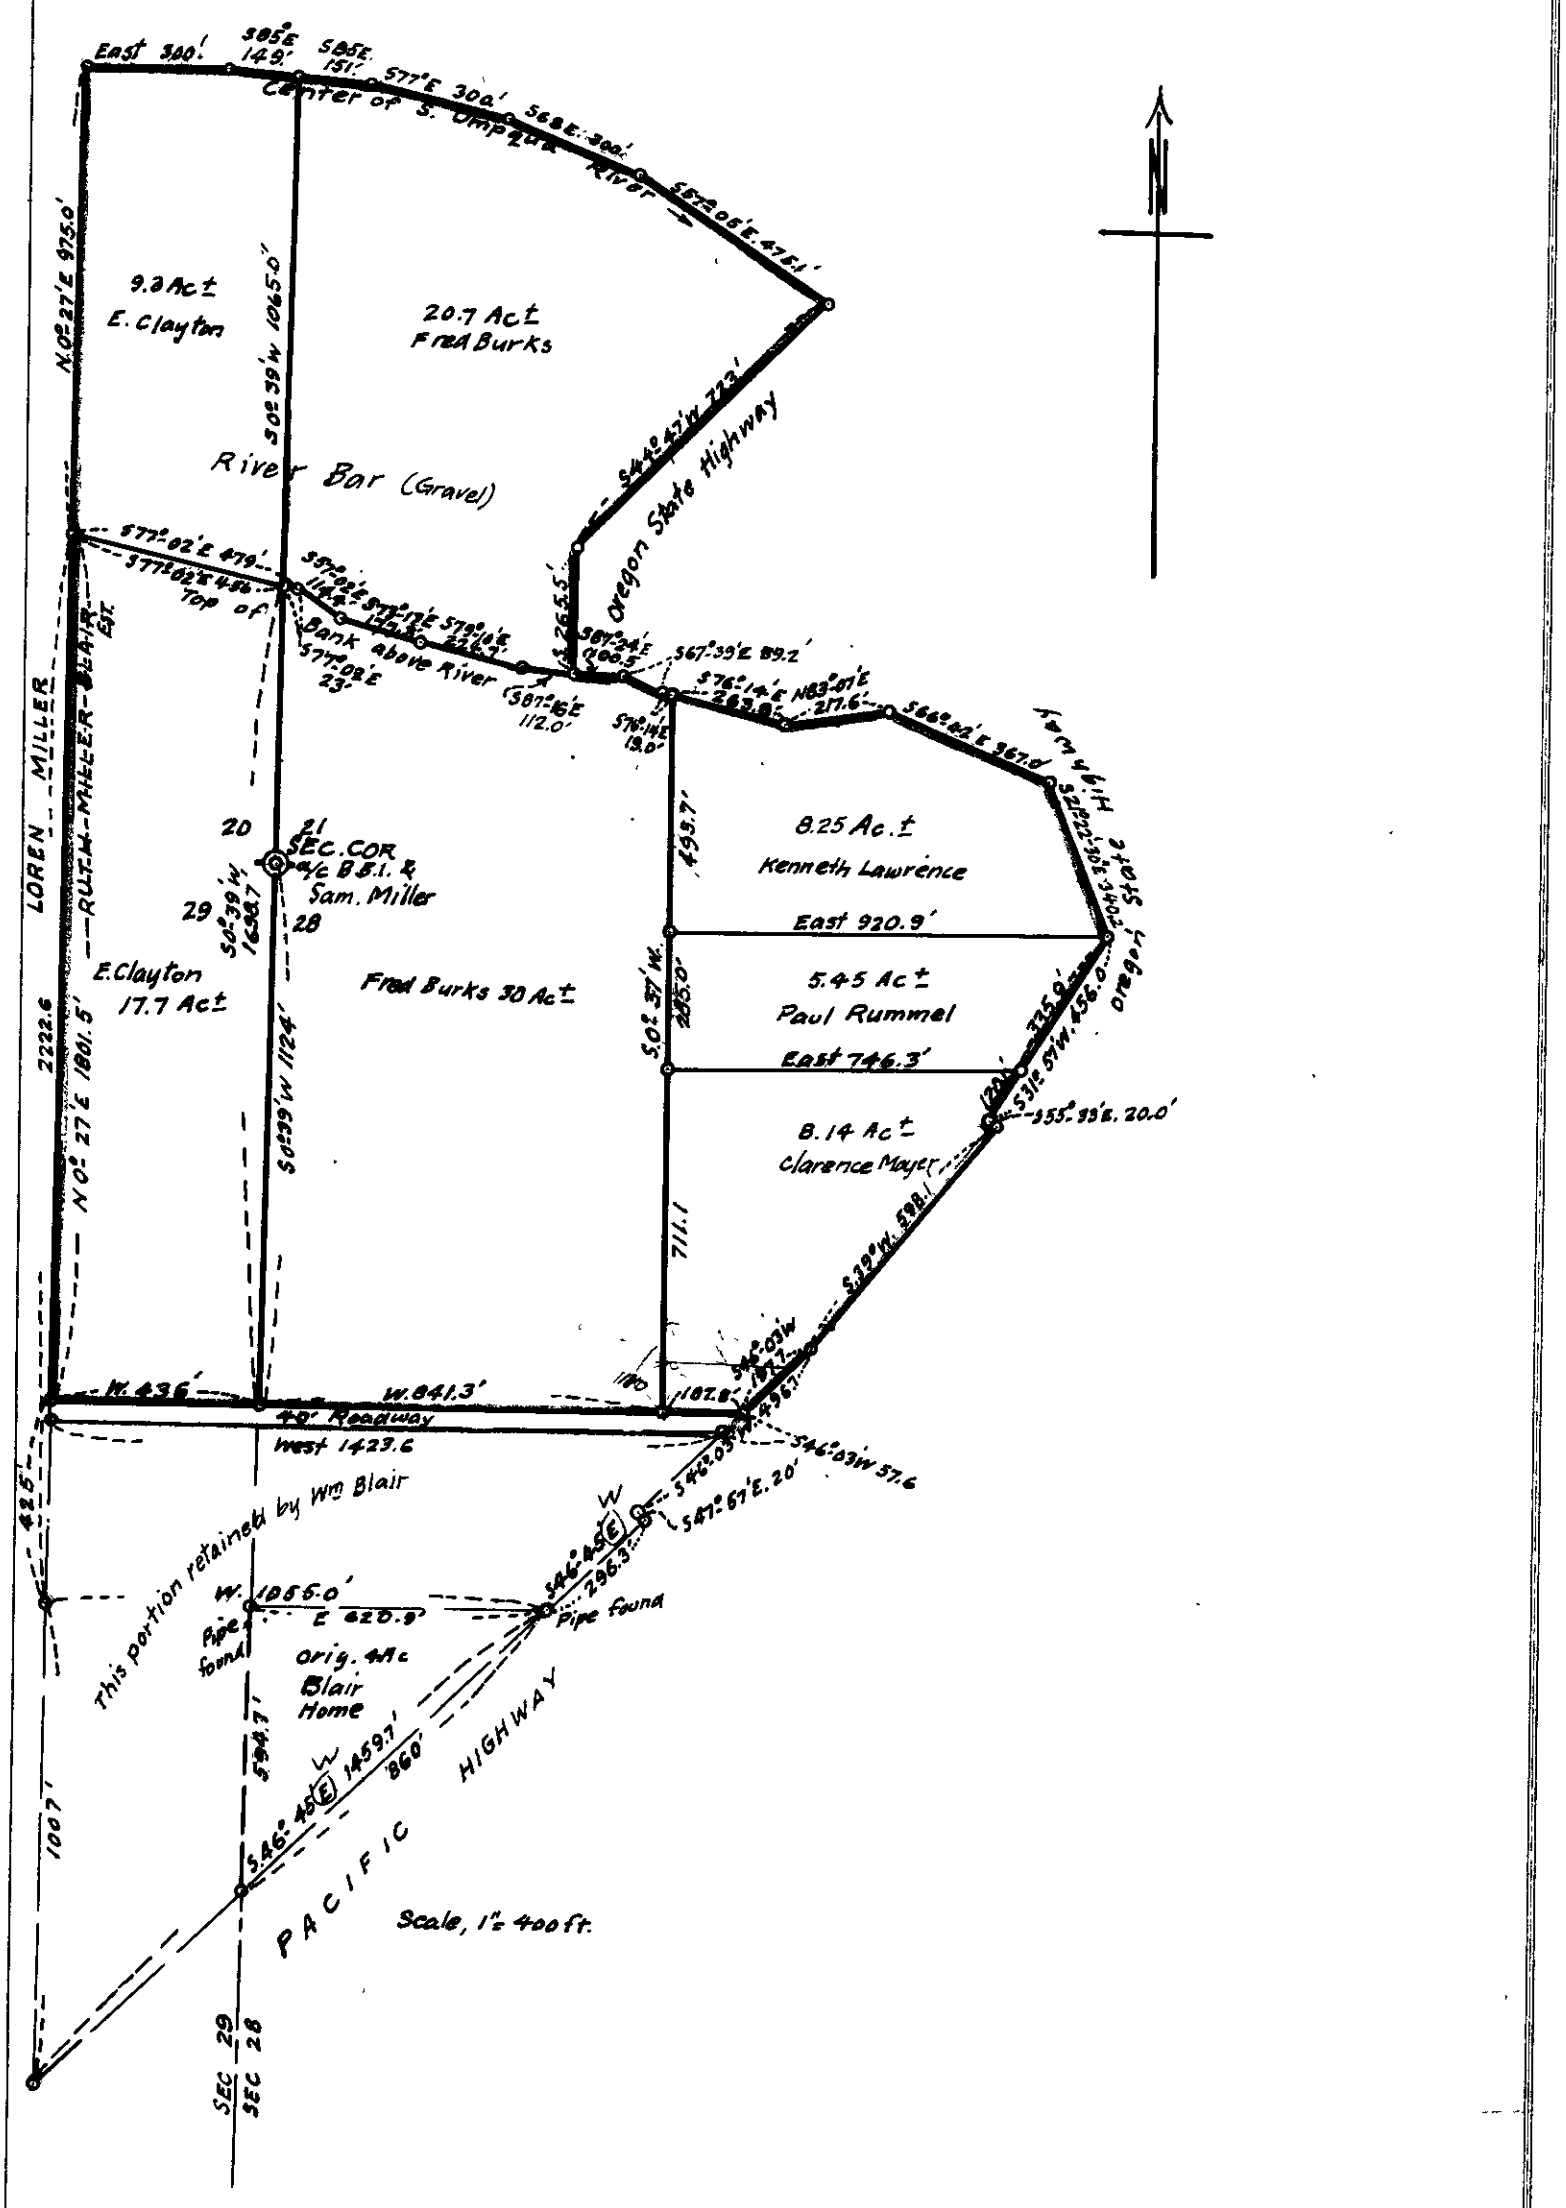
| | |
|---|---|
| Survey No. Made on | Survey No. Made on |
| In Town. 28 S. Range 6 W. Sec. 20, 21, 28, 29 | In Town. Range Sec. |
| Made for Ruth Miller Blair Estate | Made for |
| Purpose of, for subdivision for sale of this portion of Sam Miller Estate by metes and bounds descriptions. | Purpose of |
| A Boyer - Geo Piper during Nov. Dec Jan 1942 1943 VJG EPS | |