COUNTY SURVEYOR'S RECORD, DOUGLAS COUNTY, OREGON

BUSHONG & CO. PORTLAND, ORE. 87545
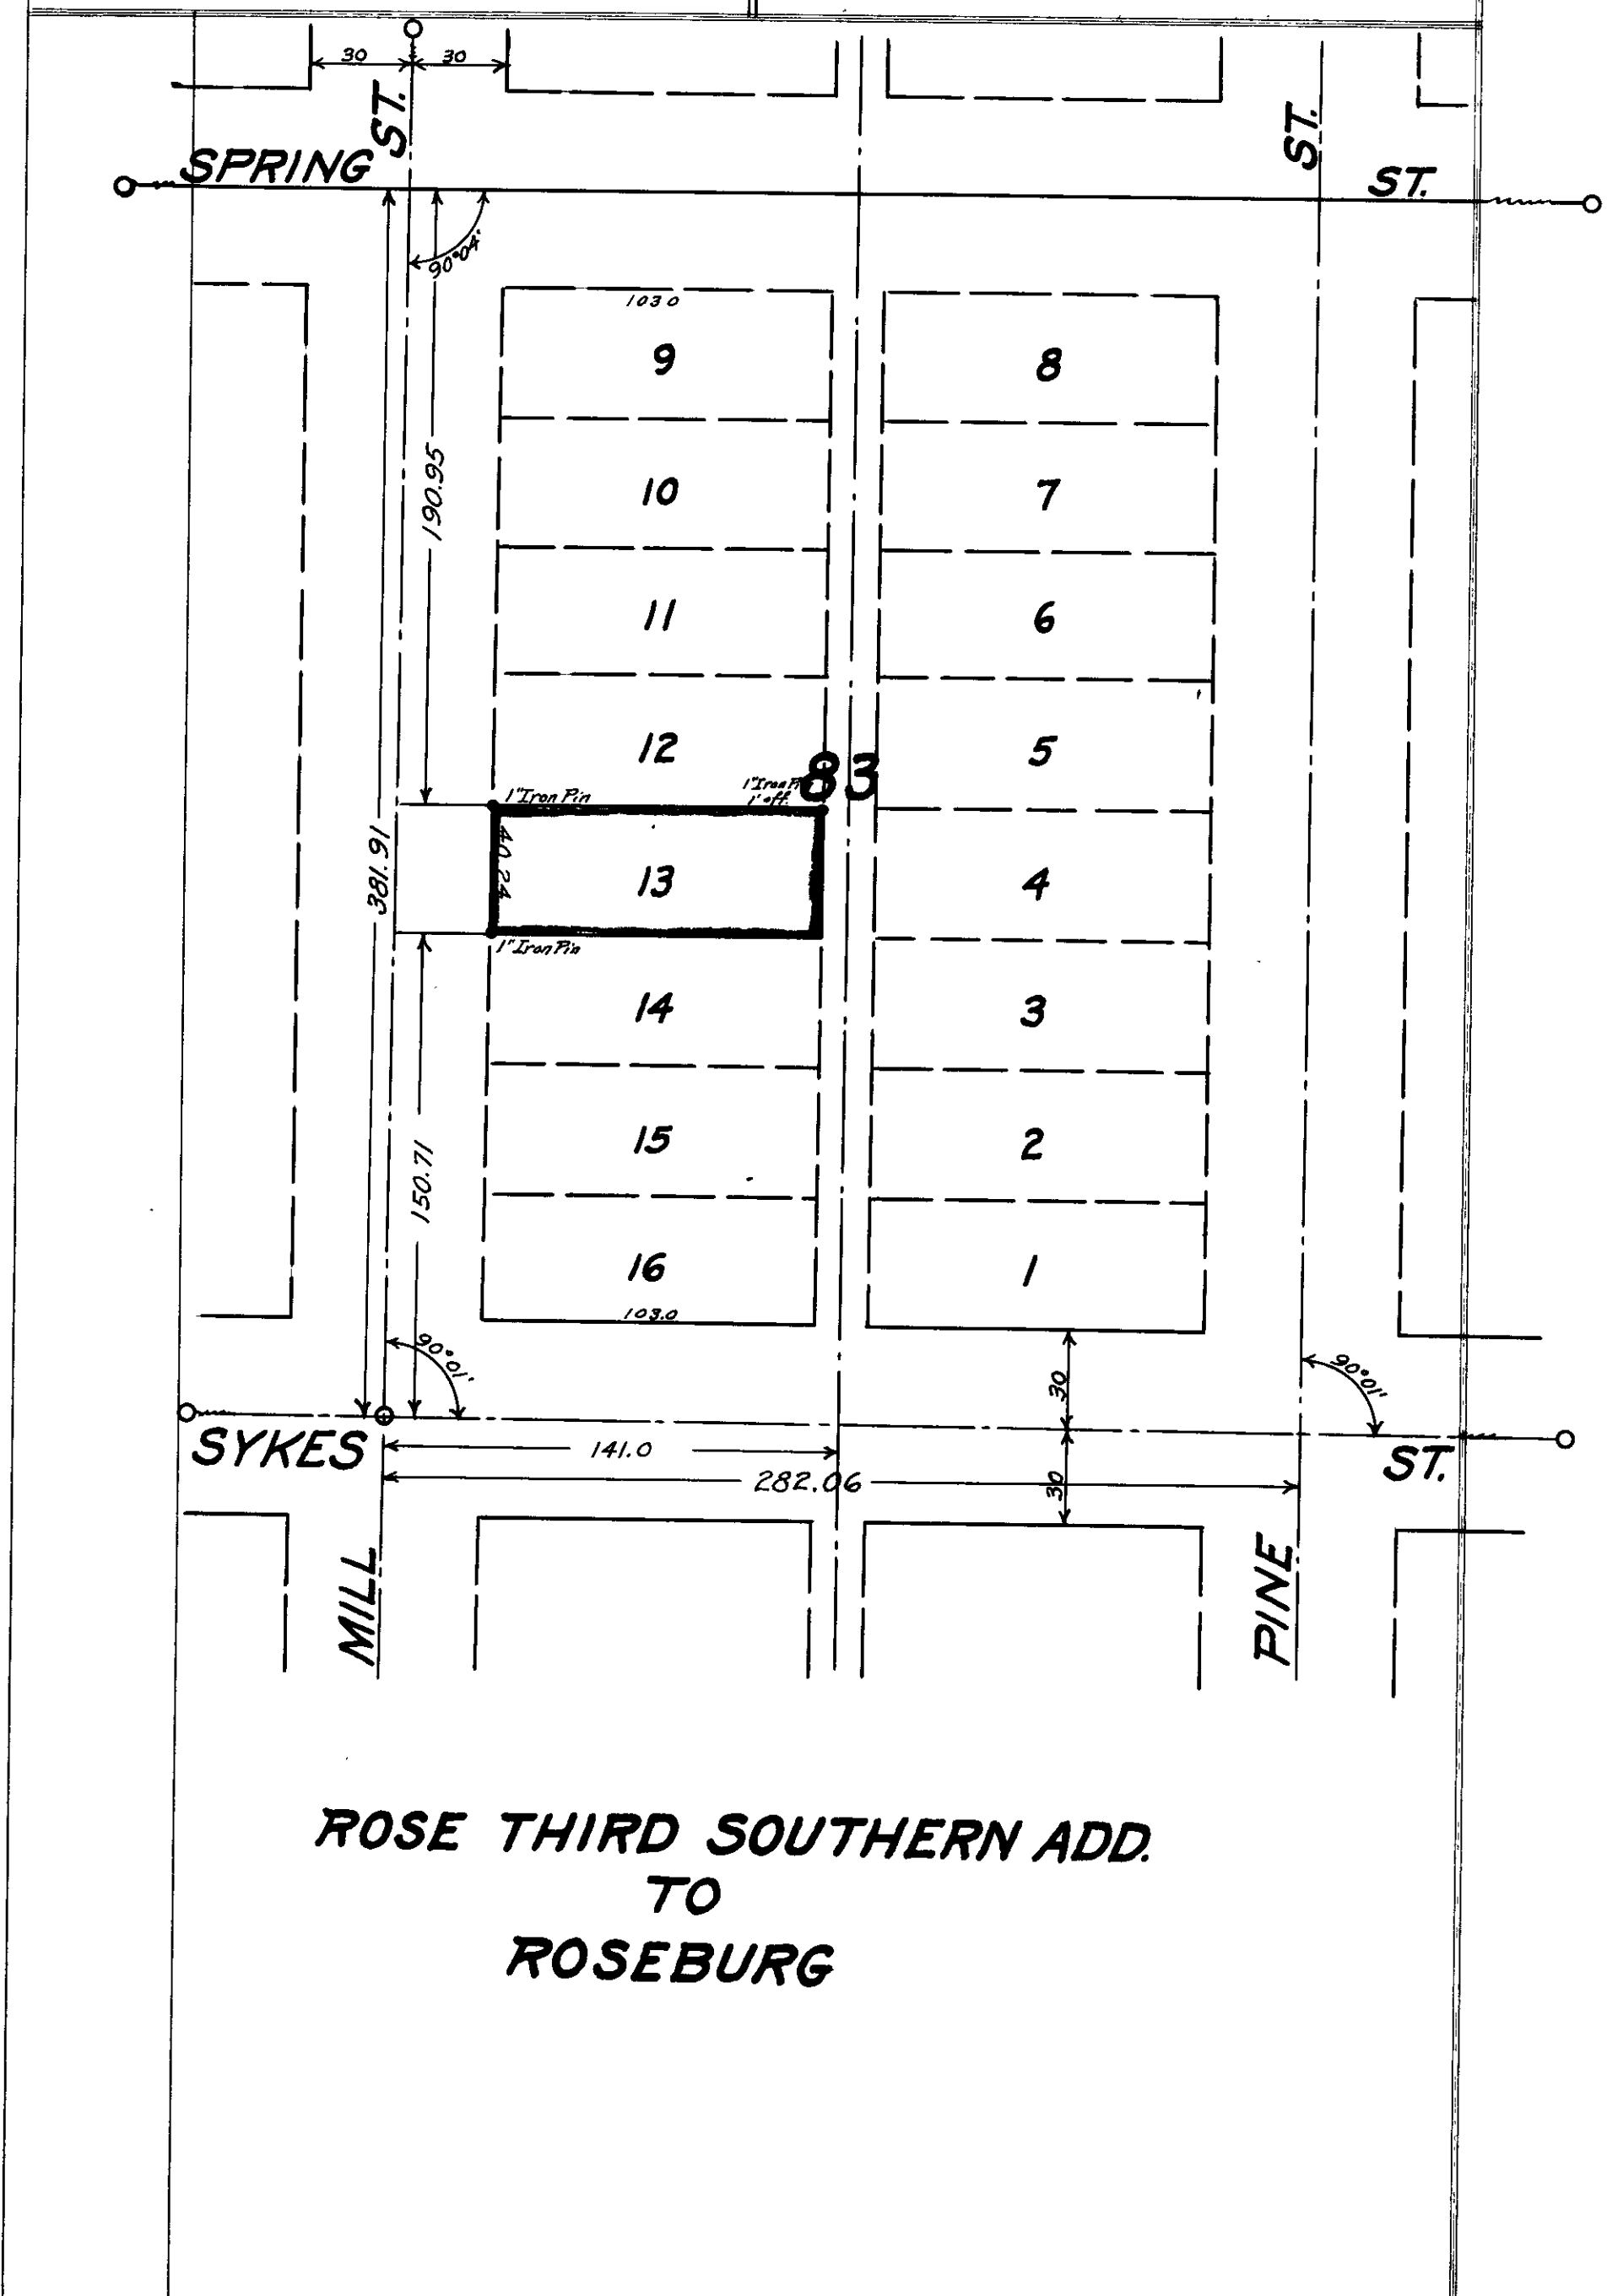
Survey No. 45-2 *Made on* January 11, 1945	*Survey No.* *Made on*
In Town. 27S. *Range* 6W. *Sec.* Roseburg	*In Town.* *Range* *Sec.*
Made for Mrs. Thomas Webb	*Made for*
Purpose of Survey of Lot 13, Blk. 83 Roses Third Southern Addition	*Purpose of*
Survey by Ben B. Irving, County Surveyor File Drawer 38, Envelope 2