COUNTY SURVEYOR'S RECORD, DOUGLAS COUNTY, OREGON

BUSHONG & CO. PORTLAND, ORE. 87545

Survey No. 45-17 Made on June 8-9, 1945	Survey No. Made on
In Town. 25S. Range 5W. Sec. Sutherlin	In Town. Range Sec.
Made for L. R. Welsh	Made for
Purpose of Survey of Lots 6 to 14 Blk. 9 Plat "O" Sutherlin	Purpose of
Drawer 38 Env. 15	

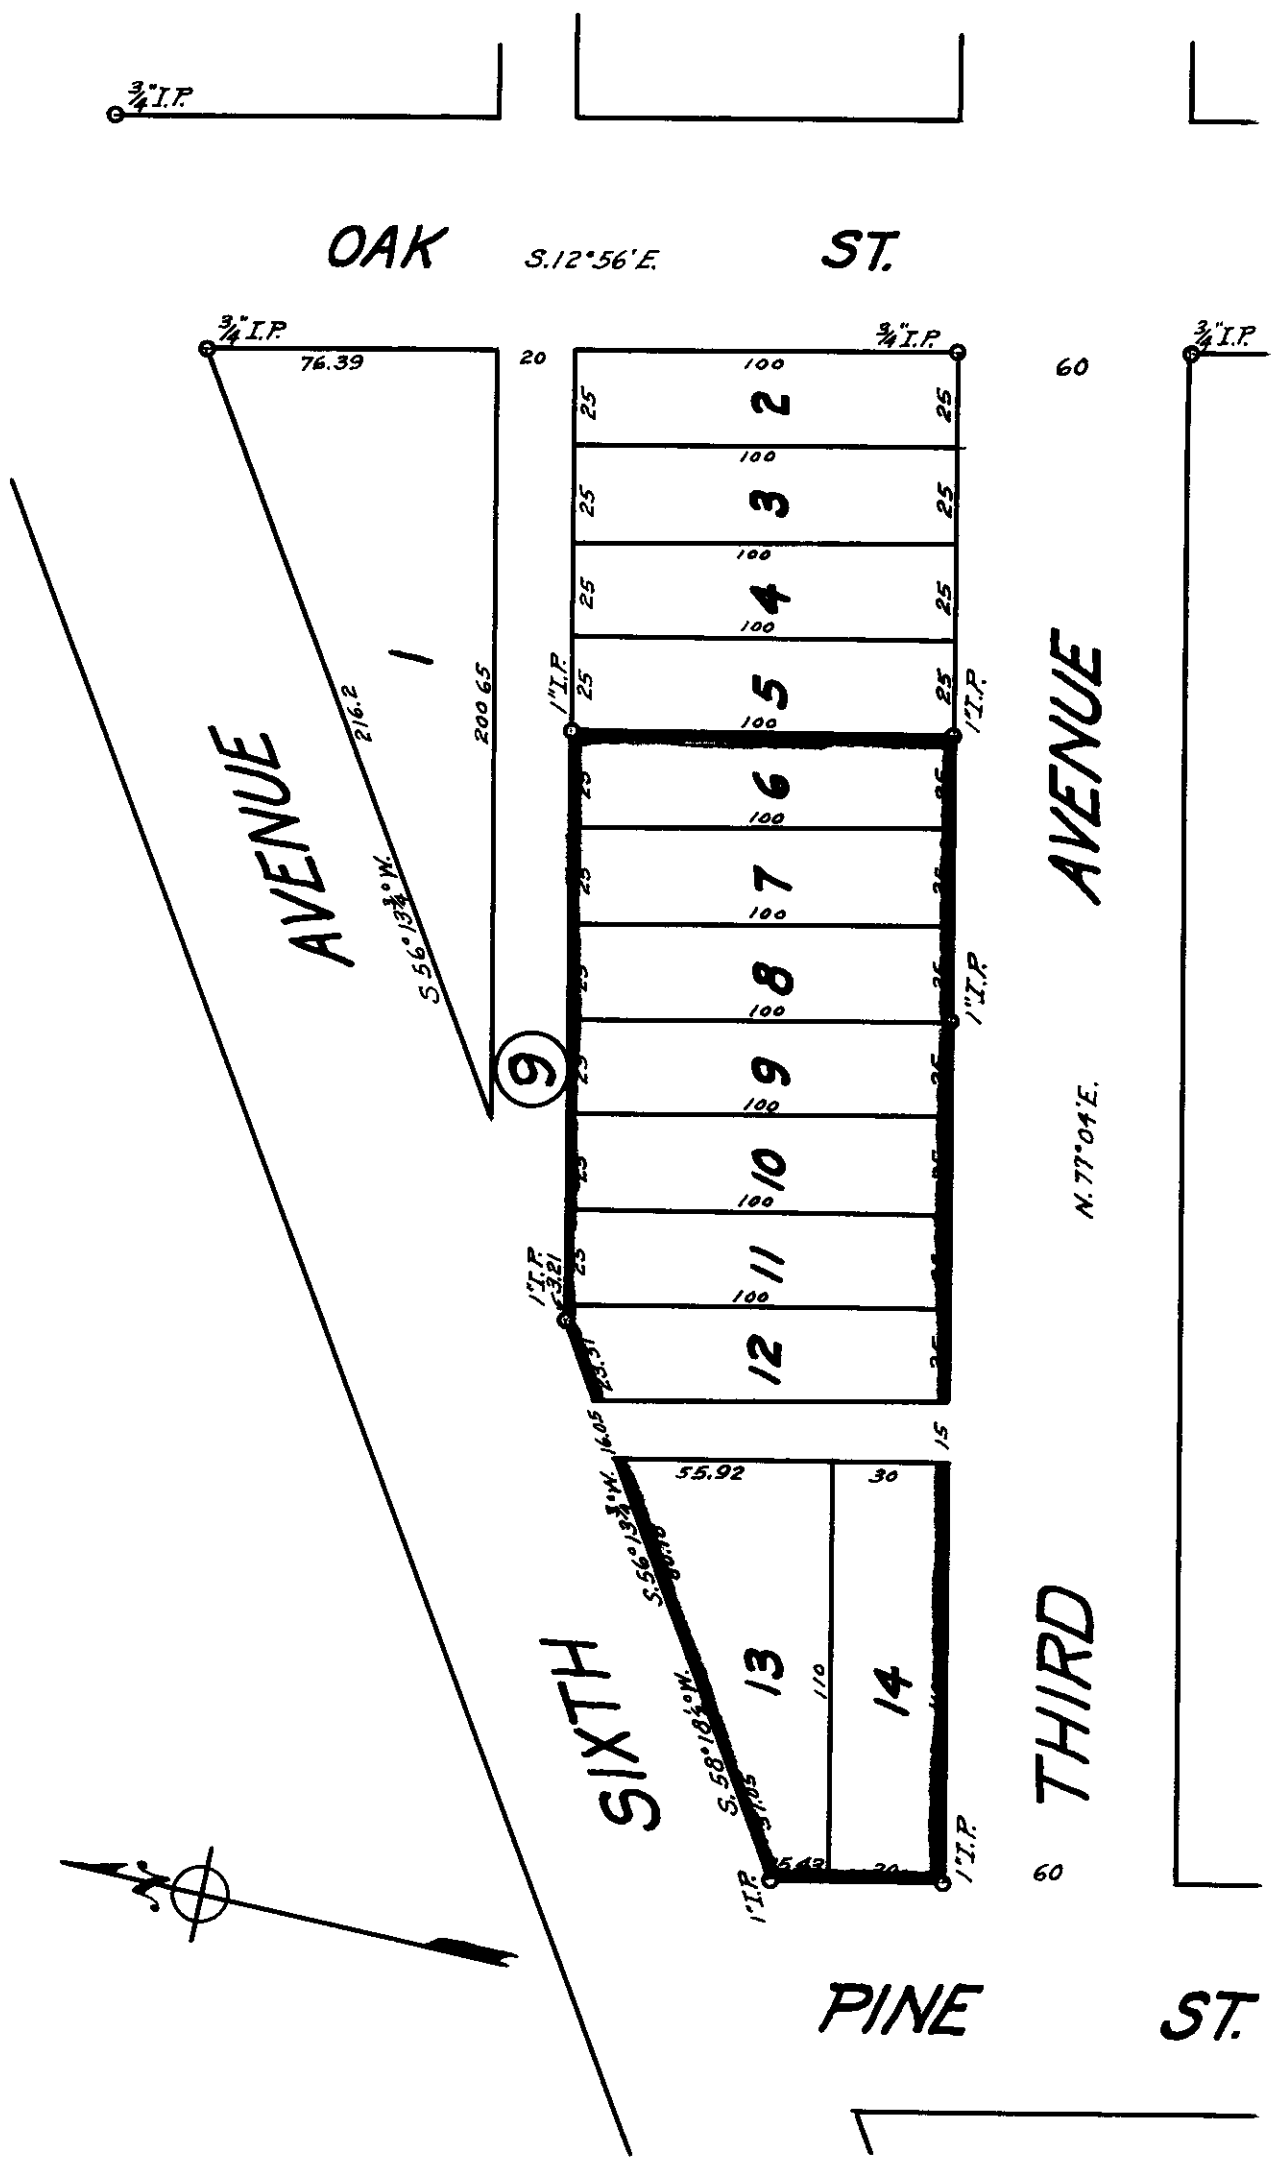

REGISTERED
OREGON
LAND SURVEYOR

Geo. J. Wenderoth

MARCH 10, 1944
George J Wenderoth
5