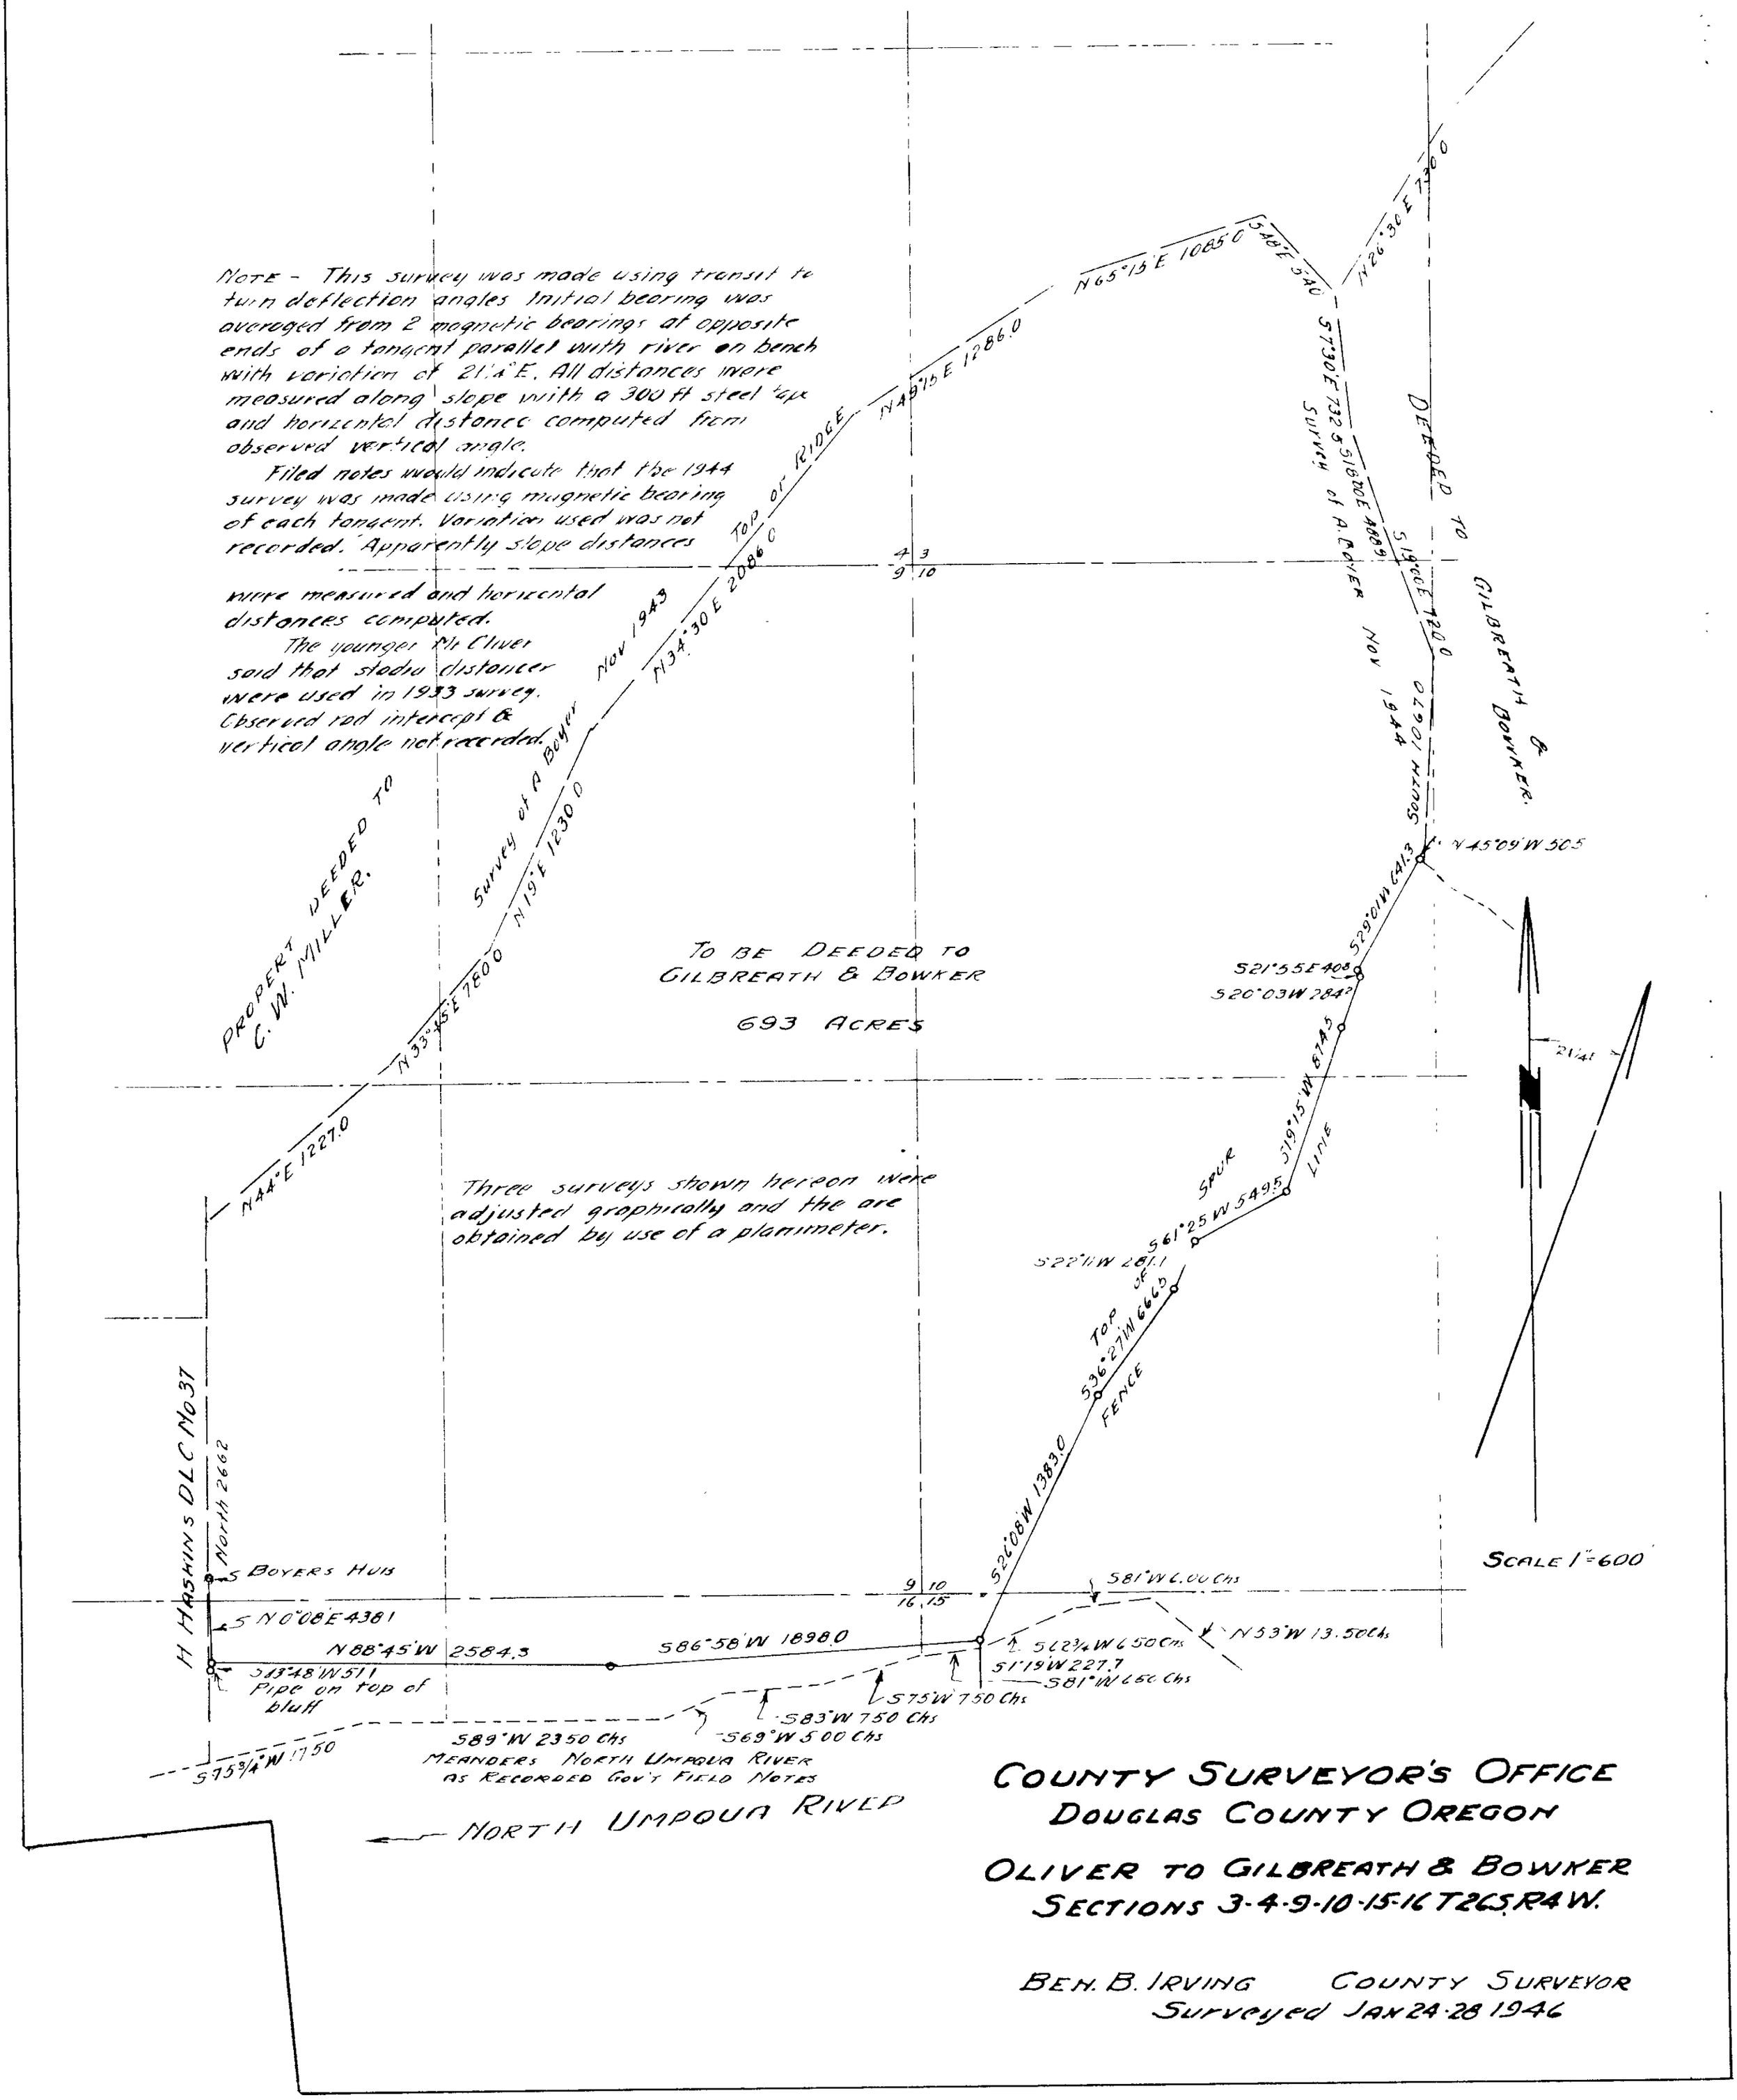


# County Surveyor's Office
## Douglas County Oregon

## Oliver to Gilbreath & Bowker
## Sections 3-4-9-10-15-16 T26S R4W.

Ben. B. Irving County Surveyor
Surveyed Jan 24-28 1946