COUNTY SURVEYORS FILE DATA
DO NOT REMOVE FROM OFFICE

LAND PARTITION AND BOUNDARY LINE ADJUSTMENT SURVEY LOCATED IN THE N.E. 1/4 OF SECTION 18, T. 25 S., R 5 W., W.M., DOUGLAS COUNTY, OREGON

FILED #
OCT 13 1992 JP
COUNTY SURVEYOR
DOUGLAS COUNTY, ORE.

FOR· FLOYD & MAGGIE DAVIS
P.O. BOX 776
OAKLAND, OR. 97462

PARTITIONER· FLOYD & MAGGIE DAVIS
P.O. BOX 776
OAKLAND, OR. 97462

BY· ROBERT L. DOLAN
3614 NONPARIEL RD.
SUTHERLIN, OR. 97479

LEGAL OWNER OF RECORD·
FLOYD & MAGGIE DAVIS
P.O. BOX 776
OAKLAND, OR. 97462

DATE· AUGUST 1992

SCALE· 1" = 200'

SEWER· SEPTIC SYSTEM

WATER SUPPLY· WELLS

NUMBER OF LOTS· 2

ZONING· RR

COMP. PLAN· RC

P.D. FILE NO. 92-084

WATER RIGHTS· NONE

PAC· CALAPOOYA

Legend·
- ○ FD. 5/8" IRON ROD OR AS NOTED
- ● SET 5/8" x 30" IRON ROD W/CAP (L.S. 1076)
- ◎ FD. BRASS CAP DC.S.O. 1960 SEC. COR. 7/8 18/17 T.25 S., R.5 W.
- □ WELLS W/10'x10' AREA OF LAND FOR PUMP HOUSE

NARRATIVE·
LAND PARTITION AND BOUNDARY LINE ADJUSTMENT IN THE NE 1/4 OF SECTION 18, T. 25 S., R.5 W., W.M., DOUGLAS COUNTY, OREGON.

LEGAL DESCRIPTION·
PARCEL 2 OF M.L.P. 1992-0015

INSTRUMENTS·
THEODOLITE & DISTANCE METER

SURVEYOR'S CERTIFICATE·
I, ROBERT L. DOLAN, BEING DULY SWORN HEREBY DEPOSE AND SAY THAT I HAVE CORRECTLY SURVEYED A PORTITION OF THE LAND AS SHOWN HEREON AND HAVE MARKED SAID LAND WITH PROPER MONUMENTS.

Robert L. Dolan
ROBERT L. DOLAN

DECLARATION·
I, FLOYD AND MAGGIE DAVIS ARE THE OWNERS OF THE LAND REPRESENTED HEREON AND MORE PARTICULARLY DESCRIBED HEREIN AND HAVE CAUSED THE SAME TO BE SURVEYED INTO PARCELS AS SHOW HEREON.

Floyd A. Davis
FLOYD DAVIS

SWORN TO ME AND SIGNED BEFORE ME THIS 22 DAY OF September, 1992.

Nelda J. Foster
NOTARY PUBLIC

Maggie Davis
MAGGIE DAVIS

SWORN TO ME AND SIGNED BEFORE ME THIS 22 DAY OF September, 1992.

Nelda J. Foster
NOTARY PUBLIC

OFFICIAL SEAL
NELDA J. FOSTER
NOTARY PUBLIC - OREGON
COMMISSION NO. 011109
MY COMMISSION EXPIRES NOV. 19, 1995

FILED THIS 13th DAY OF OCTOBER, 1992
By: Gloria J. Brown
GAY FIELDS, County Clerk
DOUGLAS COUNTY CLERK

GAY FIELDS, DOUGLAS COUNTY CLERK · STATE OF OREGON

STATE OF OREGON)
COUNTY OF DOUGLAS) SS.
I, GAY FIELDS, COUNTY CLERK AND RECORDER OF CONVEYANCES, DO HEREBY CERTIFY THAT THIS INSTRUMENT WAS RECEIVED
OCT 13 PM 2:23
GAY FIELDS
DOUGLAS COUNTY CLERK
IN THE OFFICIAL RECORDS OF DOUGLAS COUNTY
BY Gloria J. Brown DEPUTY
FEE PP

92-18493

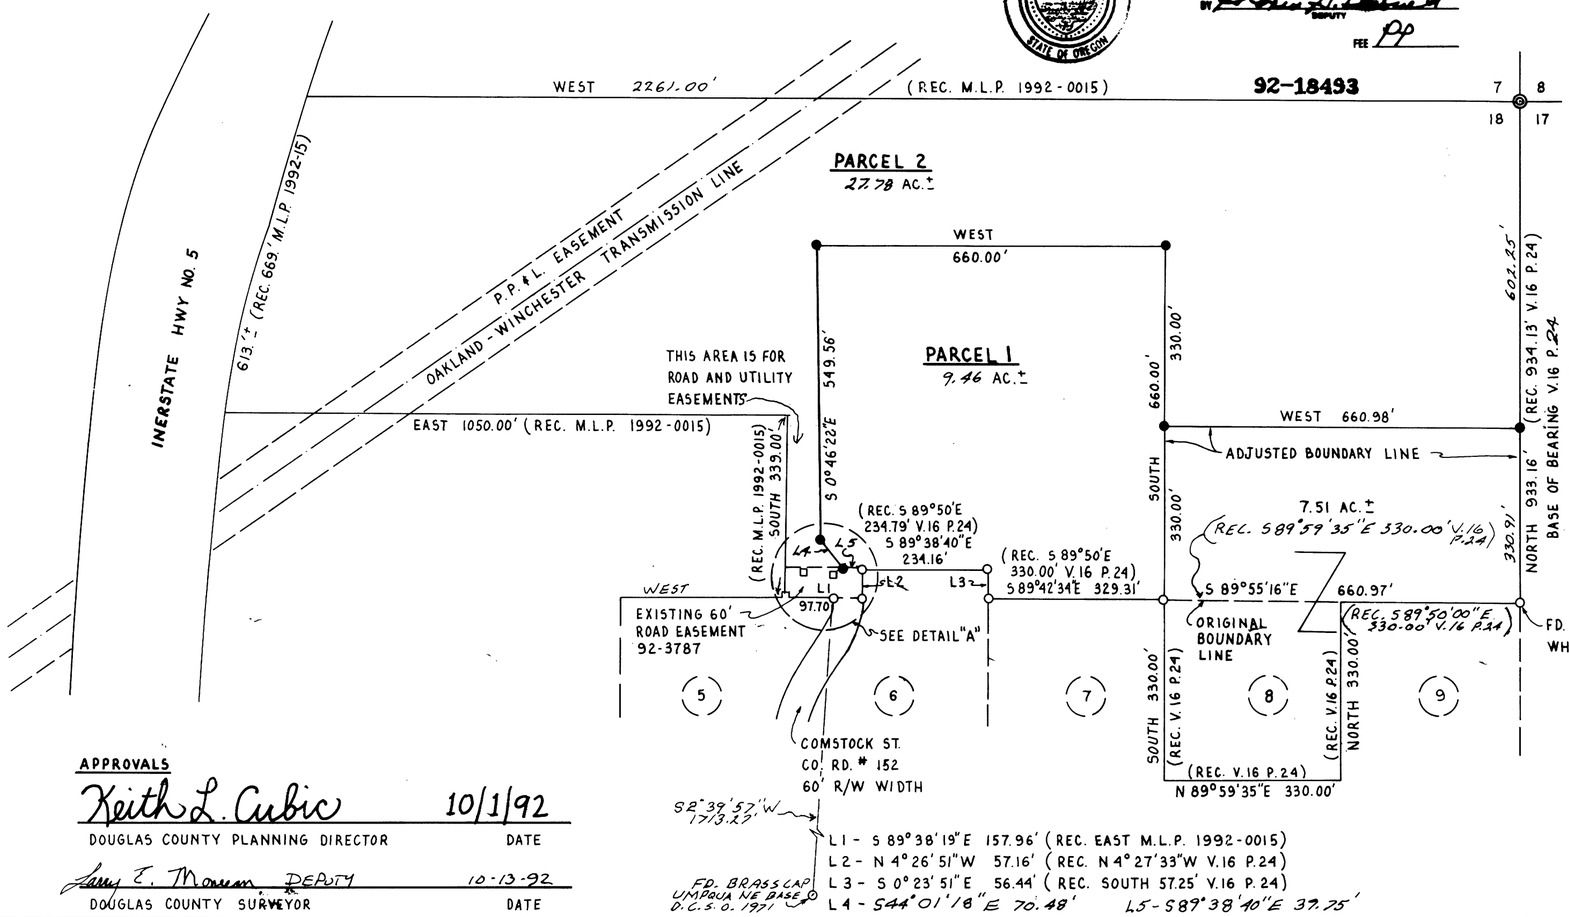

DETAIL "A"
NO SCALE

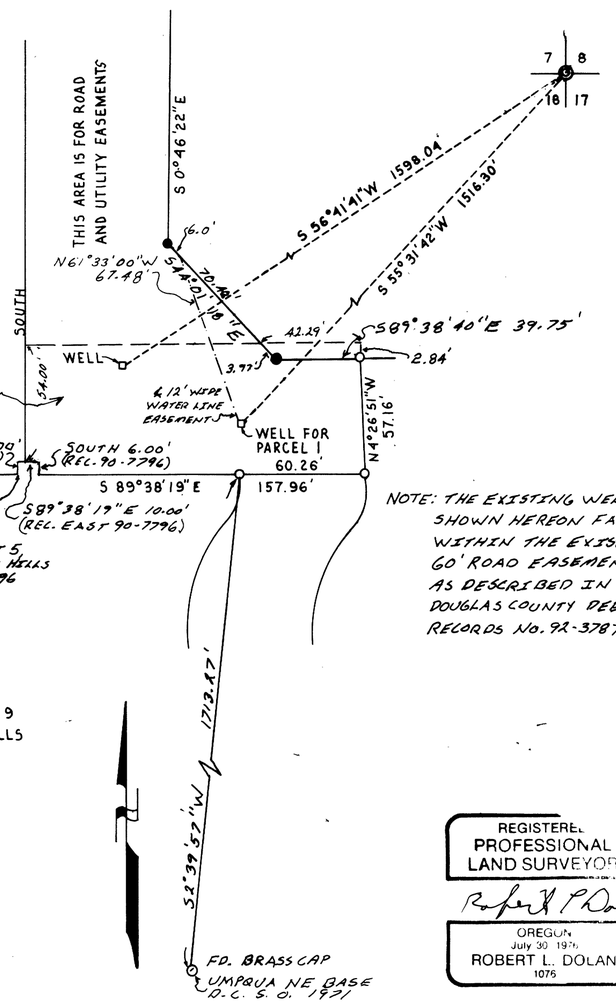

APPROVALS

Keith L. Cubic — 10/1/92
DOUGLAS COUNTY PLANNING DIRECTOR — DATE

Larry E. Monson DEPUTY — 10-13-92
DOUGLAS COUNTY SURVEYOR — DATE

REGISTERED PROFESSIONAL LAND SURVEYOR
Robert L. Dolan
OREGON
July 30 1976
ROBERT L. DOLAN
1076

1992-0068

8900 - 2661