LAND PARTITION

LOCATED in the SW & SE 1/4's of Sec. 1, T. 25 S., R. 6 W., W.M.
in Douglas County, Oregon.

August 23, 1996

COUNTY SURVEYORS FILE DATA
DO NOT REMOVE FROM OFFICE

1996 - 00734

SURVEYED FOR: *E. HOWARD & JEAN E. CHERRY*
3583 GREEN VALLEY ROAD
OAKLAND, OREGON 97462

REGISTERED PROFESSIONAL LAND SURVEYOR
David A. Edwards
OREGON
JULY 26, 1988
DAVID A. EDWARDS
2339
EXPIRES 12/31/97

SURVEYED BY: *DAVID EDWARDS LAND SURVEYING*
P.O. BOX 41
OAKLAND, OREGON 97462
PHONE: (541) 459-0512

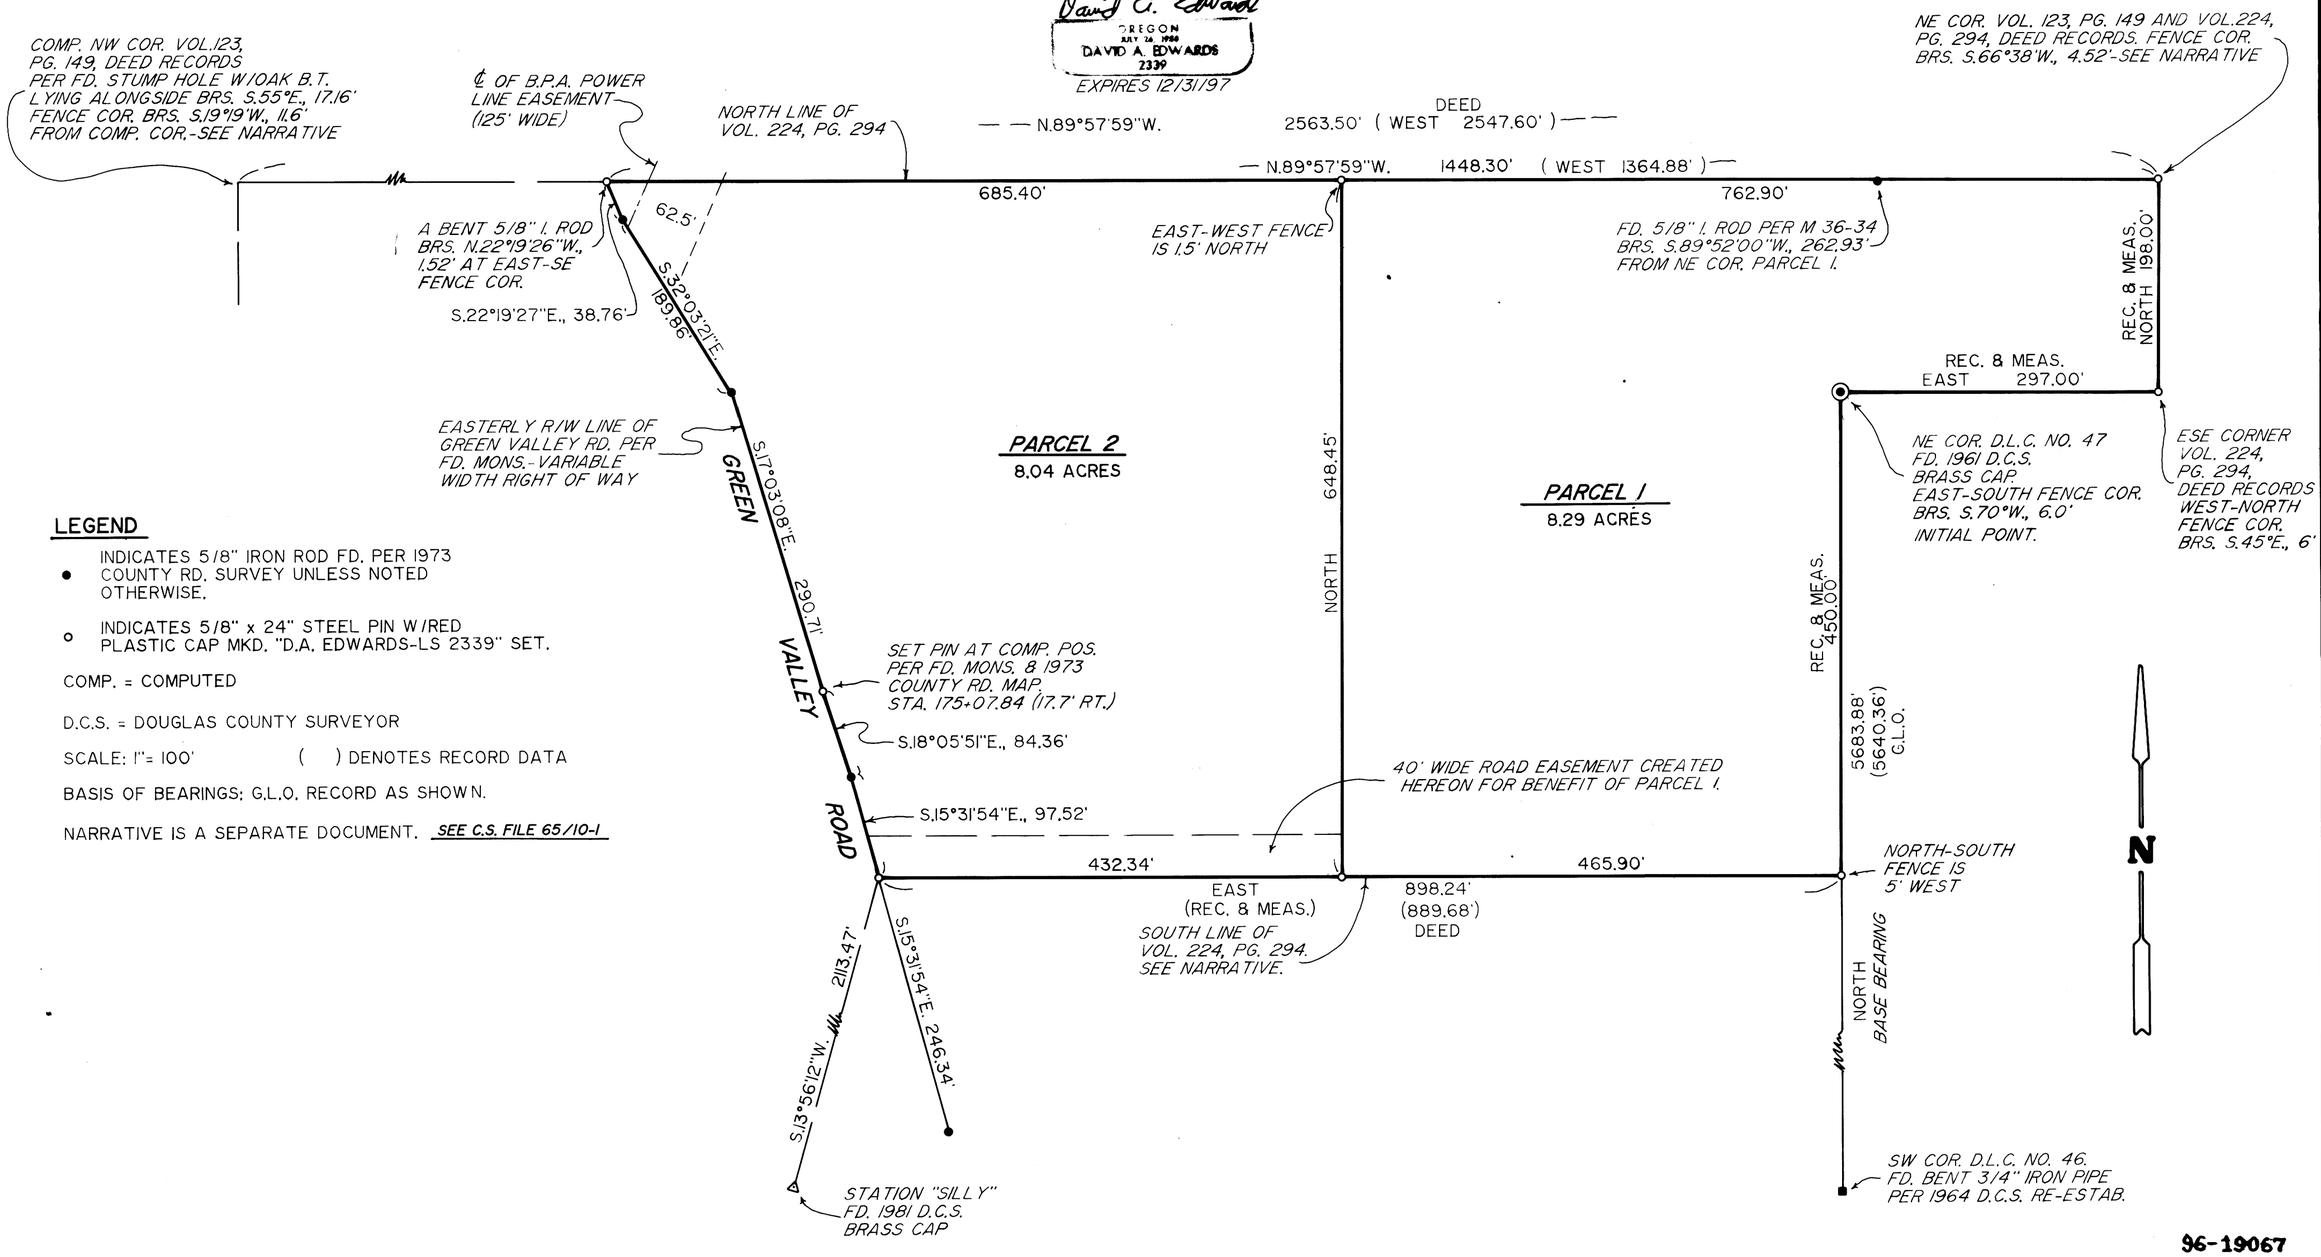

LEGEND

- ● INDICATES 5/8" IRON ROD FD. PER 1973 COUNTY RD. SURVEY UNLESS NOTED OTHERWISE.
- ○ INDICATES 5/8" x 24" STEEL PIN W/RED PLASTIC CAP MKD. "D.A. EDWARDS-LS 2339" SET.

COMP. = COMPUTED

D.C.S. = DOUGLAS COUNTY SURVEYOR

SCALE: 1"= 100' ( ) DENOTES RECORD DATA

BASIS OF BEARINGS: G.L.O. RECORD AS SHOWN.

NARRATIVE IS A SEPARATE DOCUMENT. *SEE C.S. FILE 65/10-1*

1996 - 00734

96-19067