2004-0038 B

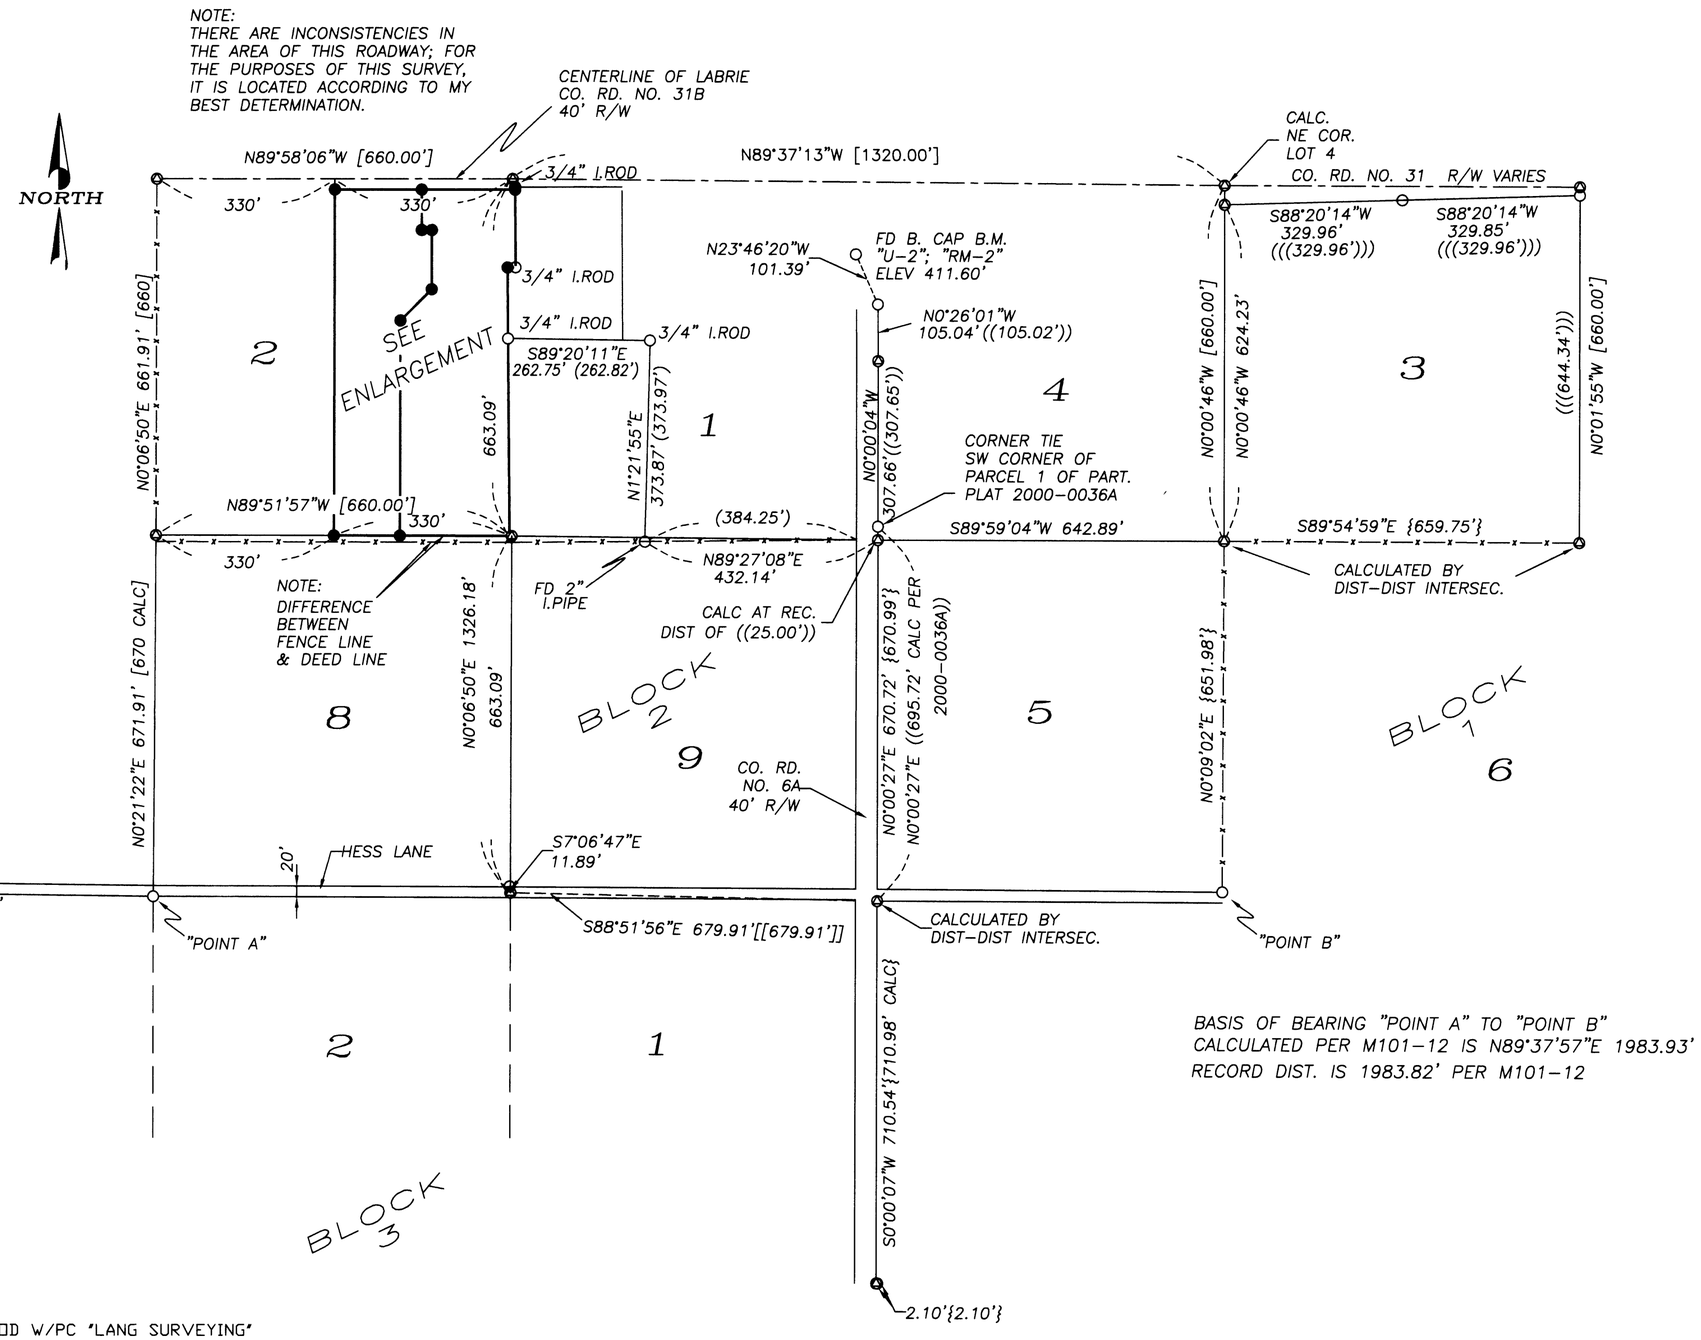

BASIS OF BEARING "POINT A" TO "POINT B"
CALCULATED PER M101-12 IS N89°37'57"E 1983.93'
RECORD DIST. IS 1983.82' PER M101-12

LEGEND

- ● SET 5/8"X30" IRON ROD W/PC "LANG SURVEYING"
- ○ FOUND 5/8" I. ROD OR AS NOTED
- ⊗ CALCULATED POSITION
- × FENCE LINE
- [ ] REC. PER VOL 1C PG 56, R.H.O.T. PLAT "B"
- [[ ]] REC PER M90-59
- ( ) REC PER M41-17 & M41-41
- ( ) REC PER CS 51/313-5
- (( )) REC PER 2000-0036A
- ((( ))) REC PER M52-20

REGISTERED PROFESSIONAL LAND SURVEYOR
OREGON JULY 8, 1987 GREGORY D. LANG #2295
EXPIRES 12-31-04

GREGORY D. LANG PROFESSIONAL LAND SURVEYING
TEL 541-679-5542
7550 WILLIS CREEK RD.
WINSTON, OR 97496

SCALE: 1"=200'
DATE: MAY 2004

SURVEYED FOR: DELBERT & DEBBIE FOLEY
212 LA BRIE ROAD
ROSEBURG, OR 97470

2004-0038 B