


2020-0037 A

BASIS OF BEARING:

BASIS: O.C.R.S. (OREGON COORDINATE REFERENCE SYSTEM)
METHOD: O.R.G.N. (OREGON REAL-TIME GNSS NETWORK)
ZONE: COTTAGE GROVE - CANYONVILLE
UNITS: INTERNATIONAL FEET
DATUM: NAD 83 (2011)
EPOCH: 2010

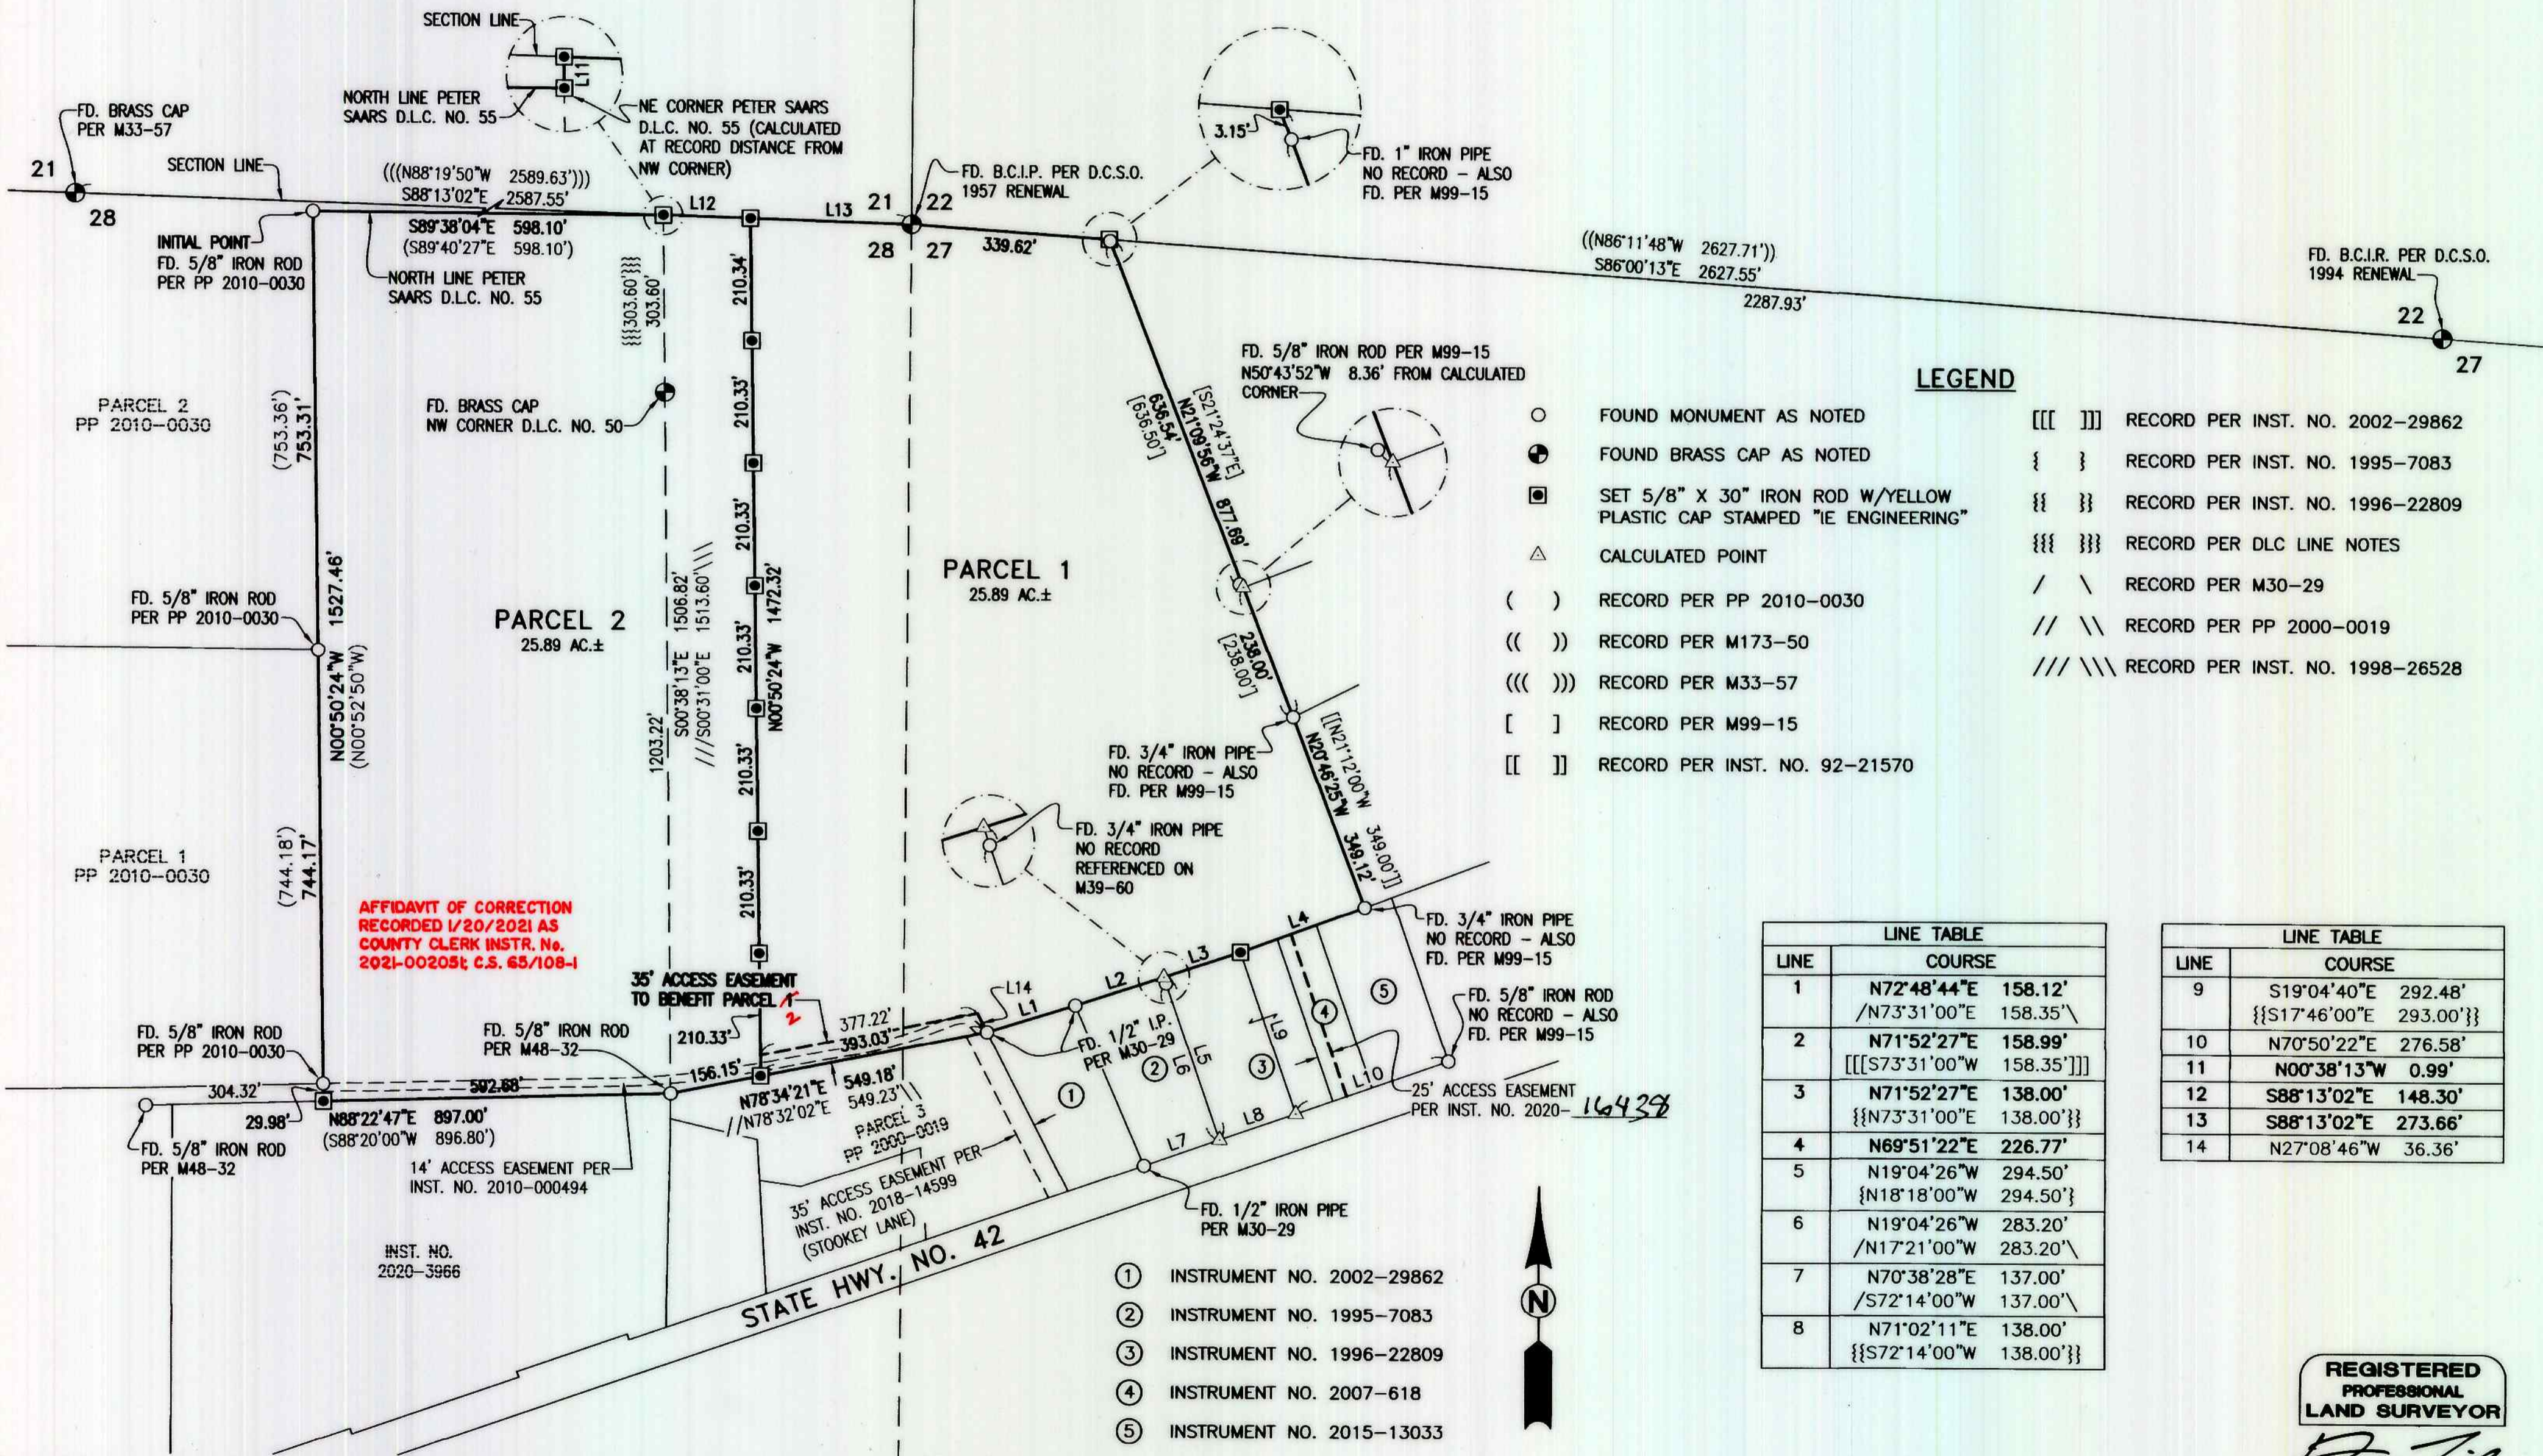

LEGEND

- FOUND MONUMENT AS NOTED
- ⊕ FOUND BRASS CAP AS NOTED
- SET 5/8" X 30" IRON ROD W/YELLOW PLASTIC CAP STAMPED "IE ENGINEERING"
- △ CALCULATED POINT
- () RECORD PER PP 2010-0030
- (()) RECORD PER M173-50
- ((()) RECORD PER M33-57
- [] RECORD PER M99-15
- [[]] RECORD PER INST. NO. 92-21570
- [[[]]] RECORD PER INST. NO. 2002-29862
- { } RECORD PER INST. NO. 1995-7083
- {} RECORD PER INST. NO. 1996-22809
- {} {} RECORD PER DLC LINE NOTES
- / \ RECORD PER M30-29
- // \\ RECORD PER PP 2000-0019
- /// \\\ RECORD PER INST. NO. 1998-26528


LINE	COURSE	LENGTH
1	N72°48'44"E /N73°31'00"E	158.12' 158.35'
2	N71°52'27"E [[[S73°31'00"W	158.99' 158.35']]]
3	N71°52'27"E [[[N73°31'00"E	138.00' 138.00']]]
4	N69°51'22"E {N18°18'00"W	226.77' 294.50'
5	N19°04'26"W {N18°18'00"W	294.50' 294.50'
6	N19°04'26"W /N17°21'00"W	283.20' 283.20'\
7	N70°38'28"E /S72°14'00"W	137.00' 137.00'\
8	N71°02'11"E [[S72°14'00"W	138.00' 138.00']]]

LINE	COURSE	LENGTH
9	S19°04'40"E [[[S17°46'00"E	292.48' 293.00']]]
10	N70°50'22"E	276.58'
11	N00°38'13"W	0.99'
12	S88°13'02"E	148.30'
13	S88°13'02"E	273.66'
14	N27°08'46"W	36.36'

- ① INSTRUMENT NO. 2002-29862
- ② INSTRUMENT NO. 1995-7083
- ③ INSTRUMENT NO. 1996-22809
- ④ INSTRUMENT NO. 2007-618
- ⑤ INSTRUMENT NO. 2015-13033

AFFIDAVIT OF CORRECTION
RECORDED 1/20/2021 AS
COUNTY CLERK INSTR. No.
2021-00209; C.S. 65/108-1

2020-0037 A

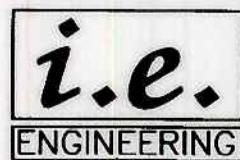

809 SE Pine Street
Roseburg, Oregon 97470
PHONE (541) 673-0166
FAX (541) 440-9392
iemail@ieengineering.com

SURVEYED FOR:
CURT STOOKEY
167 STOOKEY LN.
TENMILE, OR 97481

PAGE: 1 OF 2
JOB NO: 3008-01
DATE: 5/11/2020

LAND PARTITION

LYING IN THE NW 1/4 OF SECTION 27 AND THE NE 1/4 OF SECTION 28,
TOWNSHIP 28 SOUTH, RANGE 7 WEST, WILLAMETTE MERIDIAN, DOUGLAS COUNTY, OREGON



REGISTERED
PROFESSIONAL
LAND SURVEYOR

D.J.
OREGON
JULY 10, 2018
DEREK ALLEN FIBIGL
77565

EXPIRES: 12/31/21