


2022-0014 A

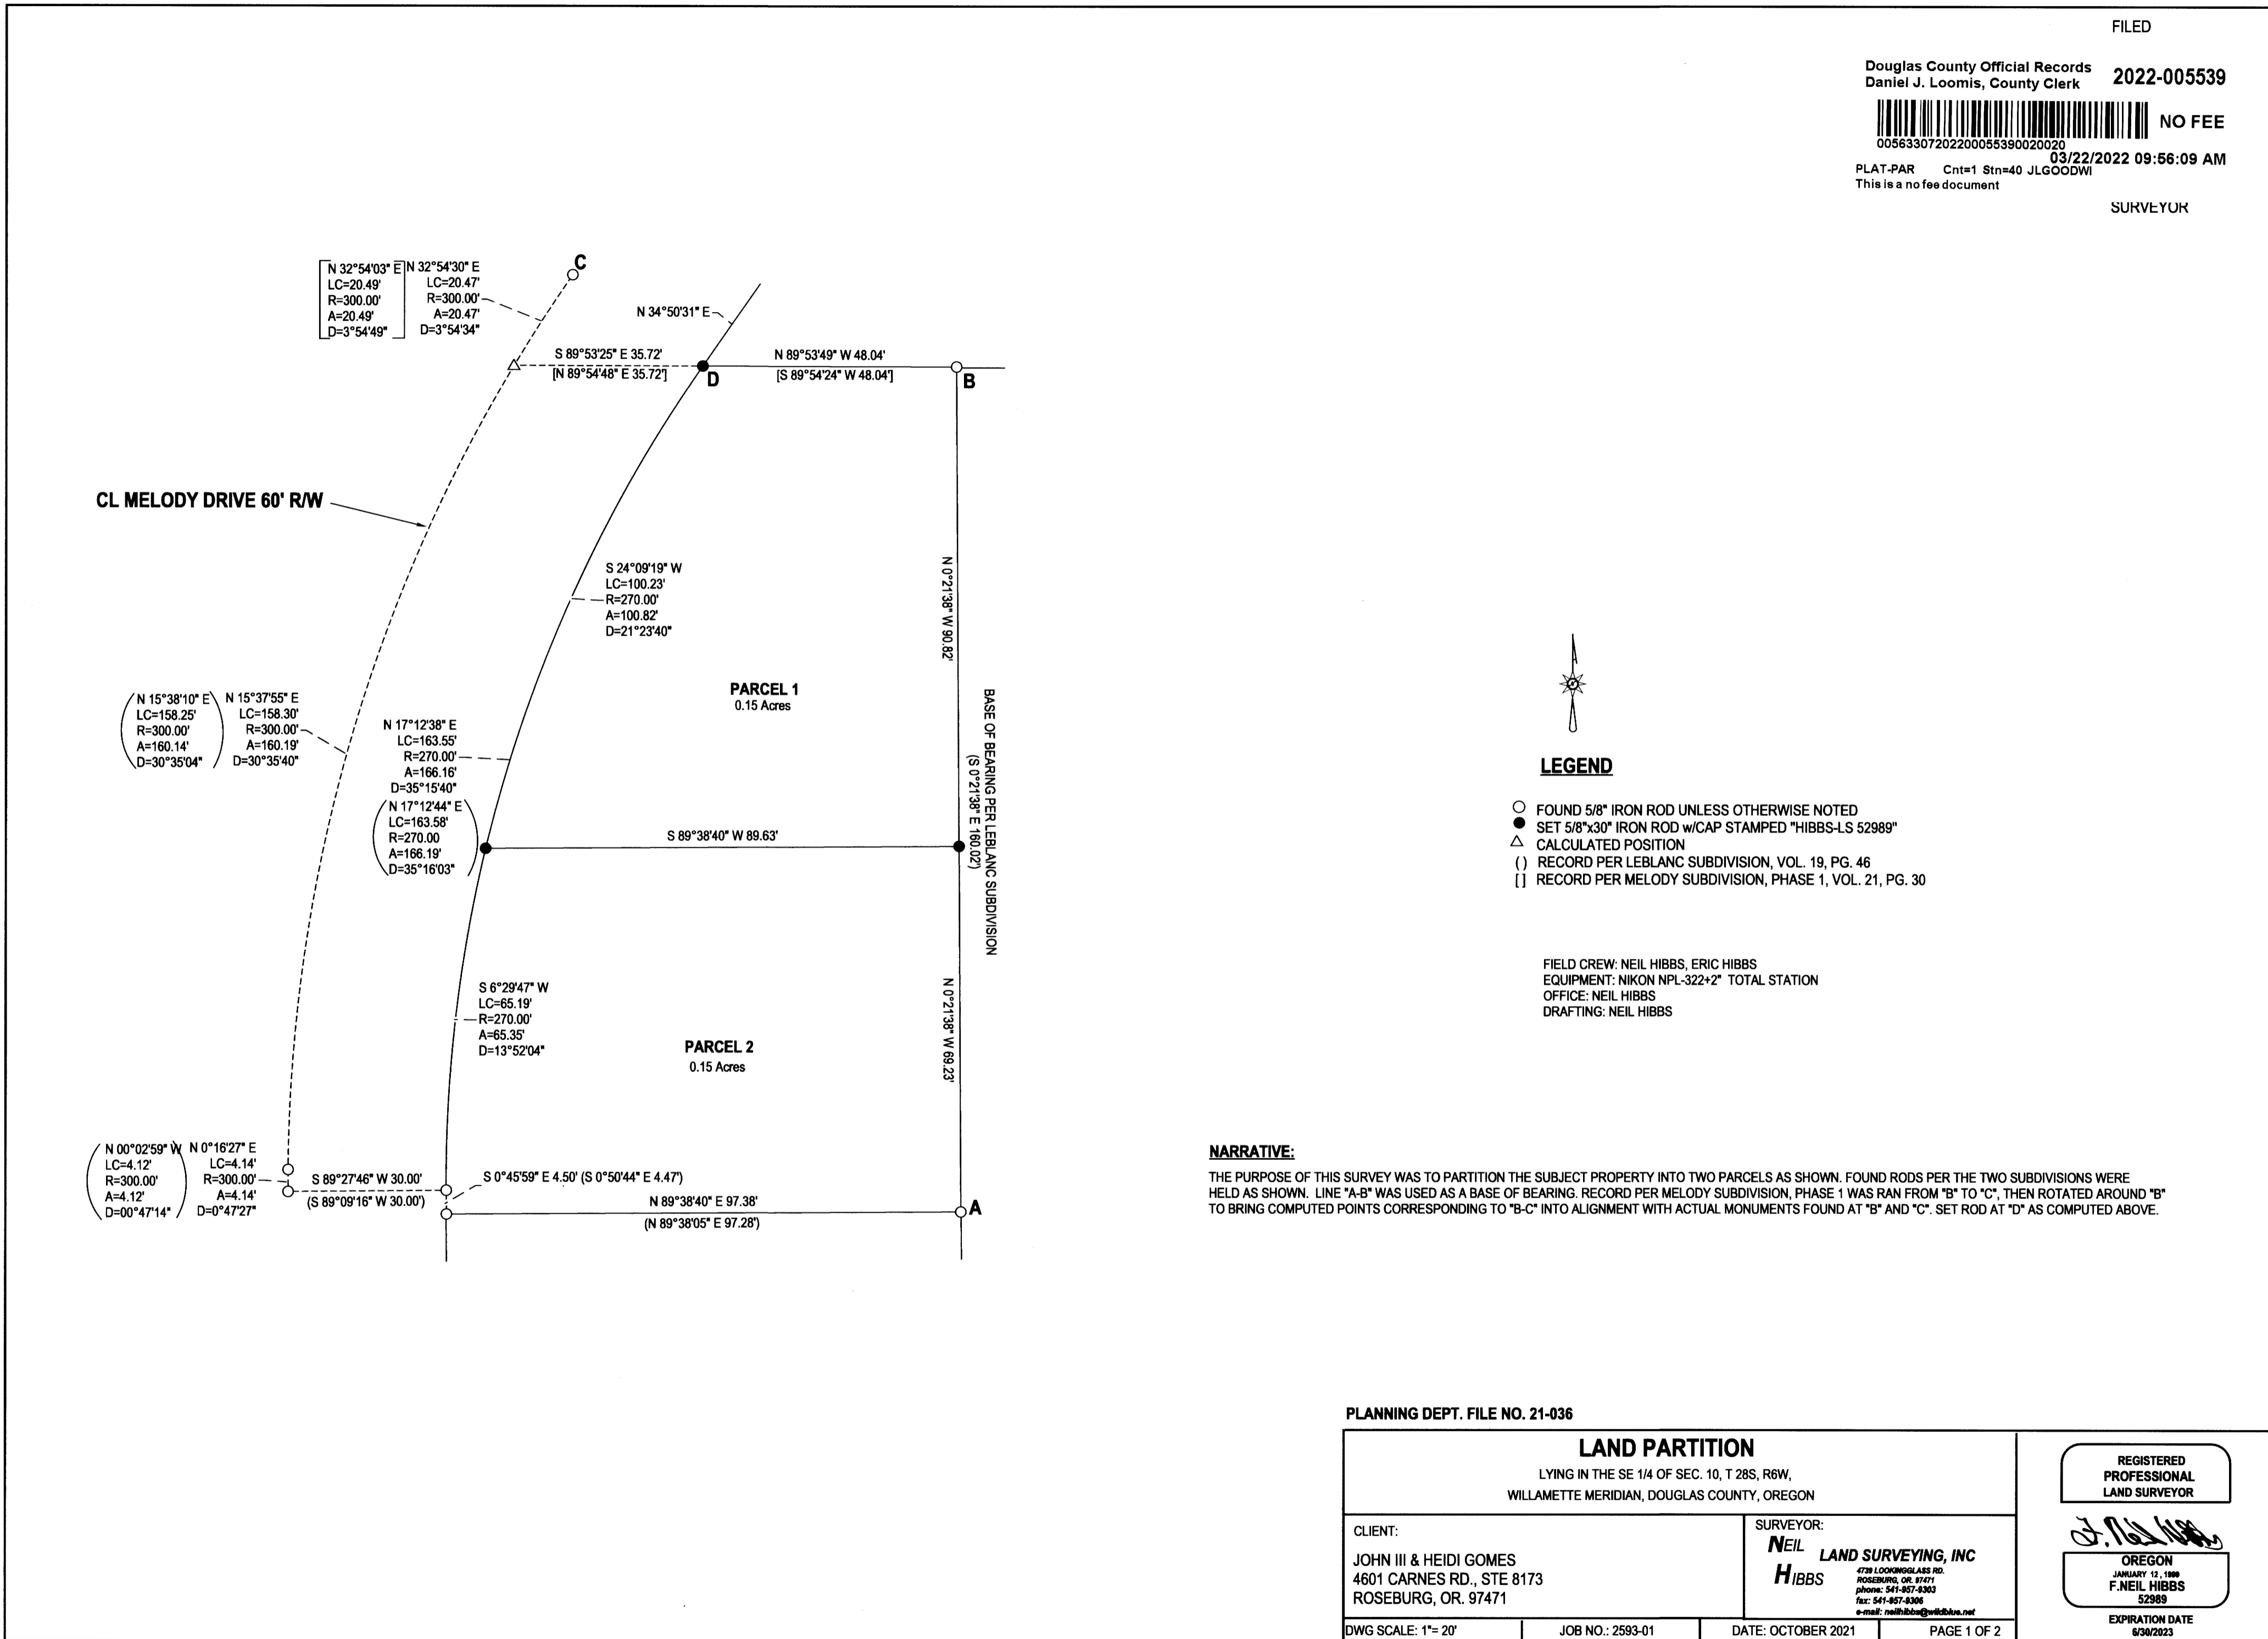

FILED

Douglas County Official Records 2022-005539  
Daniel J. Loomis, County Clerk

NO FEE

0056330720220055390020020

03/22/2022 09:56:09 AM

PLAT-PAR Cnt=1 Stn=40 JLGODWI  
This is a no fee document

SURVEYOR

2022-0014 A