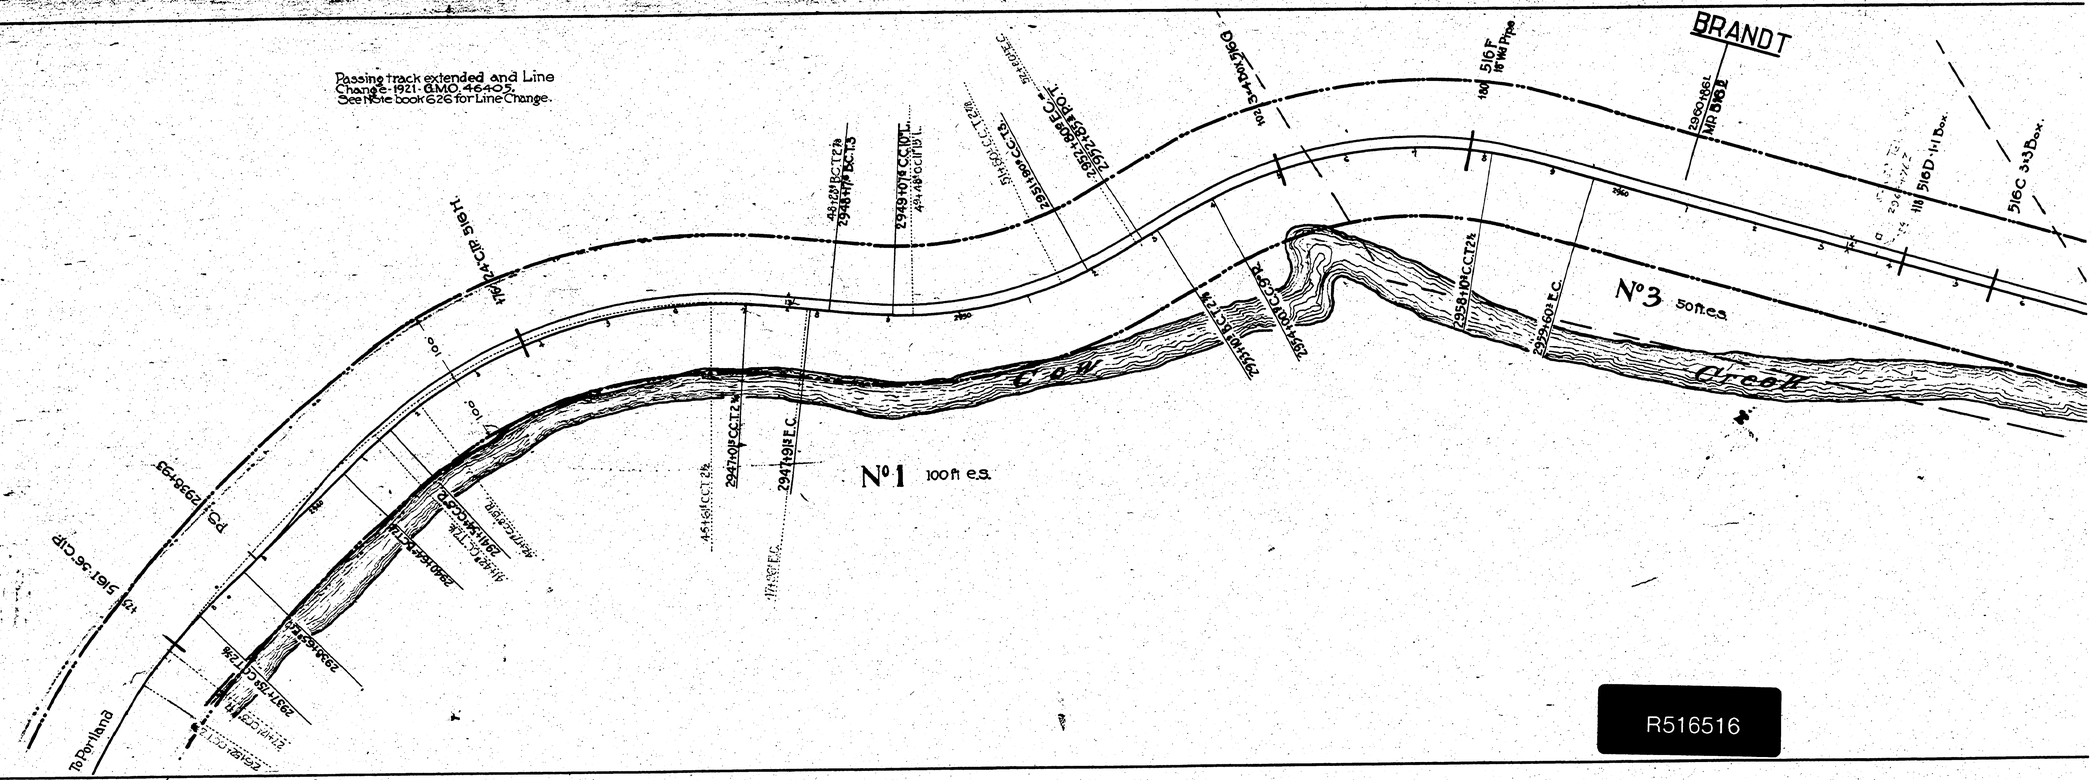
Passing track extended and Line Change - 1921 - G.M.O. 46405.
See Note book 626 for Line Change.
BRANDT
to Portland
to 5161-36 Clip
PC 1 2936+39
to 4+24 Clip Sta 1
to 3+66 Clip Sta 1
5/16 F 16" Wd Pipe
2960.186 L
MP 51.63
118 5/16 D 1+1 Box
5/16 C 3+3 Box
N°3 50 ft e.s.
N°1 100 ft e.s.
Cow Creek
2947.10 H CCT 2%
2947.19 H F.C.
2958.10 CCT 2%
2959.60 F.C.
100

R516516