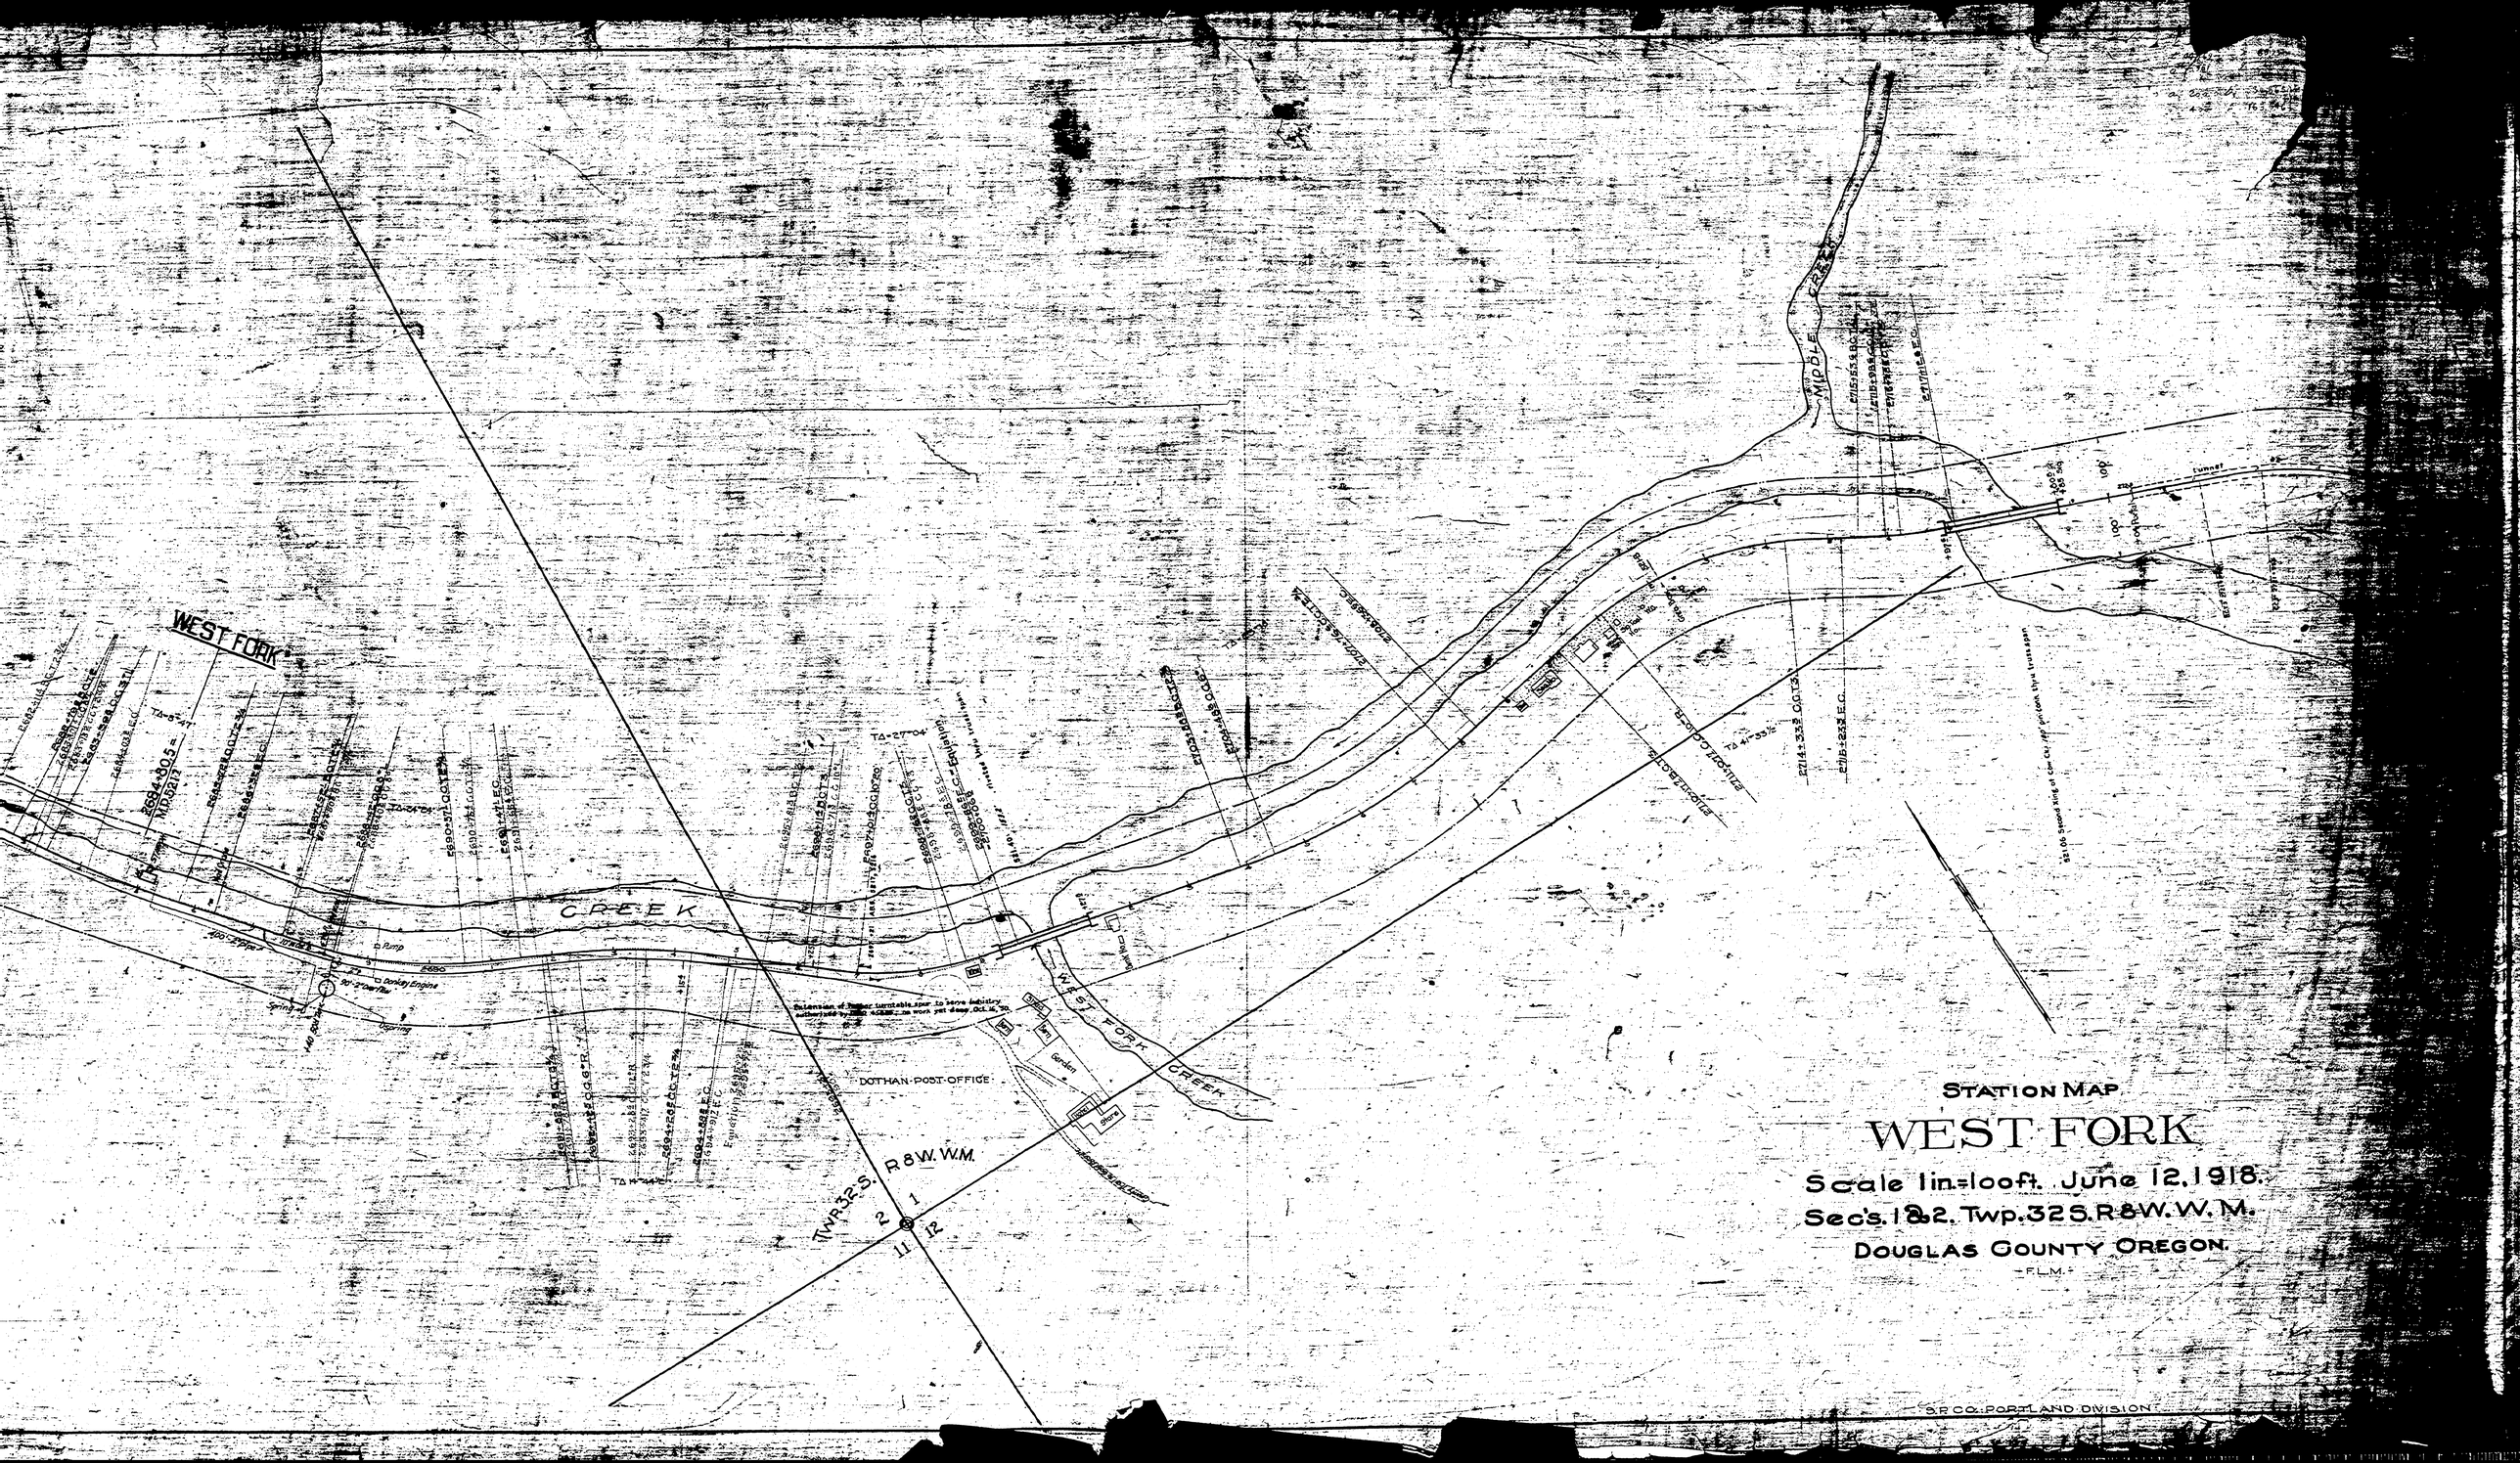
STATION MAP
WEST FORK
Scale 1in.=100ft. June 12, 1918.
Sec's. 1 & 2. Twp. 32 S. R 8 W. W. M.
DOUGLAS COUNTY OREGON.
-F.L.M.-
WEST FORK
CREEK
MIDDLE CREEK
DOTHAN POST OFFICE
T. W. P. 32 S. R 8 W. W. M.
Pump
Donkey Engine
Spring
Logging
Garden
Water Tank
Turntable
Section of Roaster turntable spur to serve industry authorized by Mr. Adams as work yet deep. Oct. 16, 20.
Equation 2+00 = 2+00
Elliott Cut
Elliott Fill
Elliott Cut
Elliott Fill
Elliott Cut
Elliott Fill