



SOUTH UMPQUA RIVER

60777

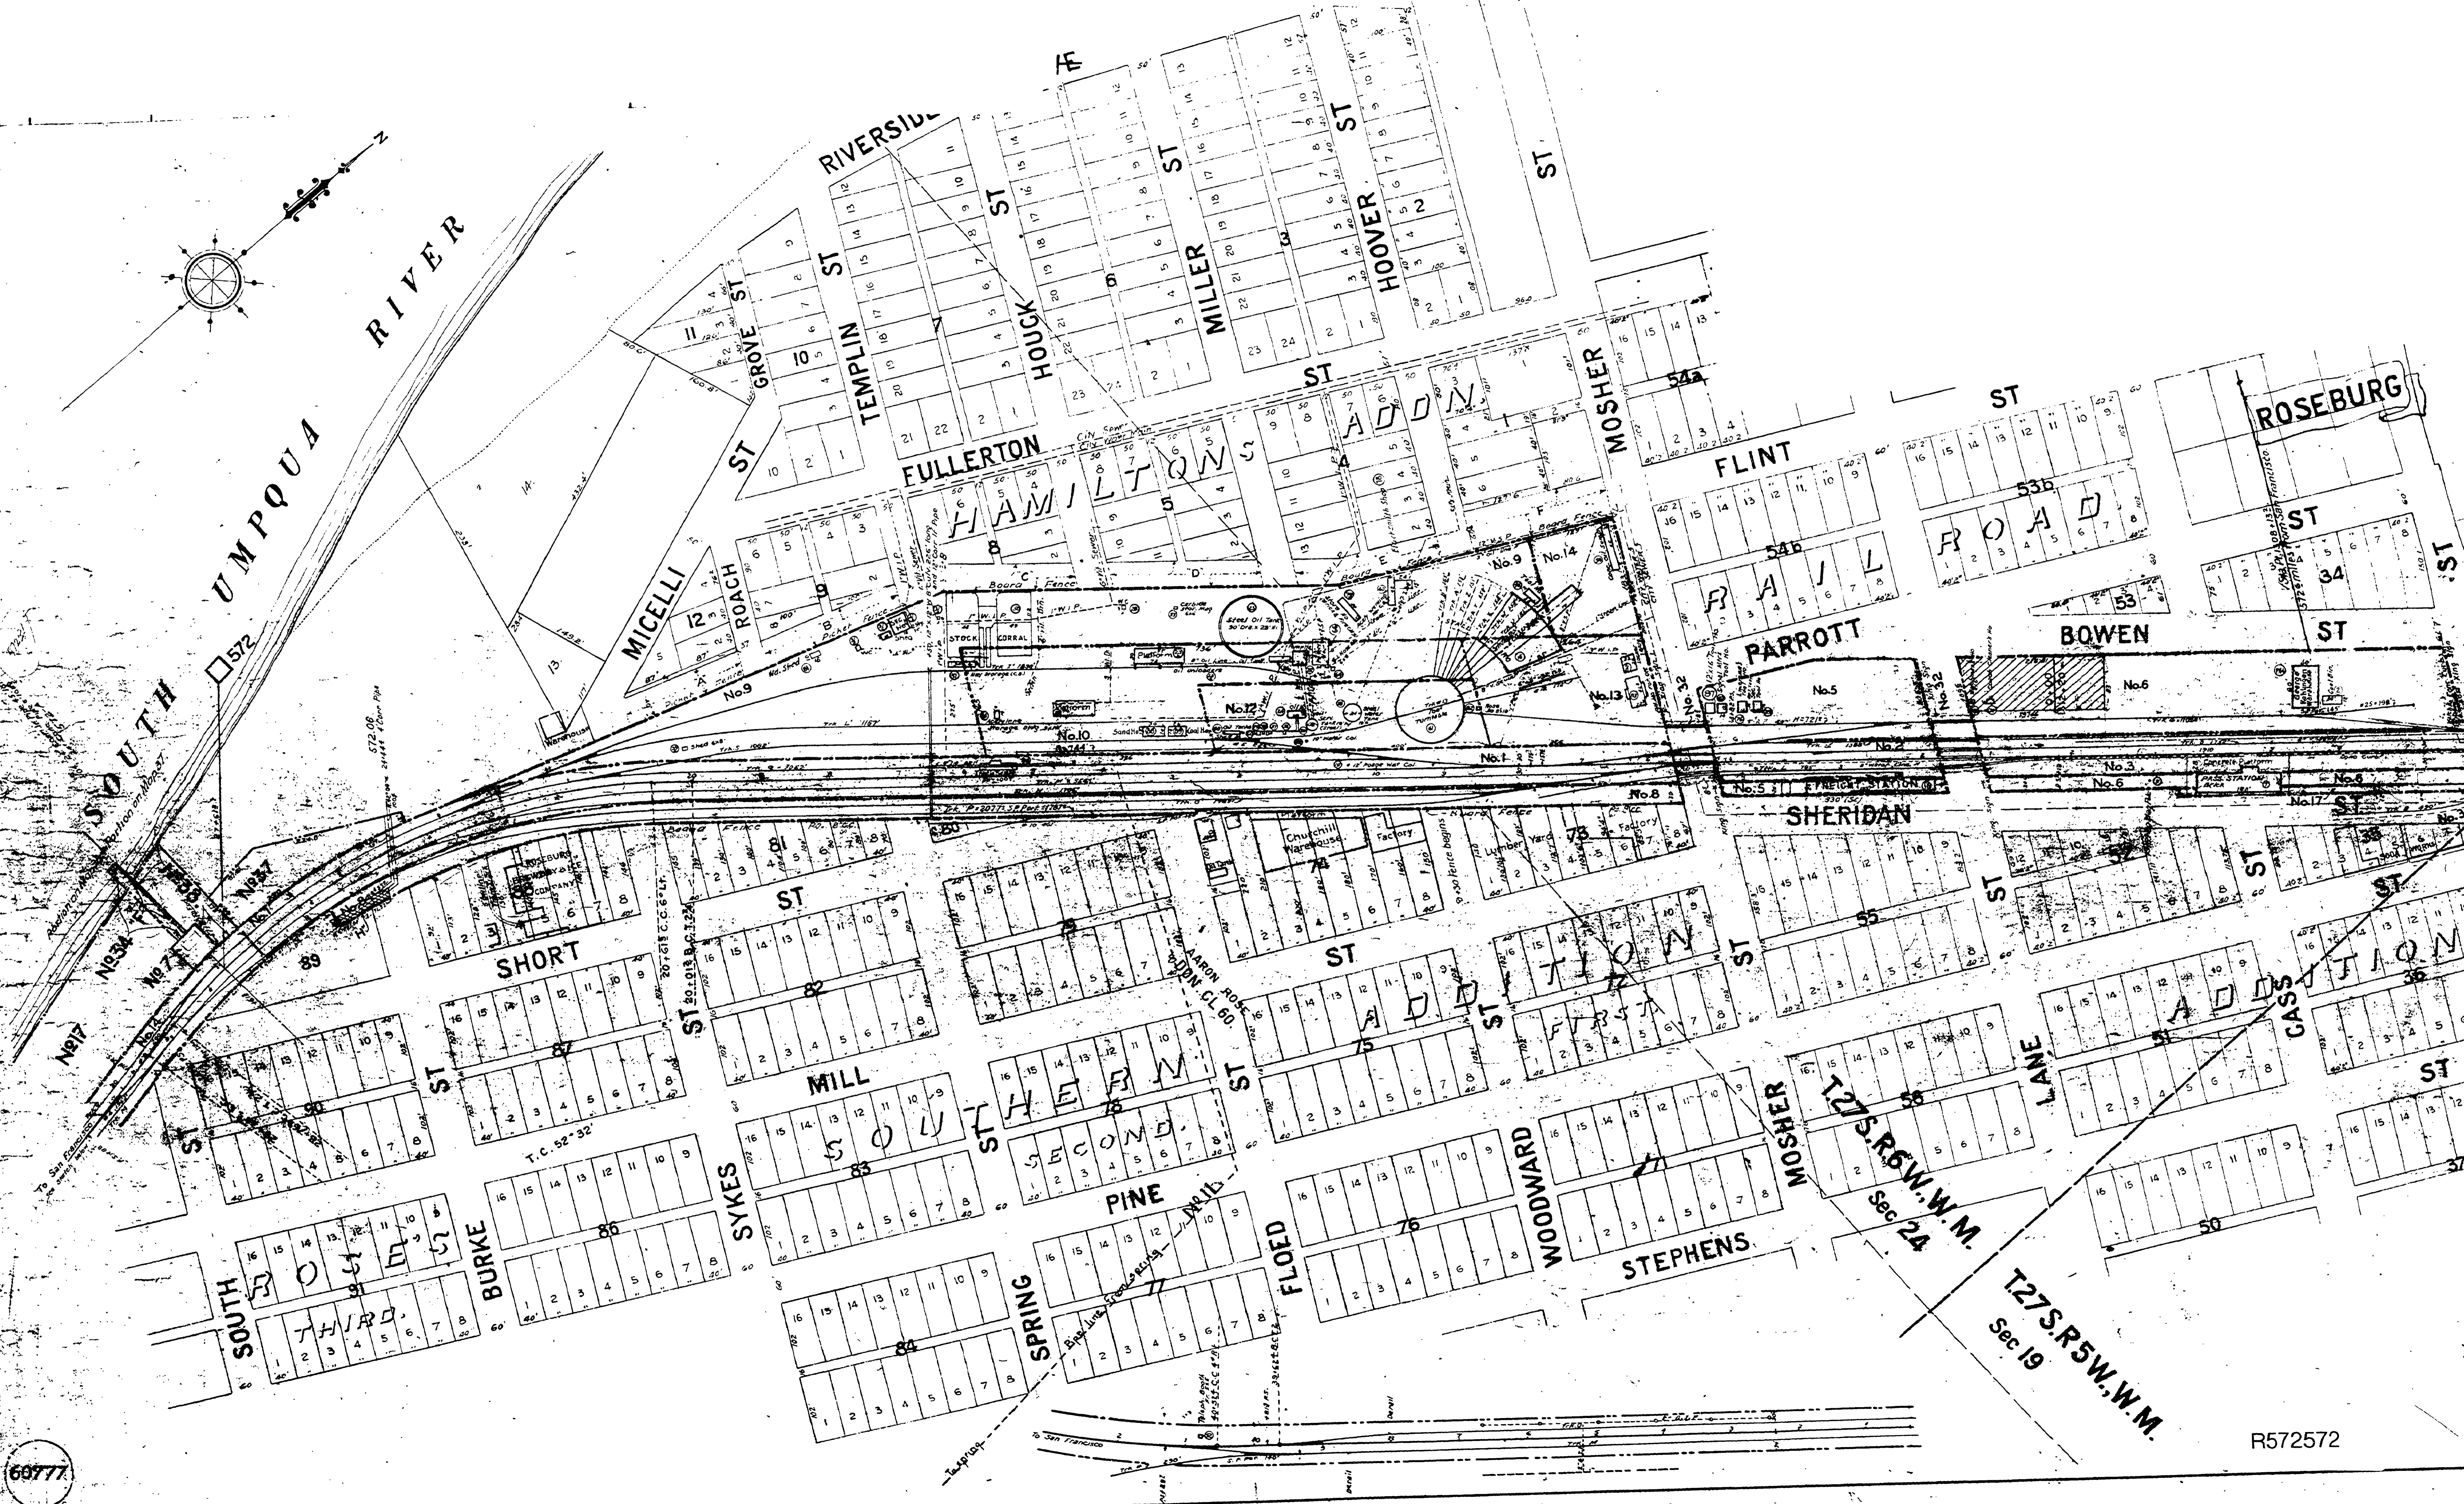

R572572

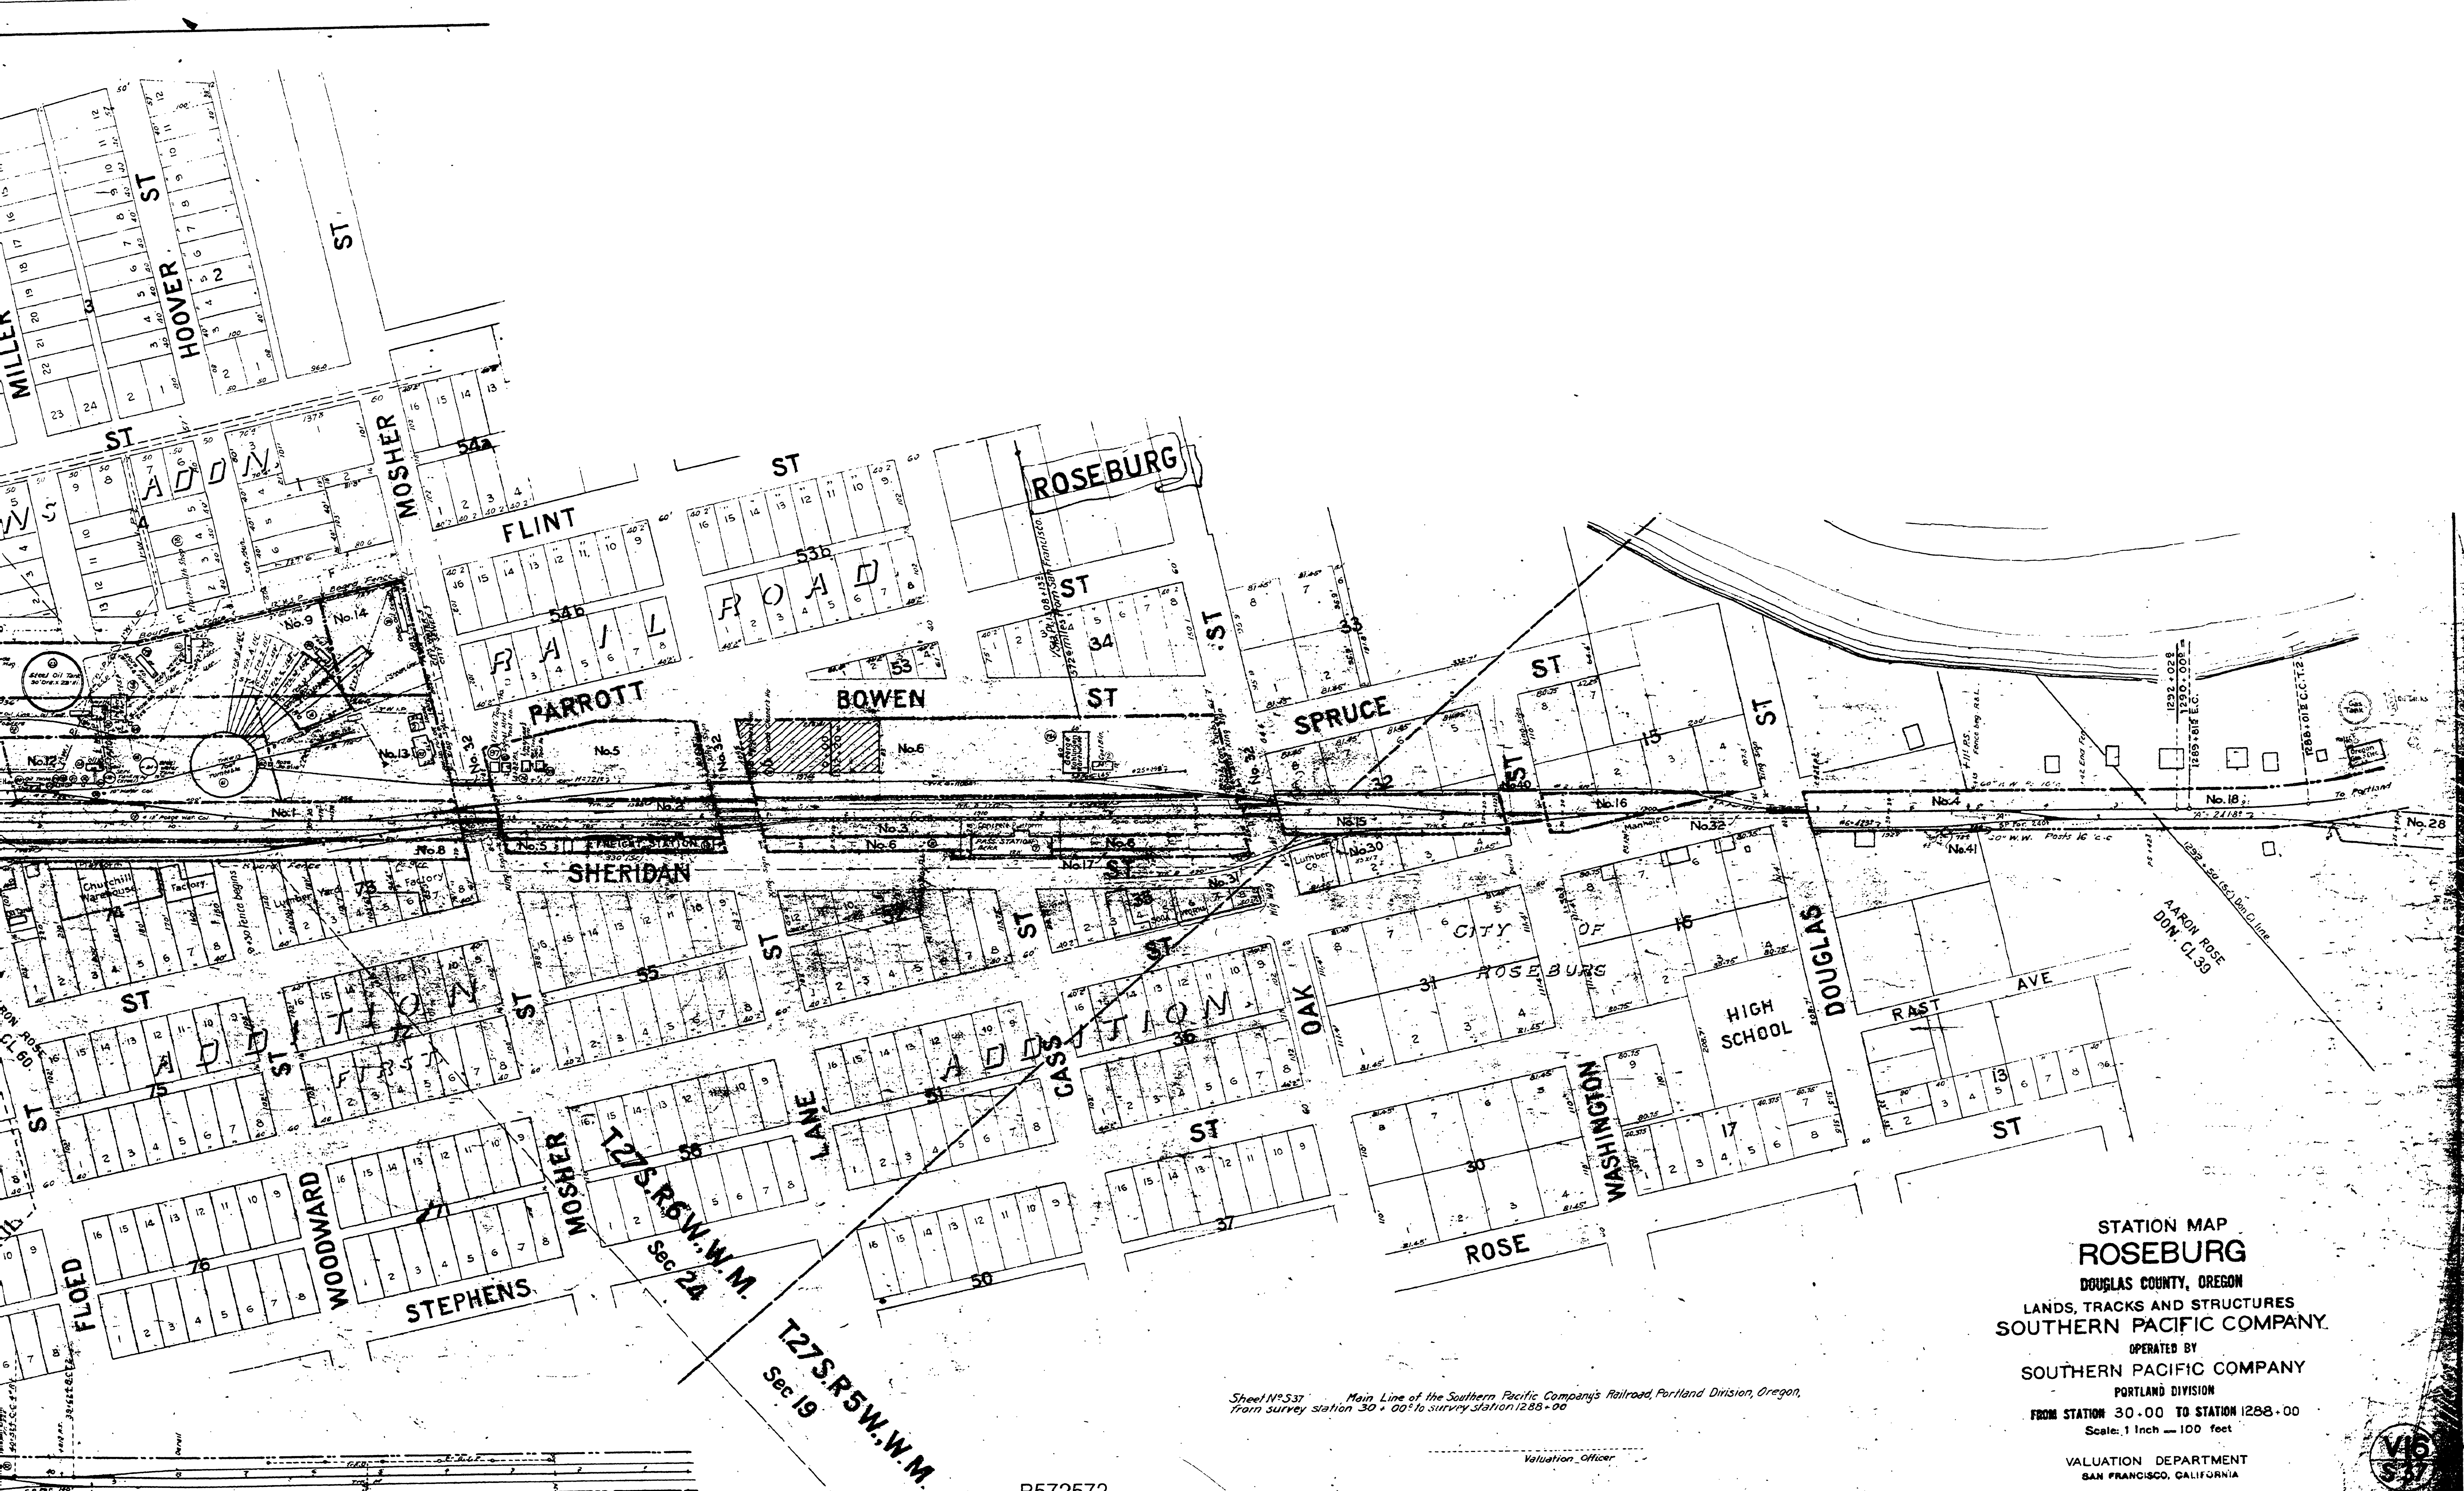

STATION MAP
ROSEBURG
 DOUGLAS COUNTY, OREGON
 LANDS, TRACKS AND STRUCTURES
SOUTHERN PACIFIC COMPANY
 OPERATED BY
SOUTHERN PACIFIC COMPANY
 PORTLAND DIVISION
 FROM STATION 30.00 TO STATION 1288.00
 Scale: 1 Inch = 100 feet
 VALUATION DEPARTMENT
 SAN FRANCISCO, CALIFORNIA

Sheet NPS37 Main Line of the Southern Pacific Company's Railroad, Portland Division, Oregon,
 From survey station 30 + 00 to survey station 1288 + 00

Valuation Officer

R572572

