
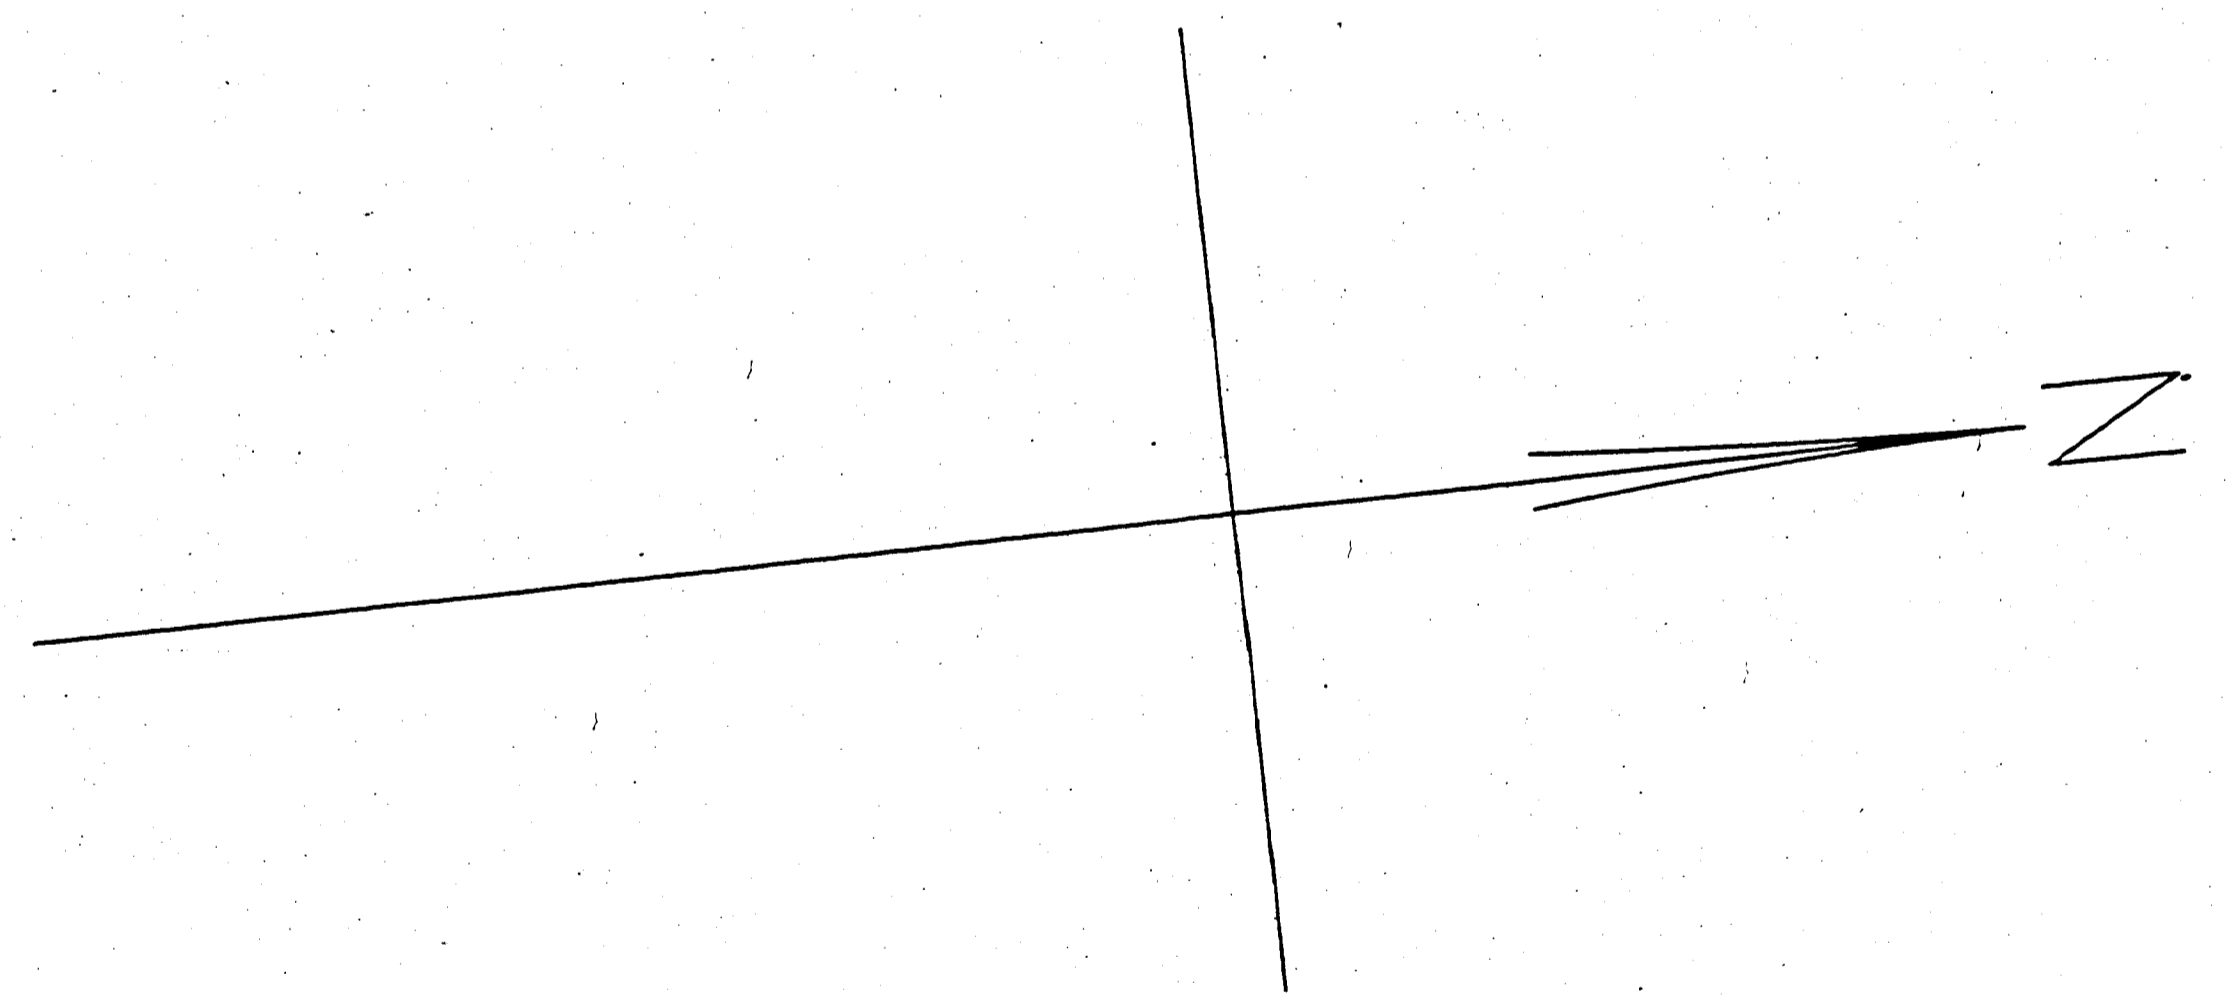


15000 Jones D.L.C. No. 55


Nedum Imbler D.L.C. Cert. No. 127

Samuel C. Braden D.L.C. No. 63

Daniel P. Barnes D.L.C. No.

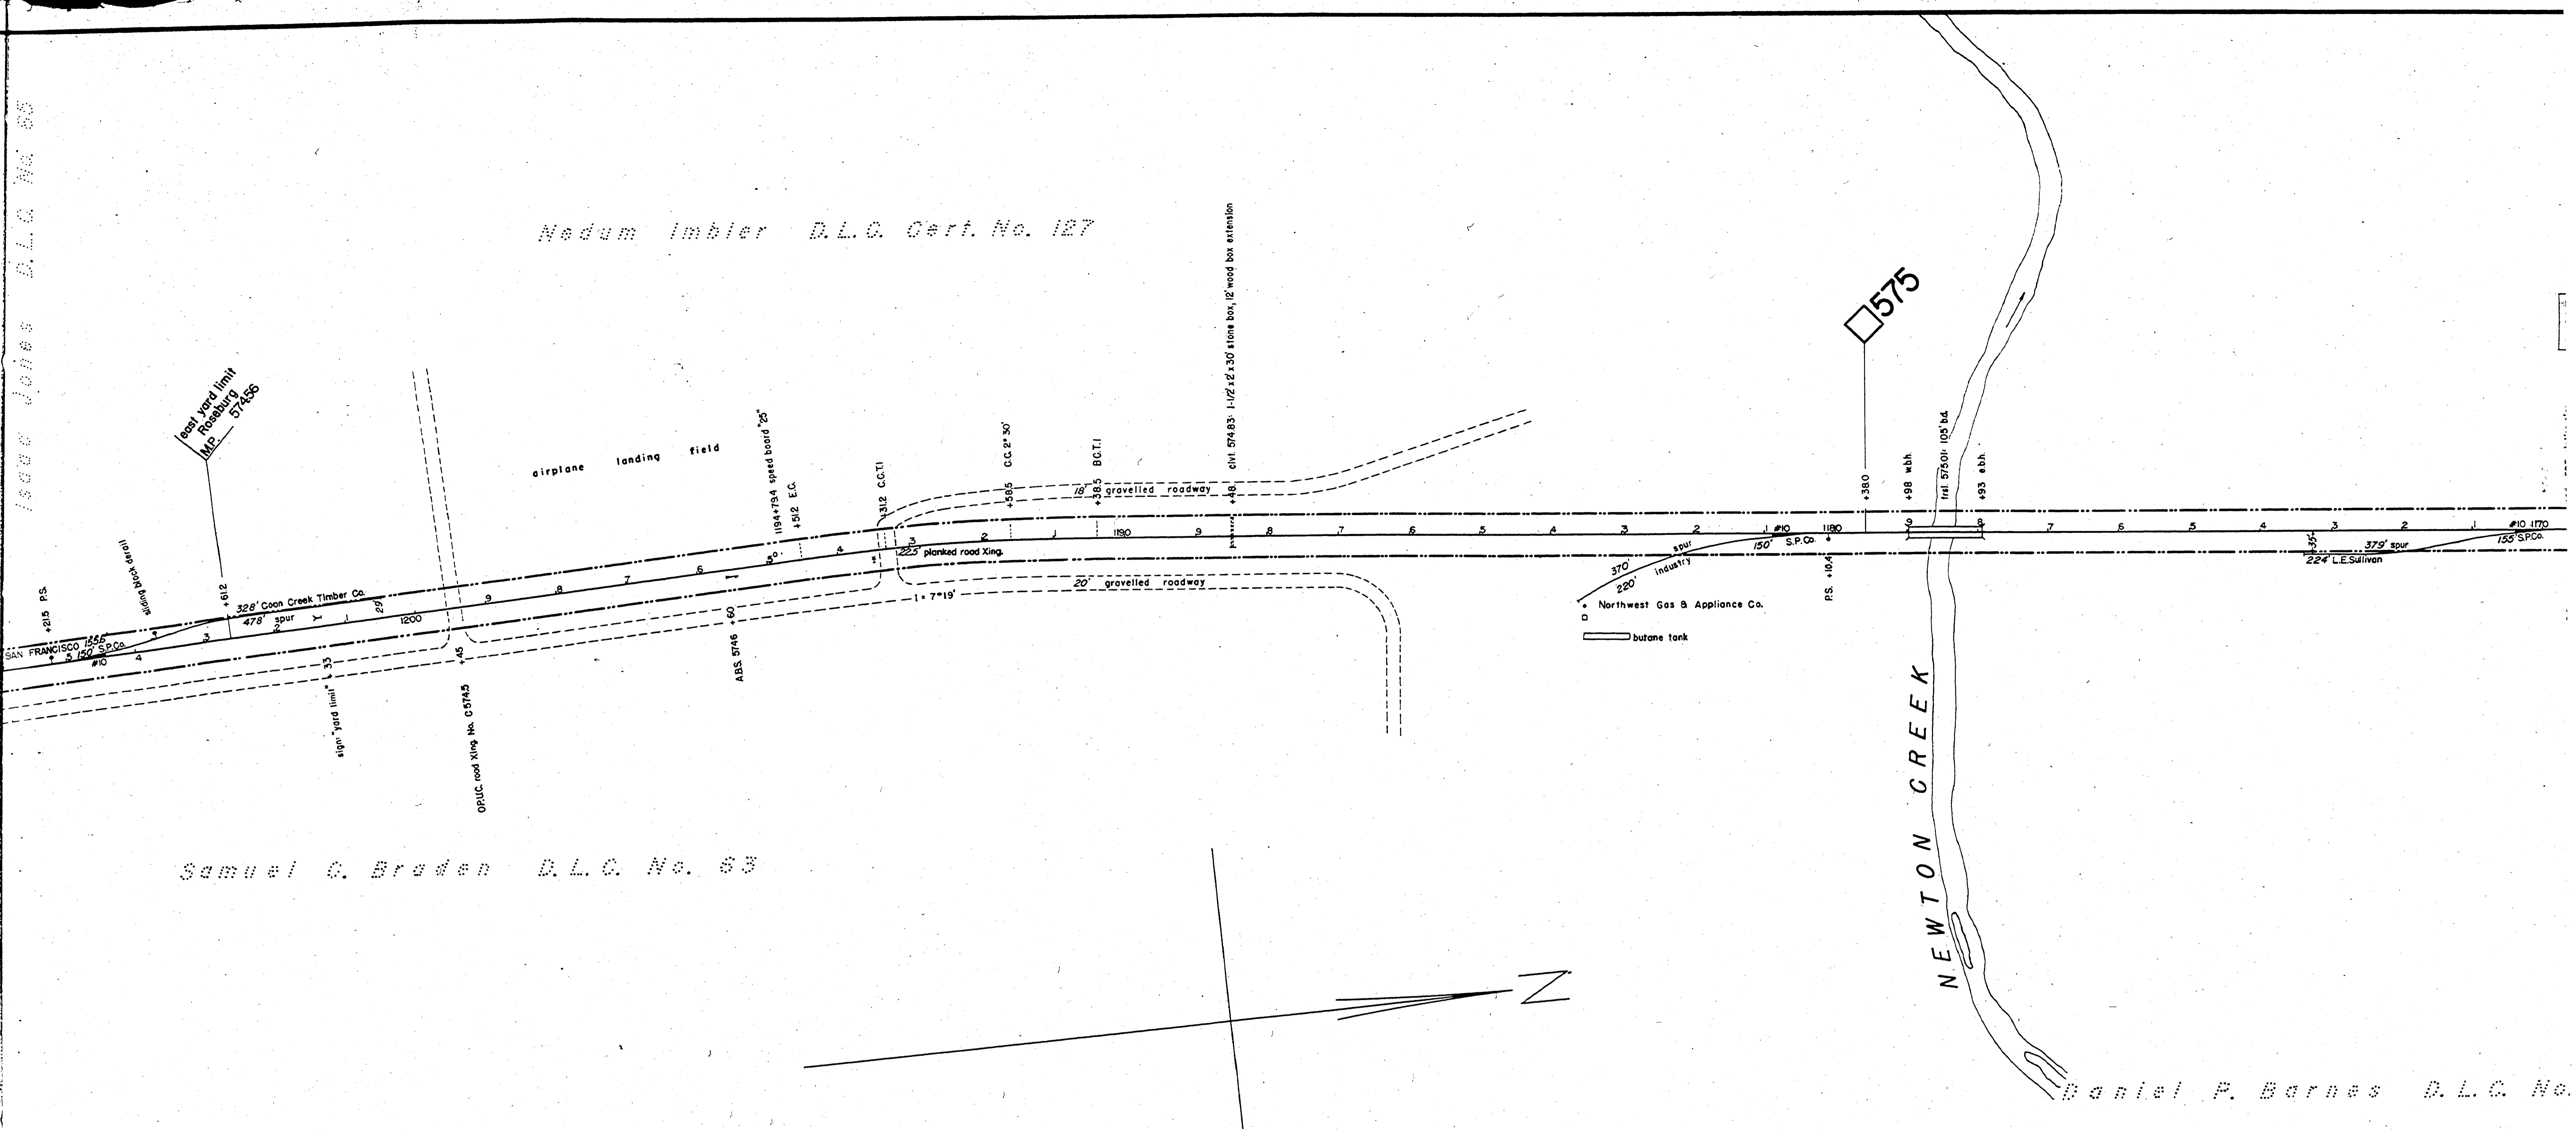

R574575

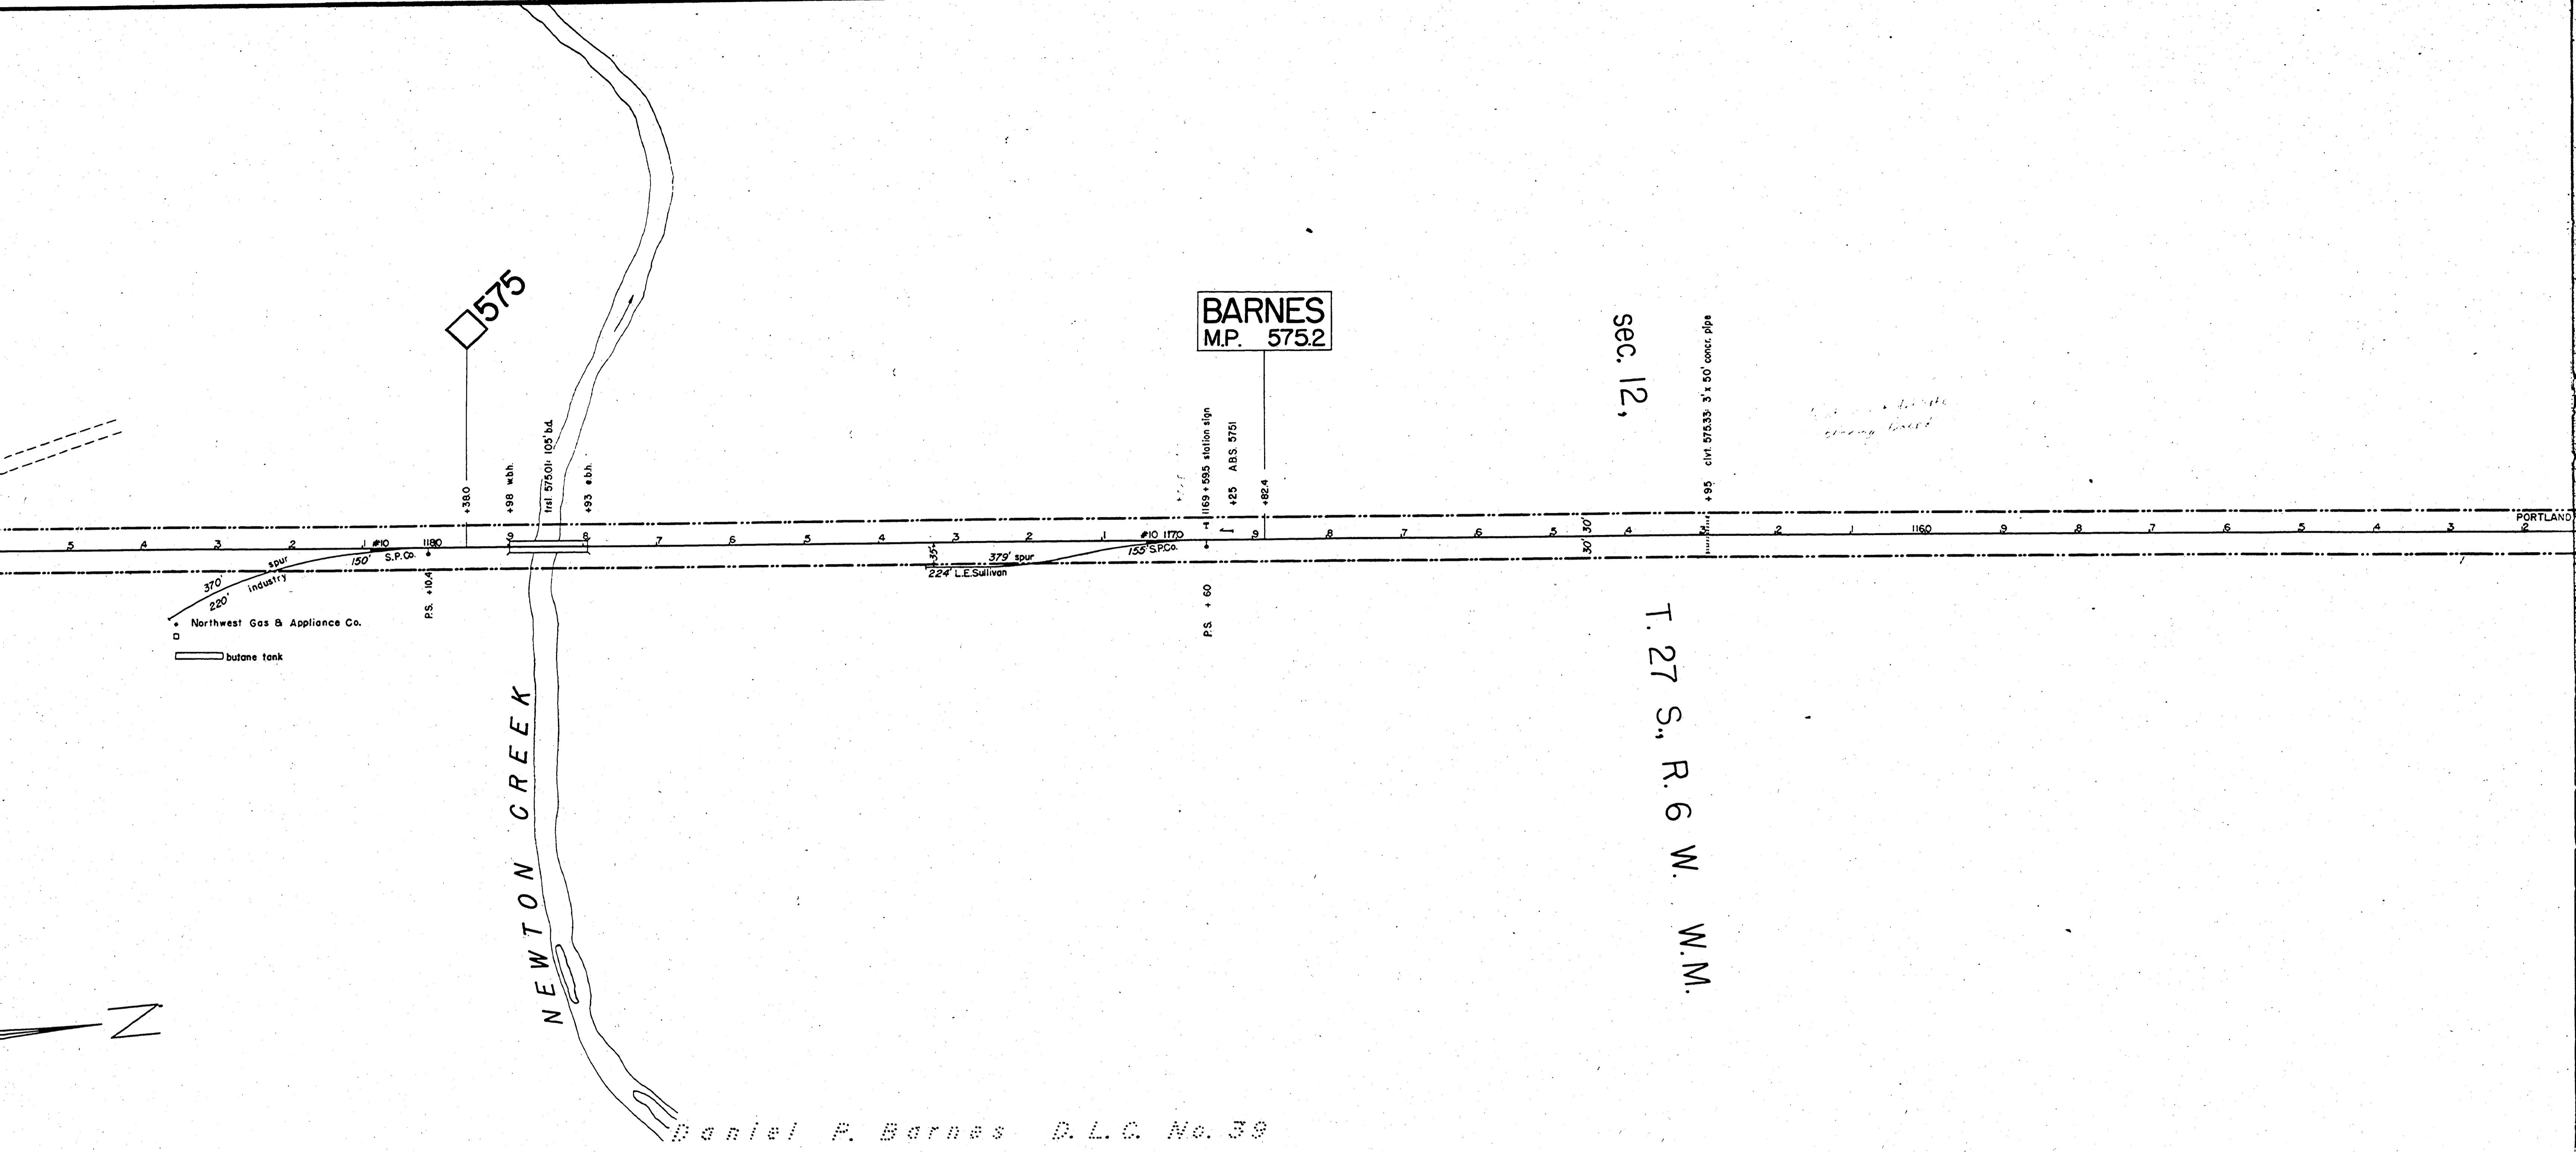

SOUTHERN PACIFIC COMPANY
 PACIFIC LINES
 SISKIYOU LINE
 STATION PLAN
BARNES
 DOUGLAS COUNTY OREGON
 Scale: 1" = 100' WKM March 26, 1949
field checked by HJS; revised April 11, 1950

R574575