


DRAIN

N

N

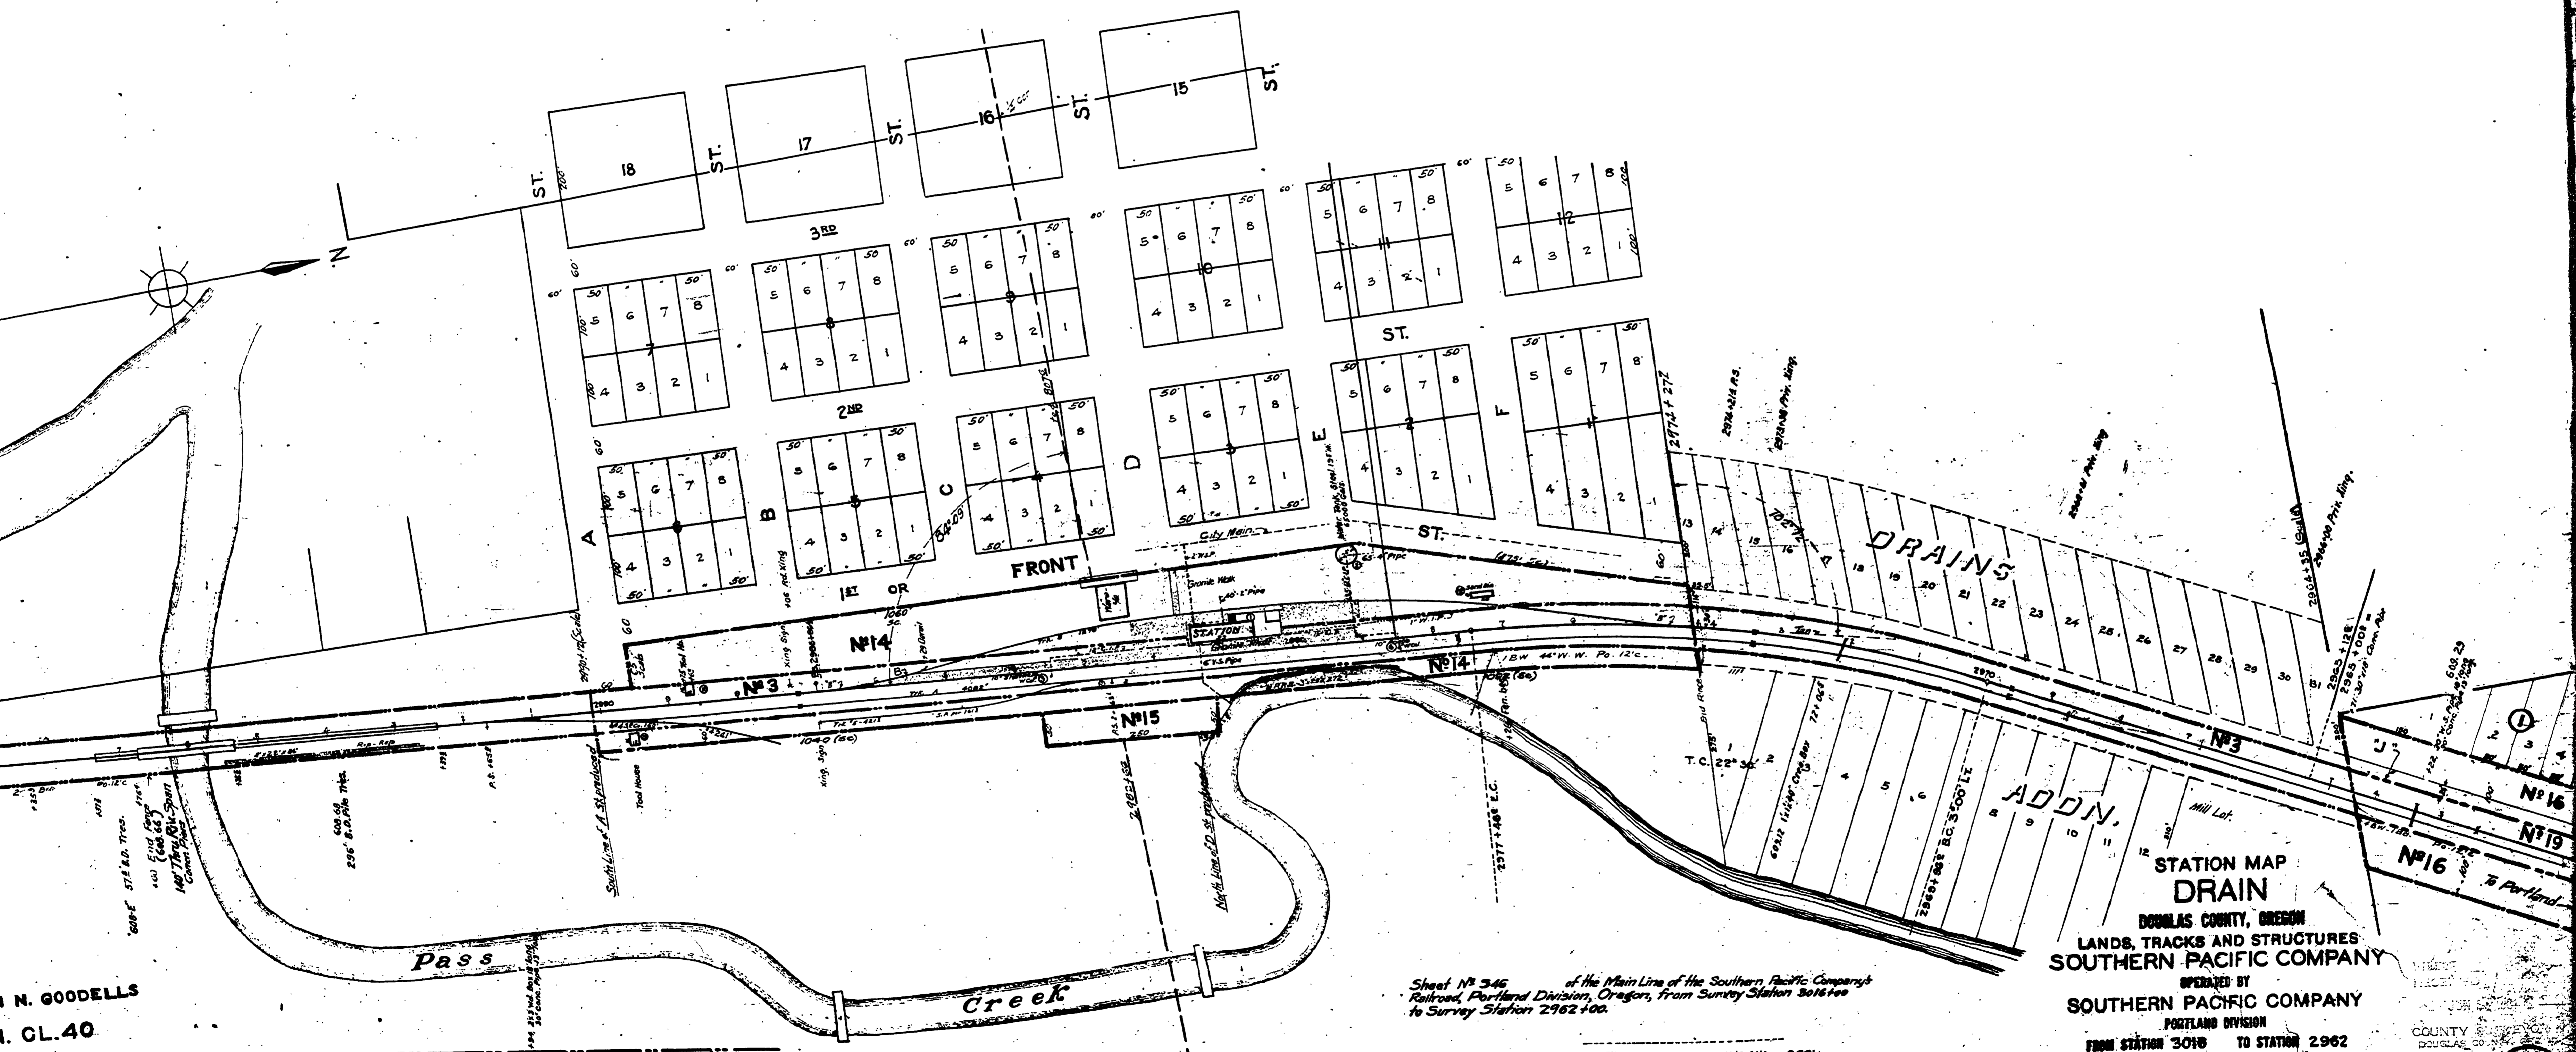

N. GOODELLS  
CL. 40

Sheet No 346 of the Main Line of the Southern Pacific Company's  
Railroad, Portland Division, Oregon, from Survey Station 3016 to  
to Survey Station 2962 100.

Valuation Officer

**STATION MAP  
DRAIN**  
DOUGLAS COUNTY, OREGON  
LANDS, TRACKS AND STRUCTURES  
**SOUTHERN PACIFIC COMPANY**  
OPERATED BY  
**SOUTHERN PACIFIC COMPANY**  
PORTLAND DIVISION  
FROM STATION 3016 TO STATION 2962  
Scale 1 inch = 100 feet

COUNTY  
DOUGLAS

VALUATION DEPARTMENT  
SAN FRANCISCO, CALIFORNIA

R608609

