Note 2: The 2.298 acs previously shown in area col. have been decr. disp of as follows: 0.52 acs. by deed 21578, shown hatched (letter "B").
0.355 acs by deed 21538, 0.30 acs. by deed 21807, shown hatched (letter "C")
1.072 " " " 23105 " " "D"

Note 3: Lands Oregon Law of 1891. Covers 100' R.W. 50' e.s. & over State Lands.

Note 4. 2.22 acs disp of: 0.52 acs already disp'd of by deed 21578, shown hatched letter "B"; 1.212 ac's shown hatched letter "D"
0.856 ac's shown by letter "E" was never claimed as owned by S.P.Co

Note 5: All minerals oil natural gas, petroleum and other hydrocarbons reserved.

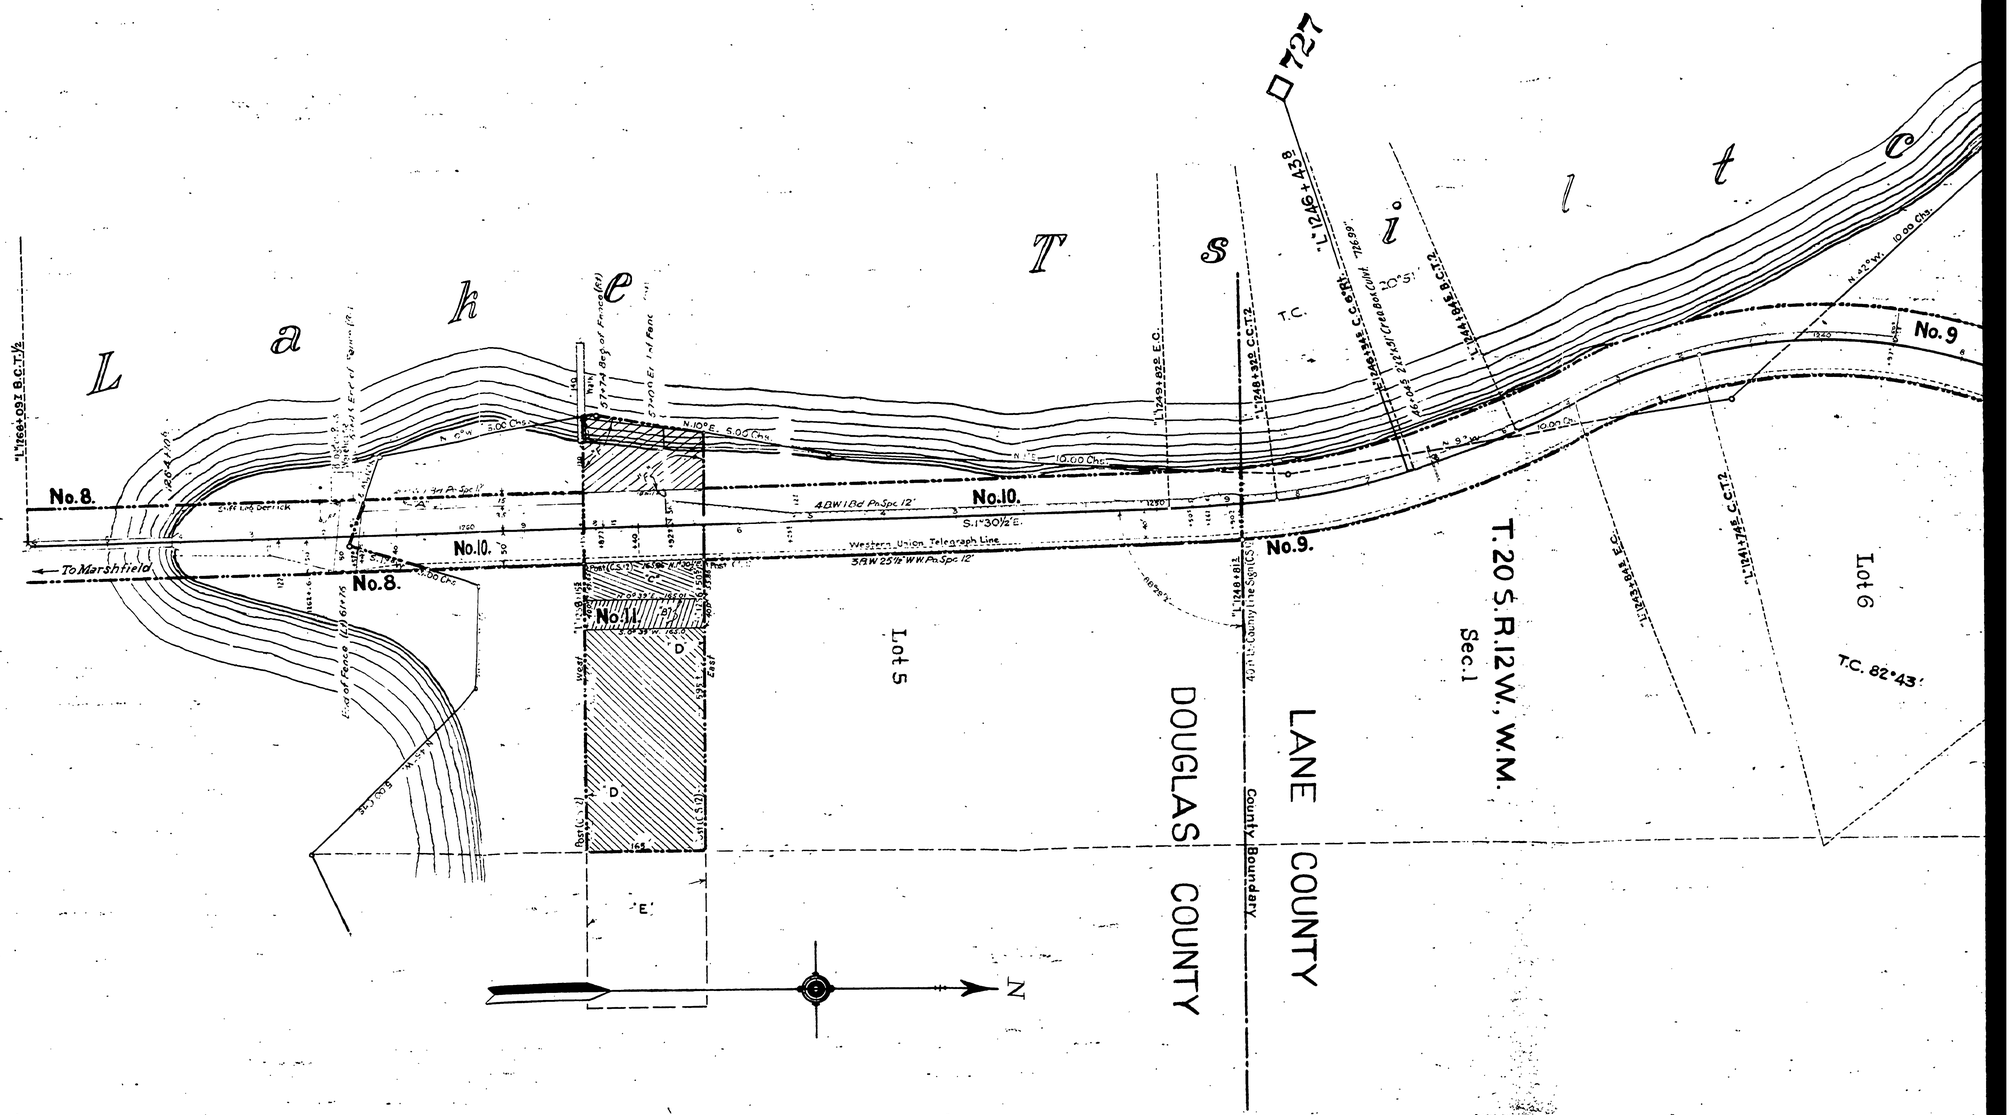

Sheet No. 5-21 ——— of the Coos Bay Branch of the Southern Pacific Company's Railroad
Portland Division, Oregon, from survey station "L" 1230+40± to survey station "L" 1266+09.7

Valuation Officer

60789

R727727