


Note 6: The 36.786 acs. previously shown in area col. have been deor. acc'd disp of as follows: 1.812 acs. by deed 20199, 203 acs. by deed

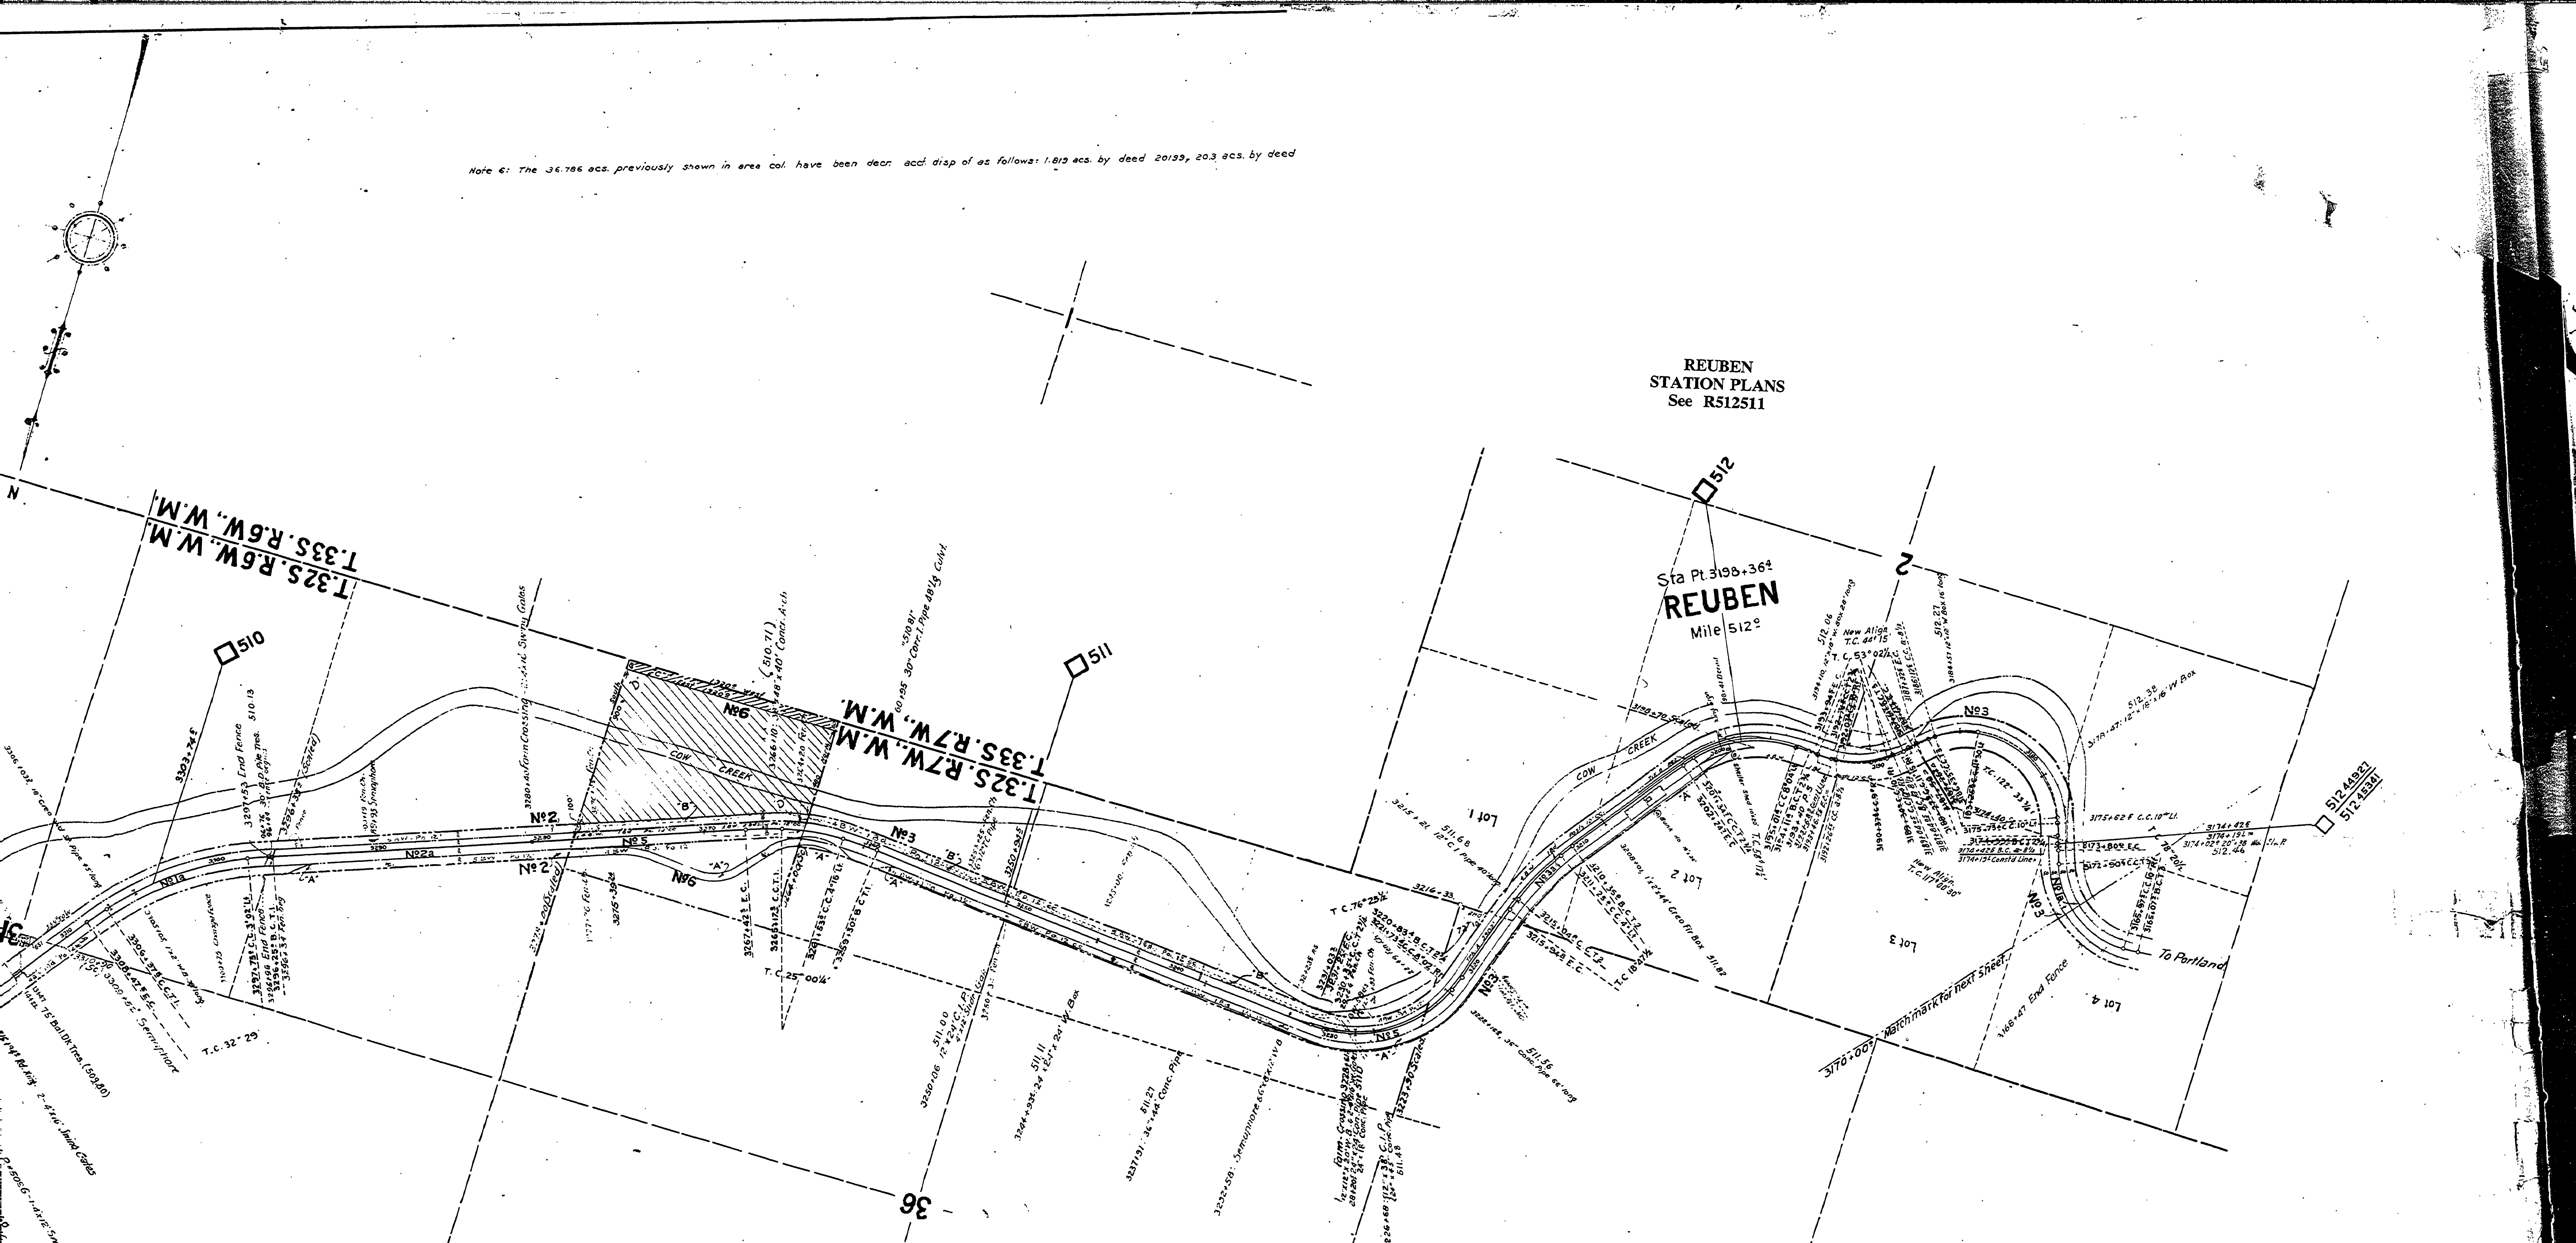

REUBEN  
STATION PLANS  
See R512511

Sta Pt. 3193+364  
**REUBEN**  
Mile 512°

**RIGHT OF WAY AND TRACK MAP**  
MAIN LINE  
**SOUTHERN PACIFIC COMPANY**  
OPERATED BY  
**SOUTHERN PACIFIC COMPANY**  
PORTLAND DIVISION, DOUGLAS COUNTY, OREGON  
FROM STATION 180+00 TO STATION 3170+00  
Scale: 1 inch = 400 feet

Sheet No. 21 of 55 of the Main Line of the Southern Pacific Company's Railroad,  
Portland Division, Oregon, from Survey Station 180+00 to Survey  
Station 3170+00.

Valuation Officer **35**

VALUATION DEPARTMENT  
SAN FRANCISCO, CALIFORNIA

V-16  
21