


WEST FORK
STATION PLANS
See R521522

Sta. Pt. 2684+80±
WEST FORK
Mile 521.7

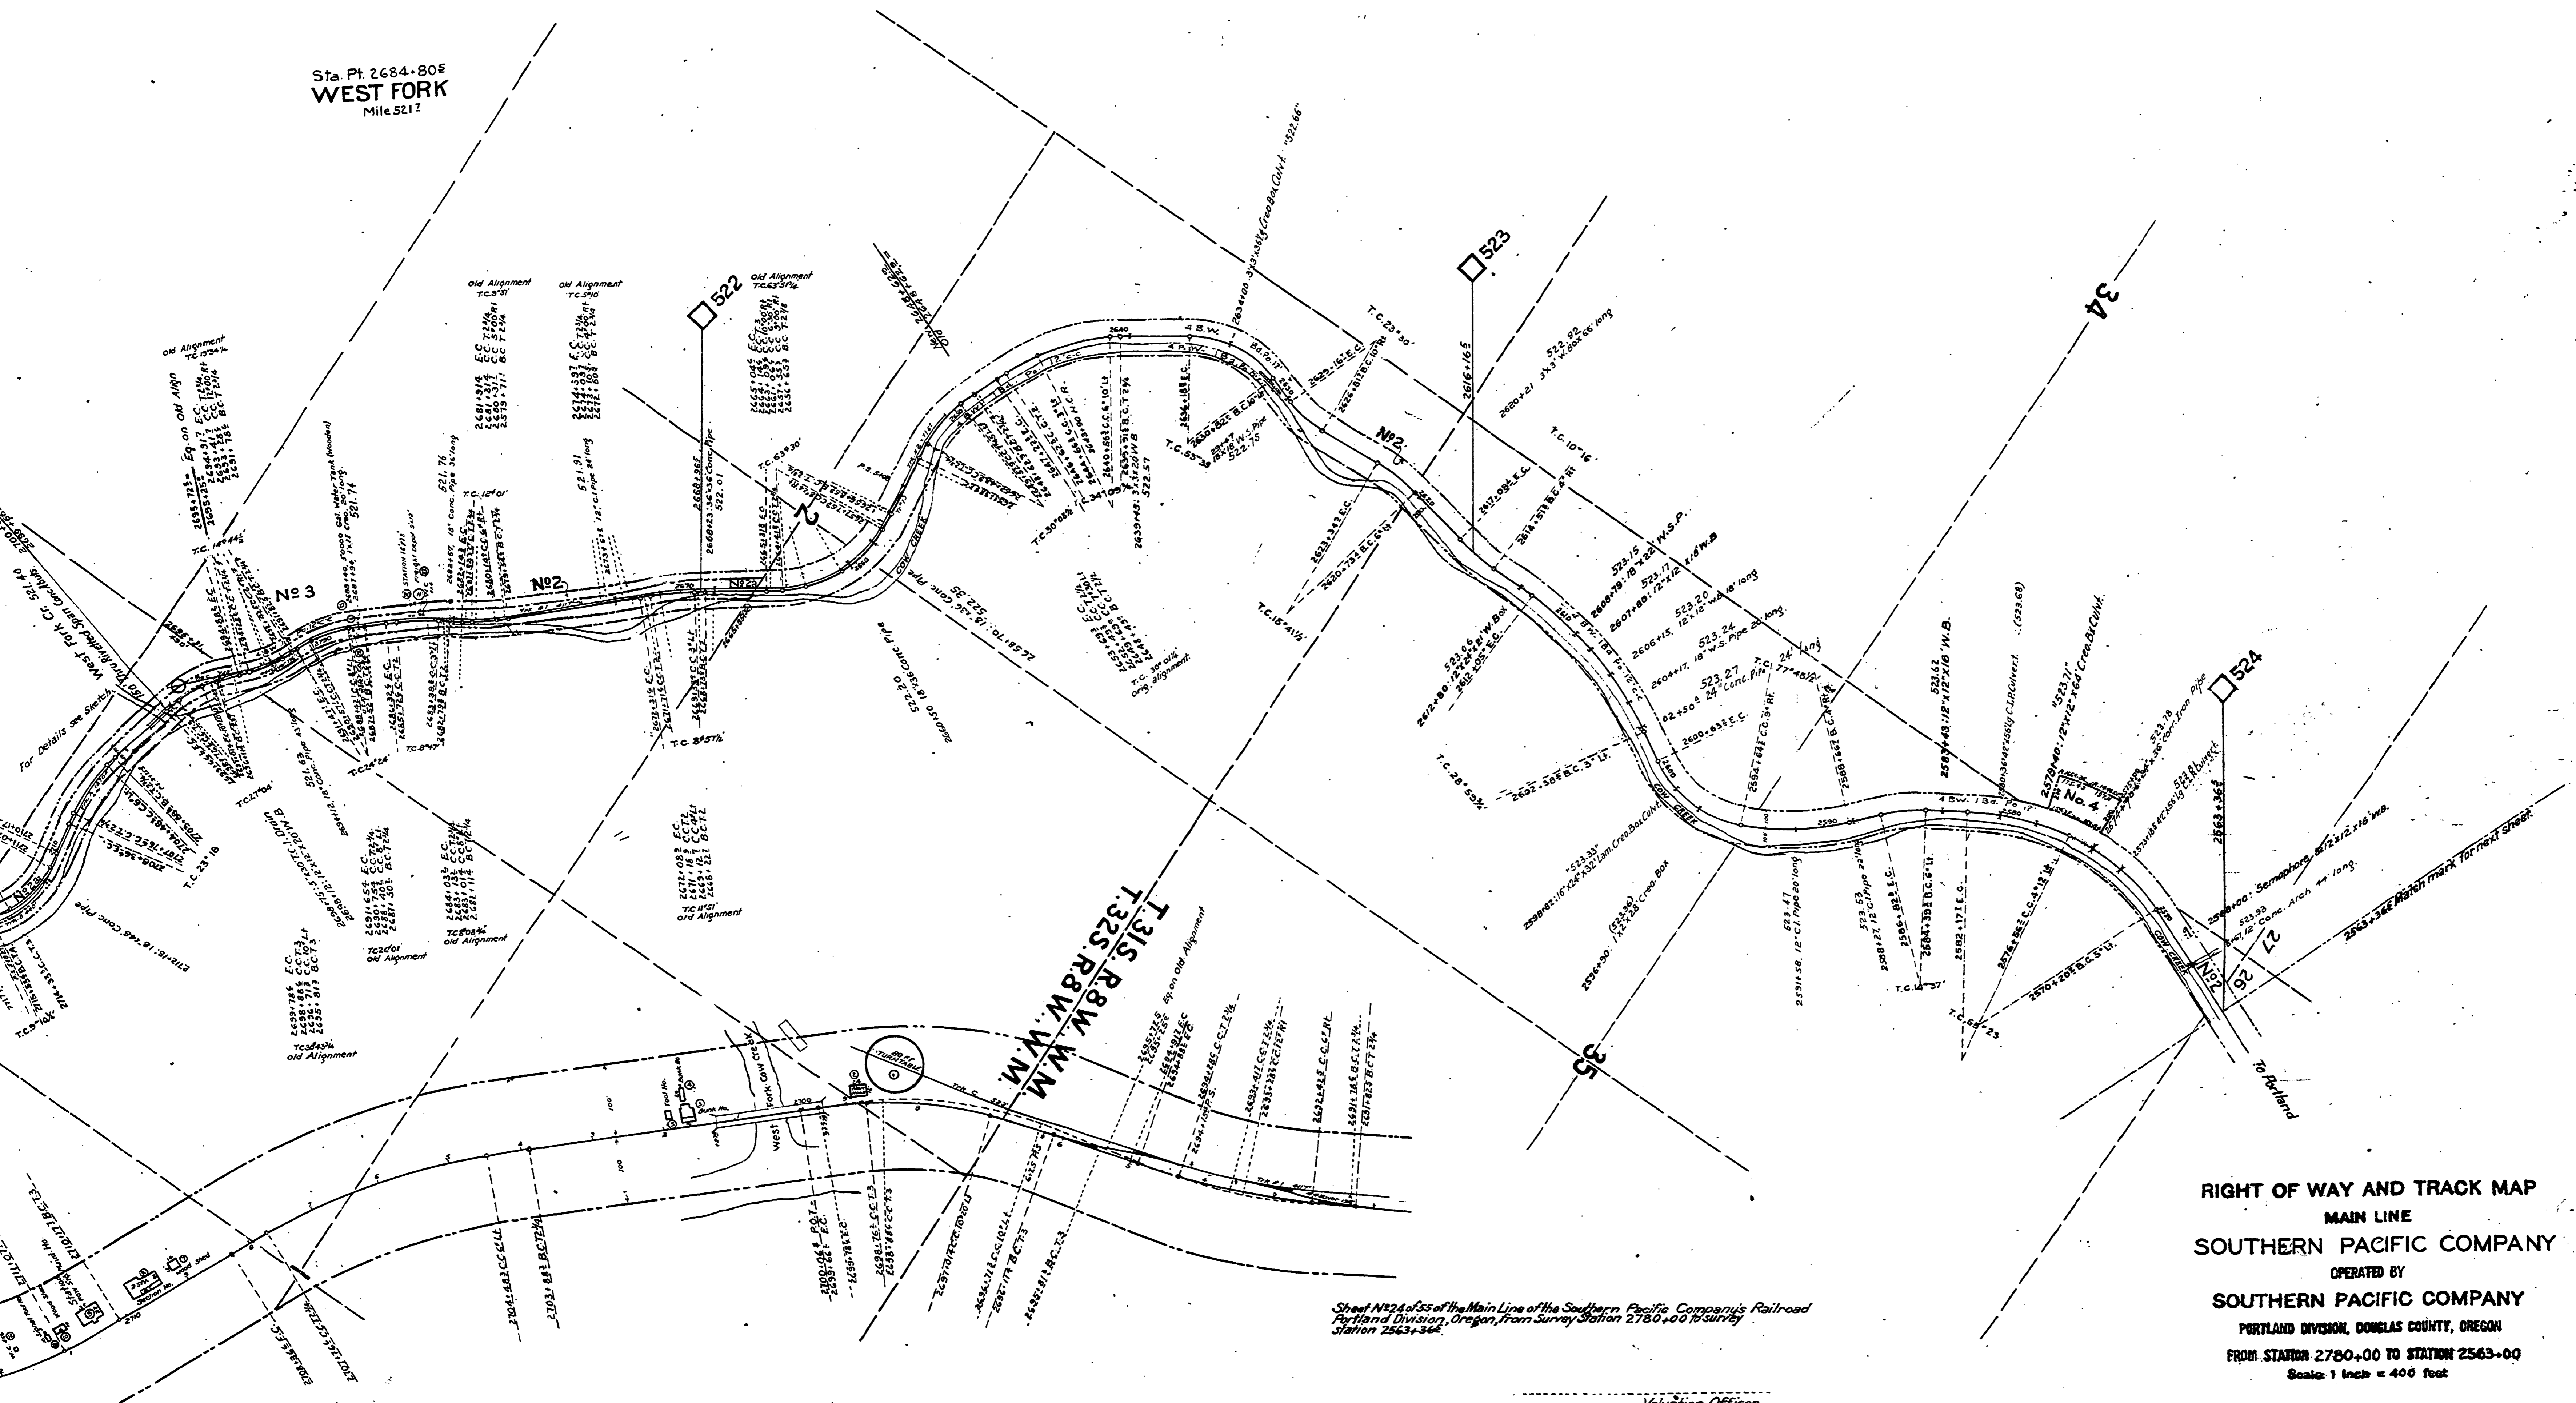

Sheet No. 24 of 55 of the Main Line of the Southern Pacific Company's Railroad
Portland Division, Oregon, from Survey Station 2780+00 to Survey
Station 2563+366.

Valuation Officer

RIGHT OF WAY AND TRACK MAP
MAIN LINE
SOUTHERN PACIFIC COMPANY
OPERATED BY
SOUTHERN PACIFIC COMPANY
FROM STATION 2780+00 TO STATION 2563+00
Scale: 1 inch = 400 feet

VALUATION DEPARTMENT
SAN FRANCISCO, CALIFORNIA

V16
24