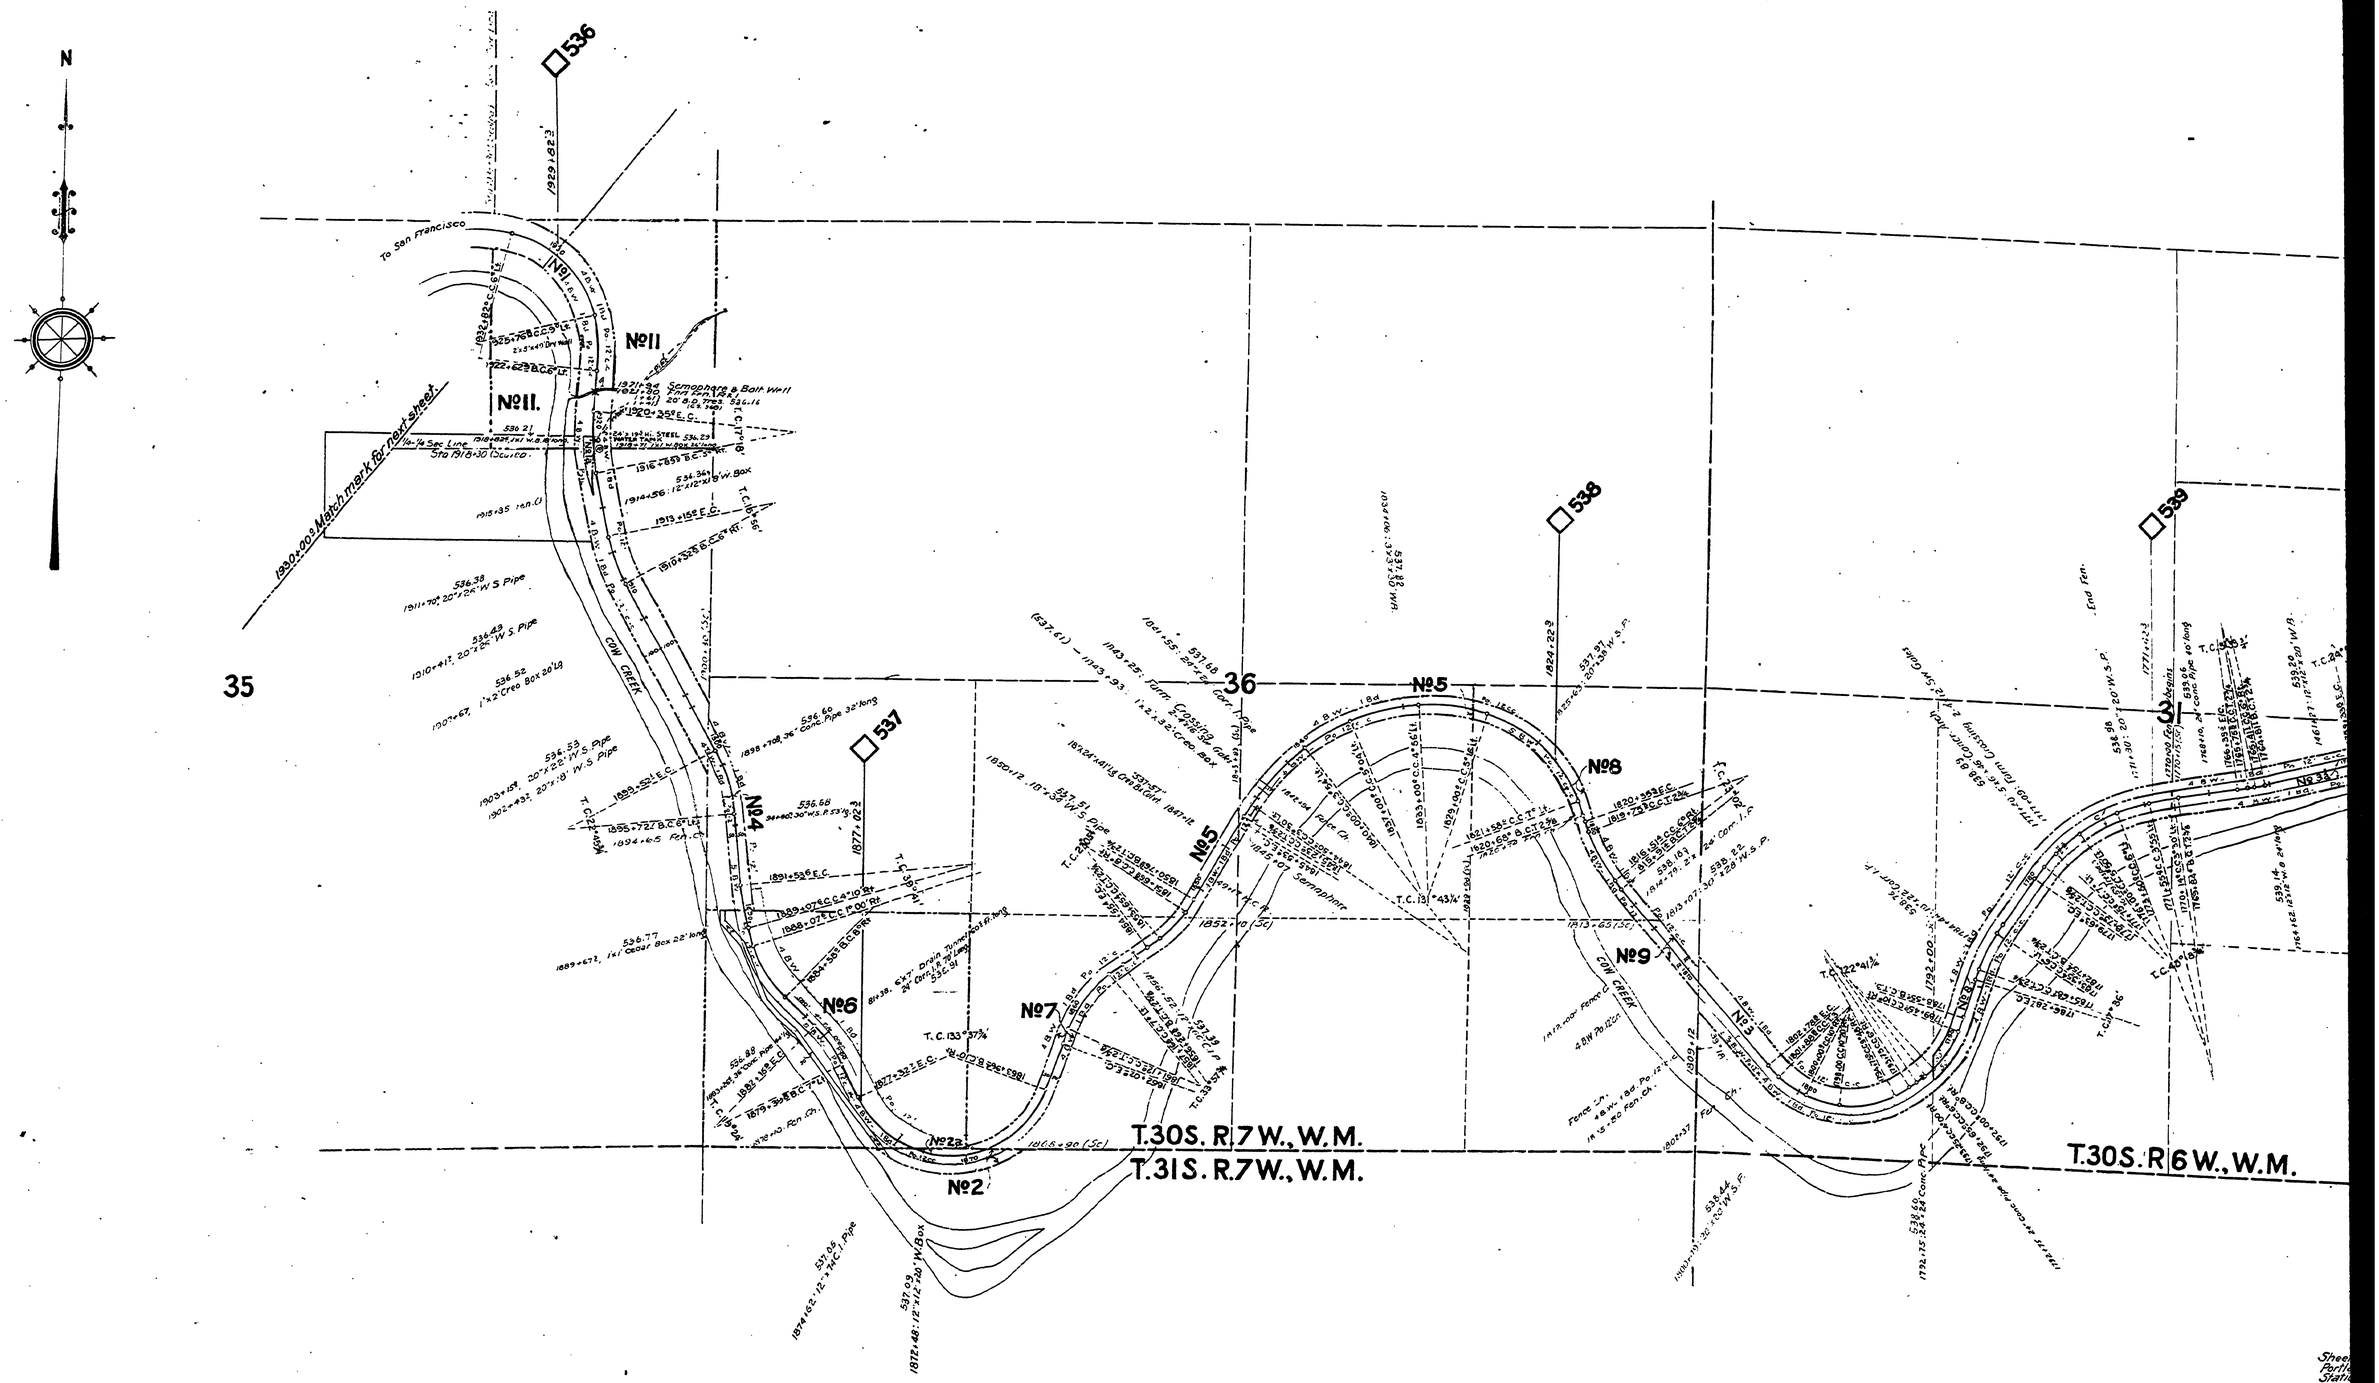
N
To San Francisco
Match mark for next sheet
COW CREEK
35
36
31
T.30S. R.7W., W.M.
T.31S. R.7W., W.M.
T.30S. R.6W., W.M.
№11
№11.
№4
№5
№6
№7
№8
№9
№2
536
537
538
539

60728
28