No	Grantor
1	W.H. Riddle et al
2	W.H. Hynott et ux.
3	Daniel Raymond
4	J.B. Nichols et ux.
5	Hugh Cornutt et ux
	J.B. Nichols et ux.
6	Glenbrook Land & Lbr. Co.

Note:- Oregon & California by B&S Deed Aud.

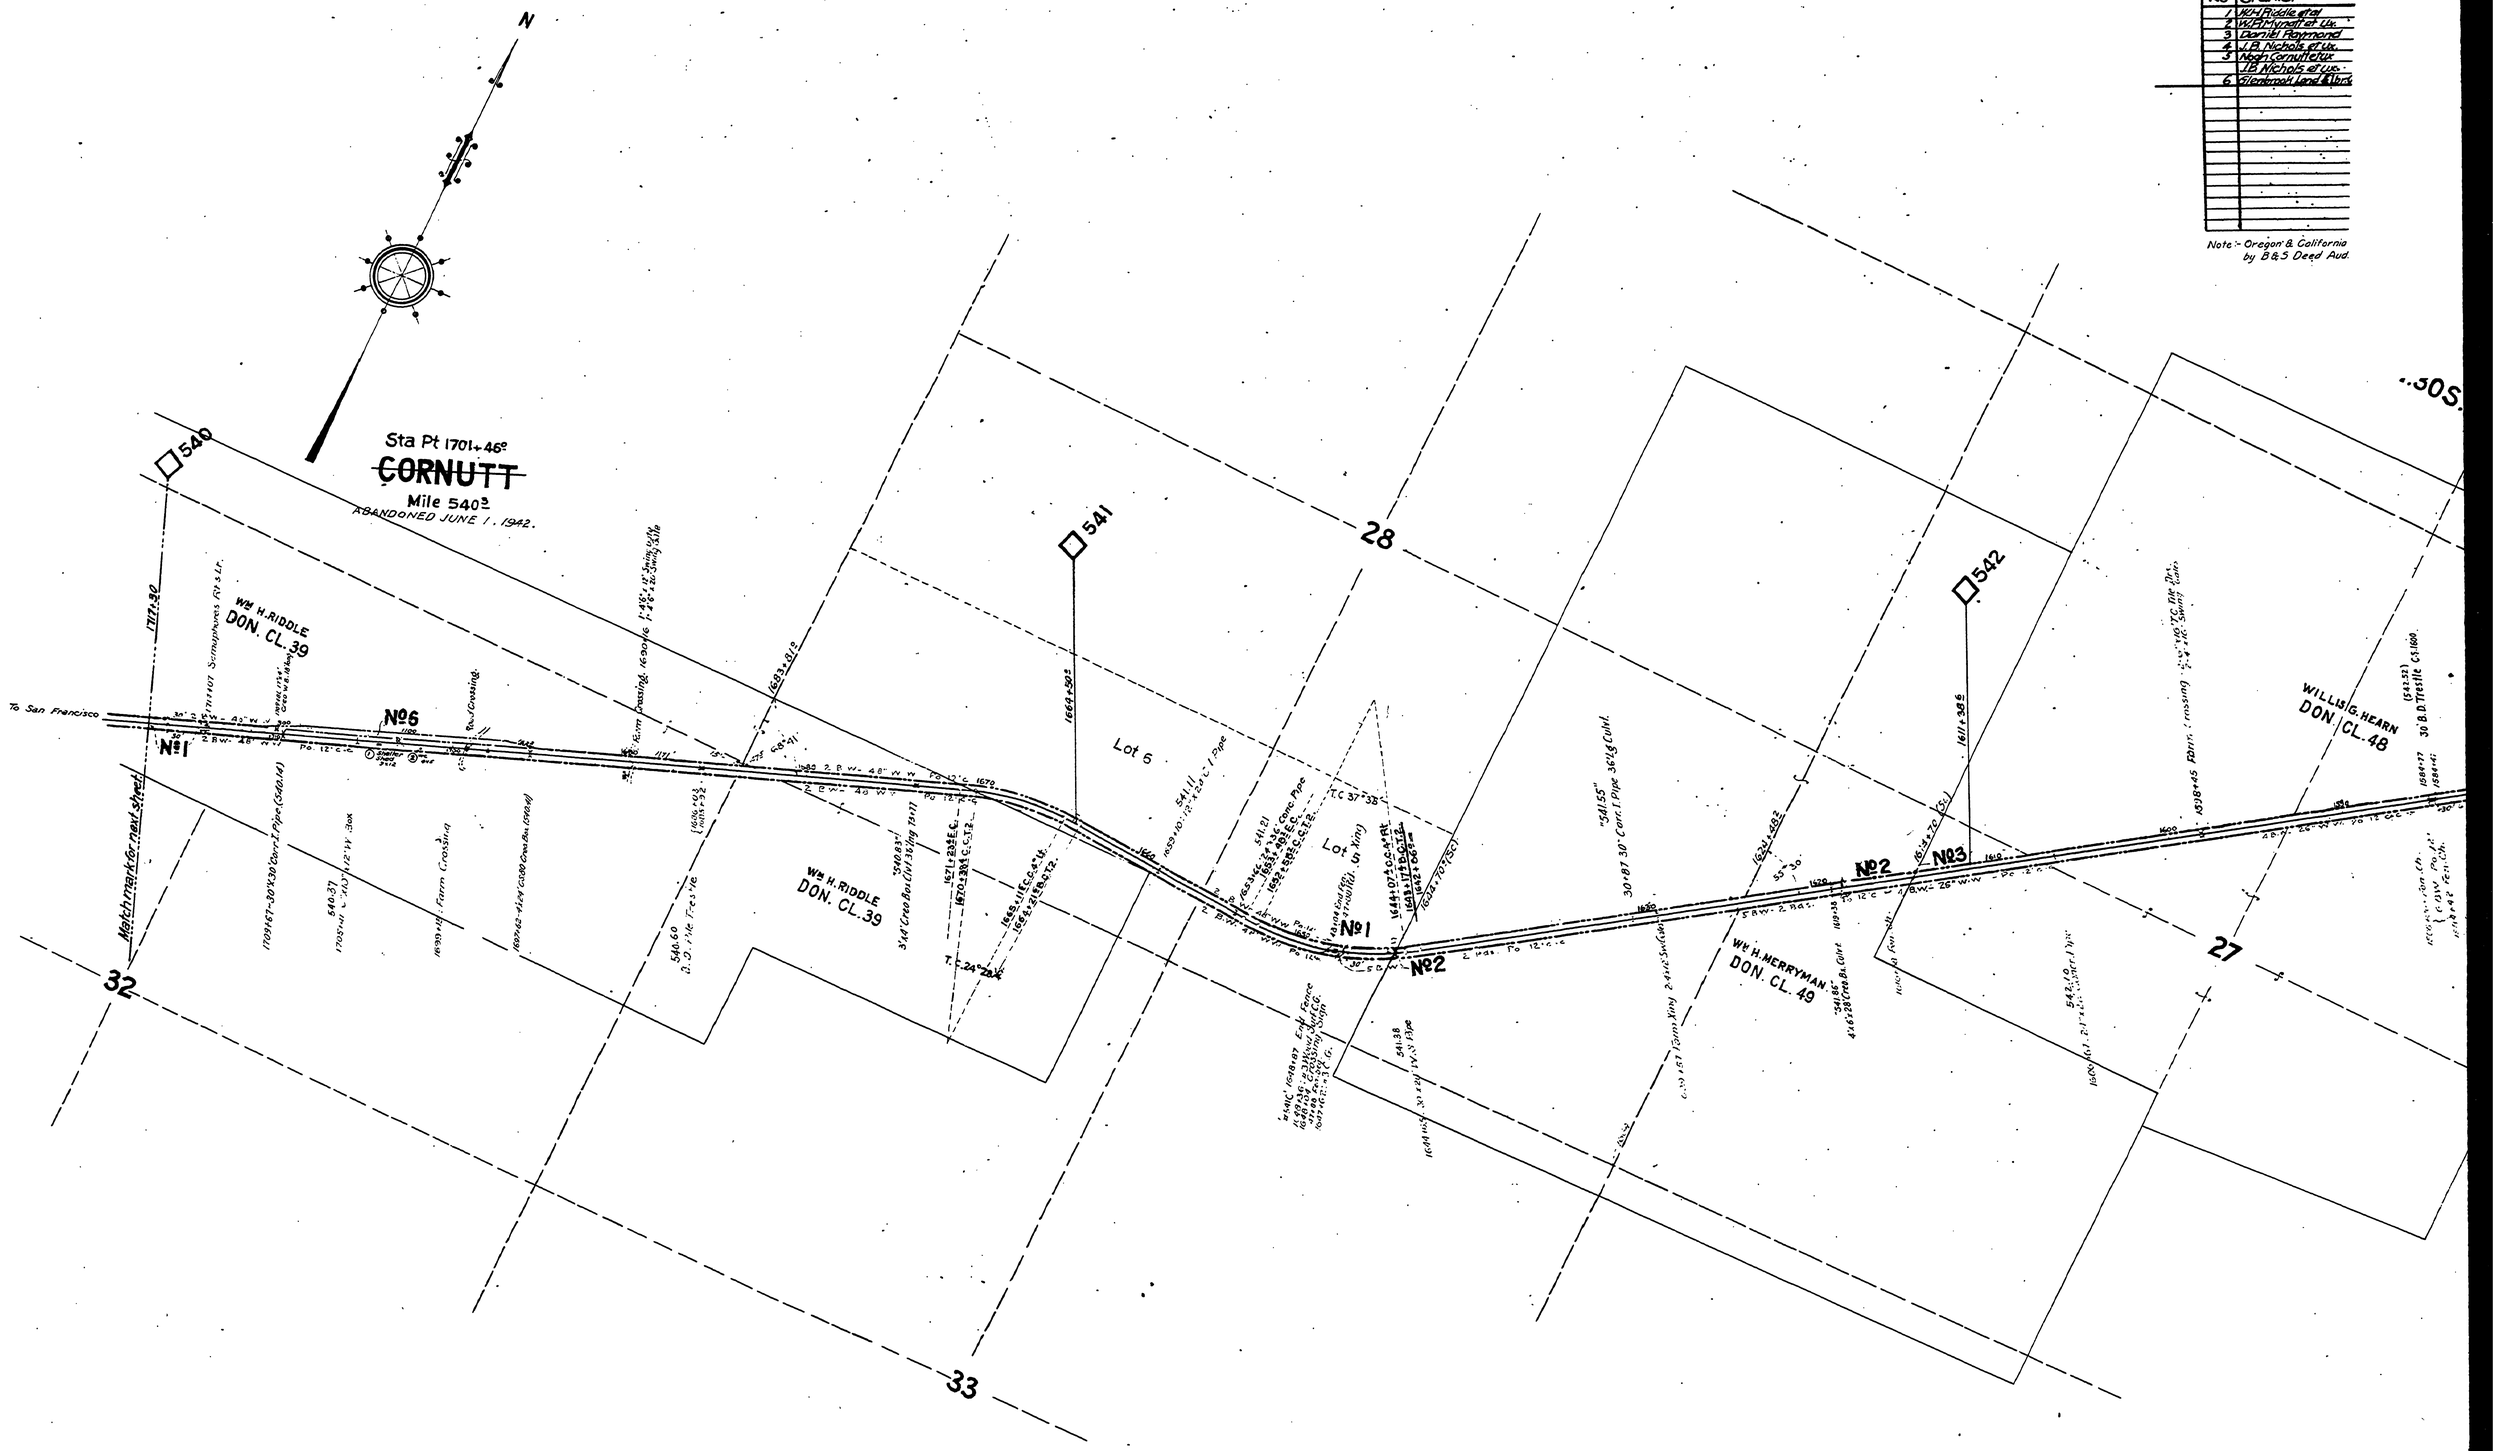
N
Sta Pt 1701+46°
CORNUTT
Mile 540.3
ABANDONED JUNE 1, 1942.
540
541
542
28
27
32
33
Lot 6
Lot 5
Wm H. RIDDLE
DON. CL. 39
WILLIS G. HEARN
DON. CL. 48
Wm H. HERRYMAN
DON. CL. 49
To San Francisco
Nº1
Nº2
Nº3
Nº6
Farm Crossing
Road Crossing
Match mark for next sheet
30 B.D. Trestle
30'x87 30" Conc. Pipe 36'x8 Culv.
