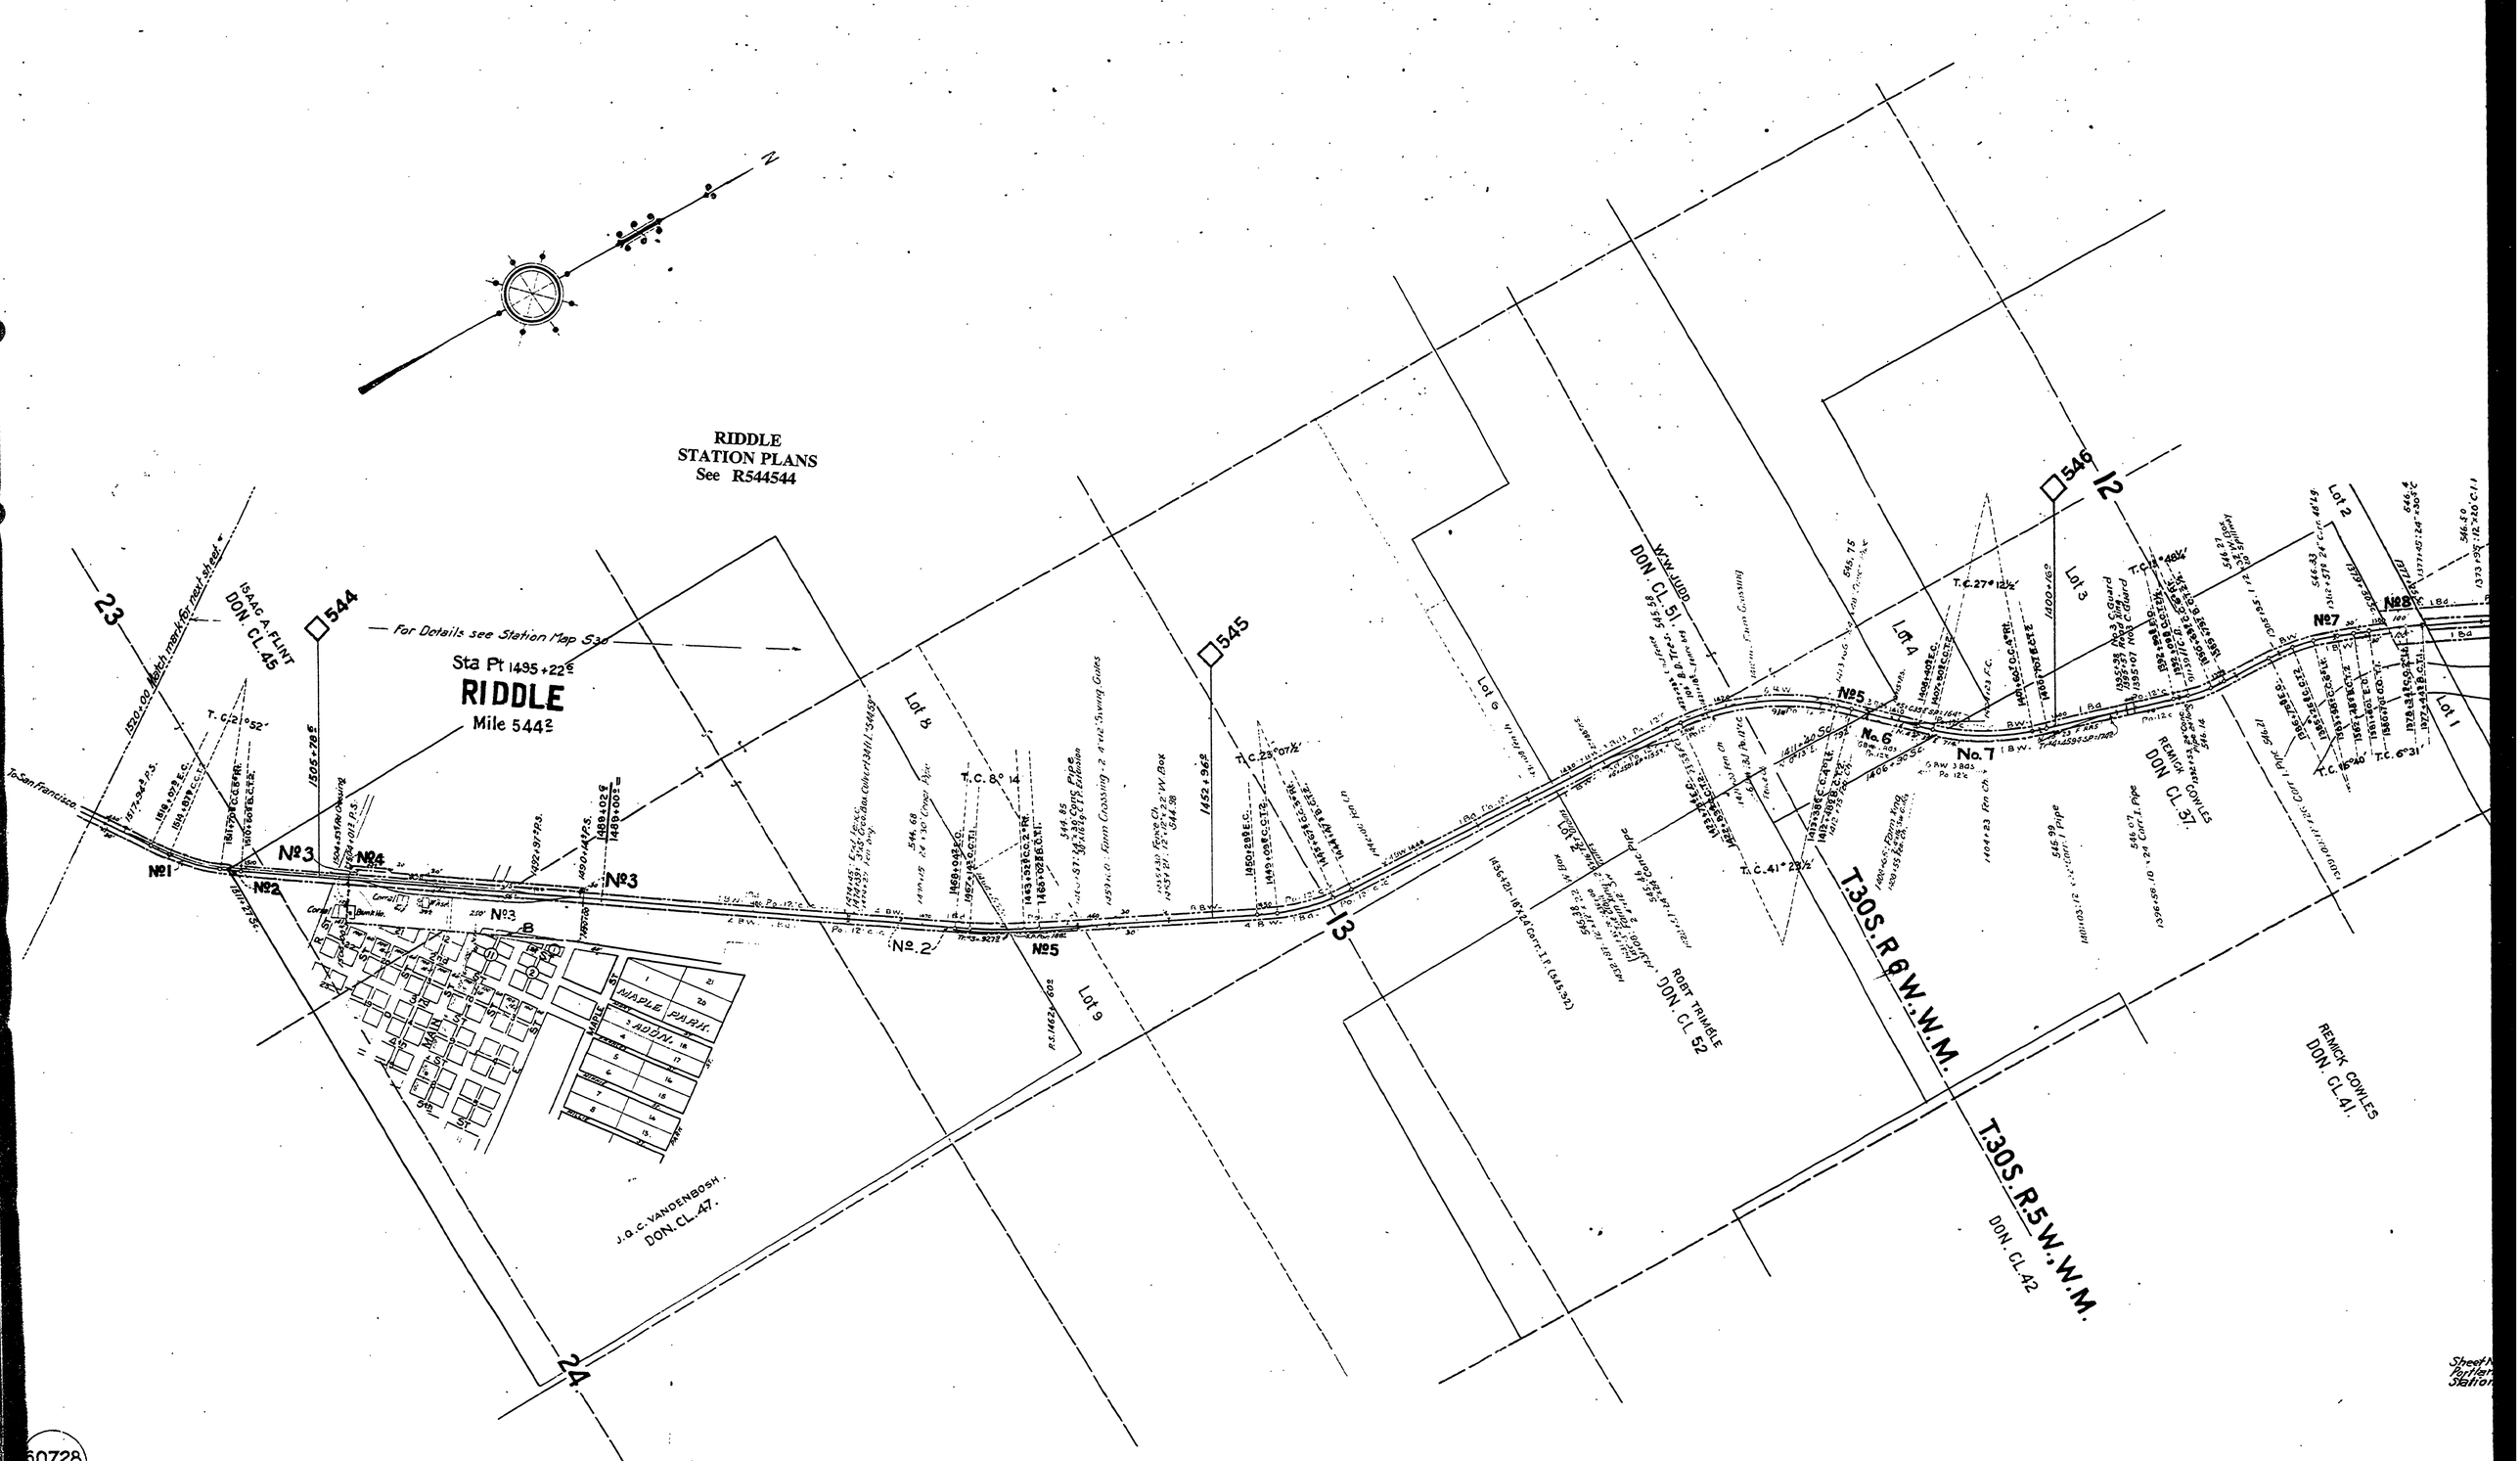
RIDDLE
STATION PLANS
See R544544
For Details see Station Map S30
Sta Pt 1495+22
RIDDLE
Mile 544
Match mark for next sheet
ISAAC A. FLINT
DON. CL. 45
To San Francisco
544
545
546
23
24
12
13
Lot 8
Lot 9
Lot 6
Lot 4
Lot 3
Lot 2
Lot 1
DON. CL. 51.
ROBT TRIMBLE
DON. CL. 52
REMICK COWLES
DON. CL. 37.
REMICK COWLES
DON. CL. 41.
T.30S. R.6 W.W.M.
T.30S. R.5 W.W.M.
DON. CL. 42
J. & C. VANDENBOSH.
DON. CL. 47.
MAPLE PARK.
ADDN.
MAIN
No. 6
No. 7
60728
30