

T28S.R6W.W.M.
T29S.R6W.W.M.


RIVER

W. M. DILLARD
DON. CL. 716

M. C. M. CLOUD
DON. CL. 41

ROBT PHIPPS
DON. CL. 42

ROBT PHIPPS
DON. CL. 37

Sta Pt 555 + 942
DILLARD
Mile 562.2

DILLARD
STATION PLANS
See R561562

STATION ST.

DILLARD'S
DILLARD


MAIN ST.

FRONT ST.

OREGON

Scale 1" = 200'

M. BELLEU
DON. CL.

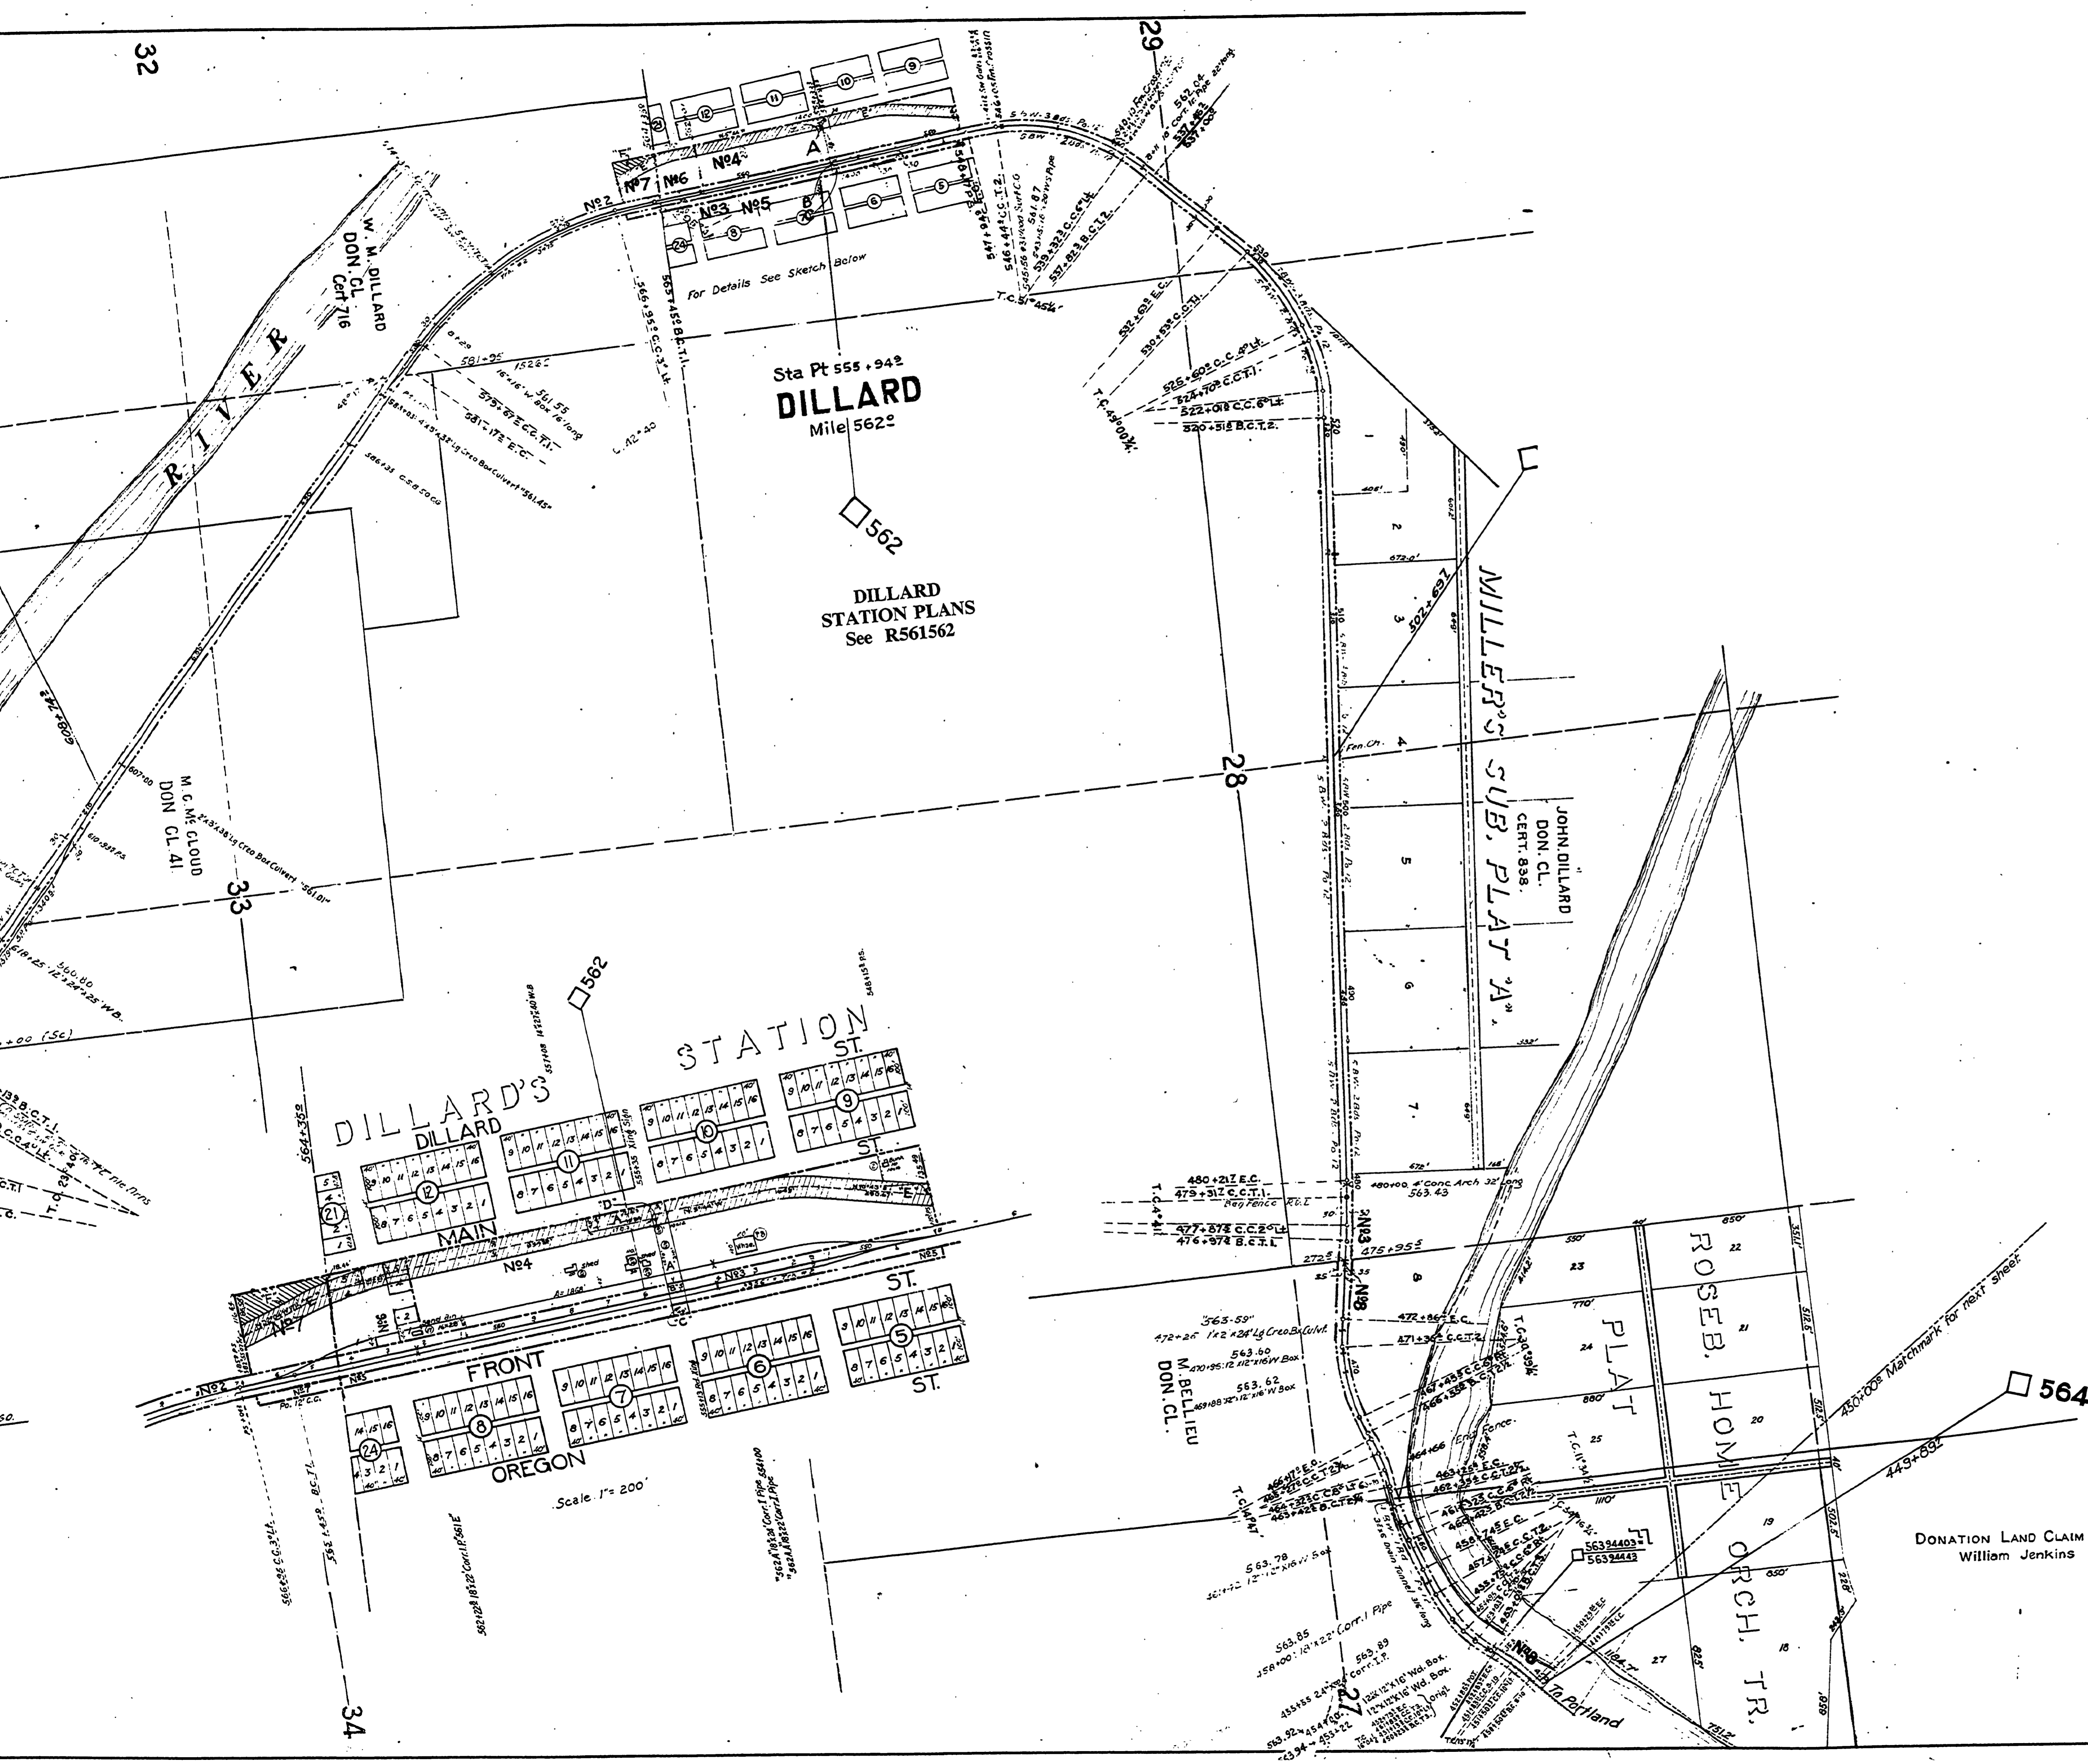

Sheet No. 34 of 55 of the Main Line of the Southern Pacific Company's Railroad Portland Division, Oregon, from Survey Station 661+54.2 to Survey Station 450+00.2

Valuation Officer

RIGHT OF WAY AND TRACK MAP
 MAIN LINE
 SOUTHERN PACIFIC COMPANY
 OPERATED BY
 SOUTHERN PACIFIC COMPANY
 PORTLAND DIVISION, DOUGLAS COUNTY, OREGON
 FROM STATION 661,542 TO STATION 450-00
 Scale: 1 inch = 400 feet
 VALUATION DEPARTMENT
 SAN FRANCISCO, CALIFORNIA