

Sta. Pt. 101+53 E
OAKS
Mile 570.6


Sta. Pt. 164+89
SHADY
Mile 569+

T27S. R6 W. 1/4 M.M.
T28S. R6 W. 1/4 M.M.

Wm. C. WAGNER.


OAKS
STATION PLANS
See R570571

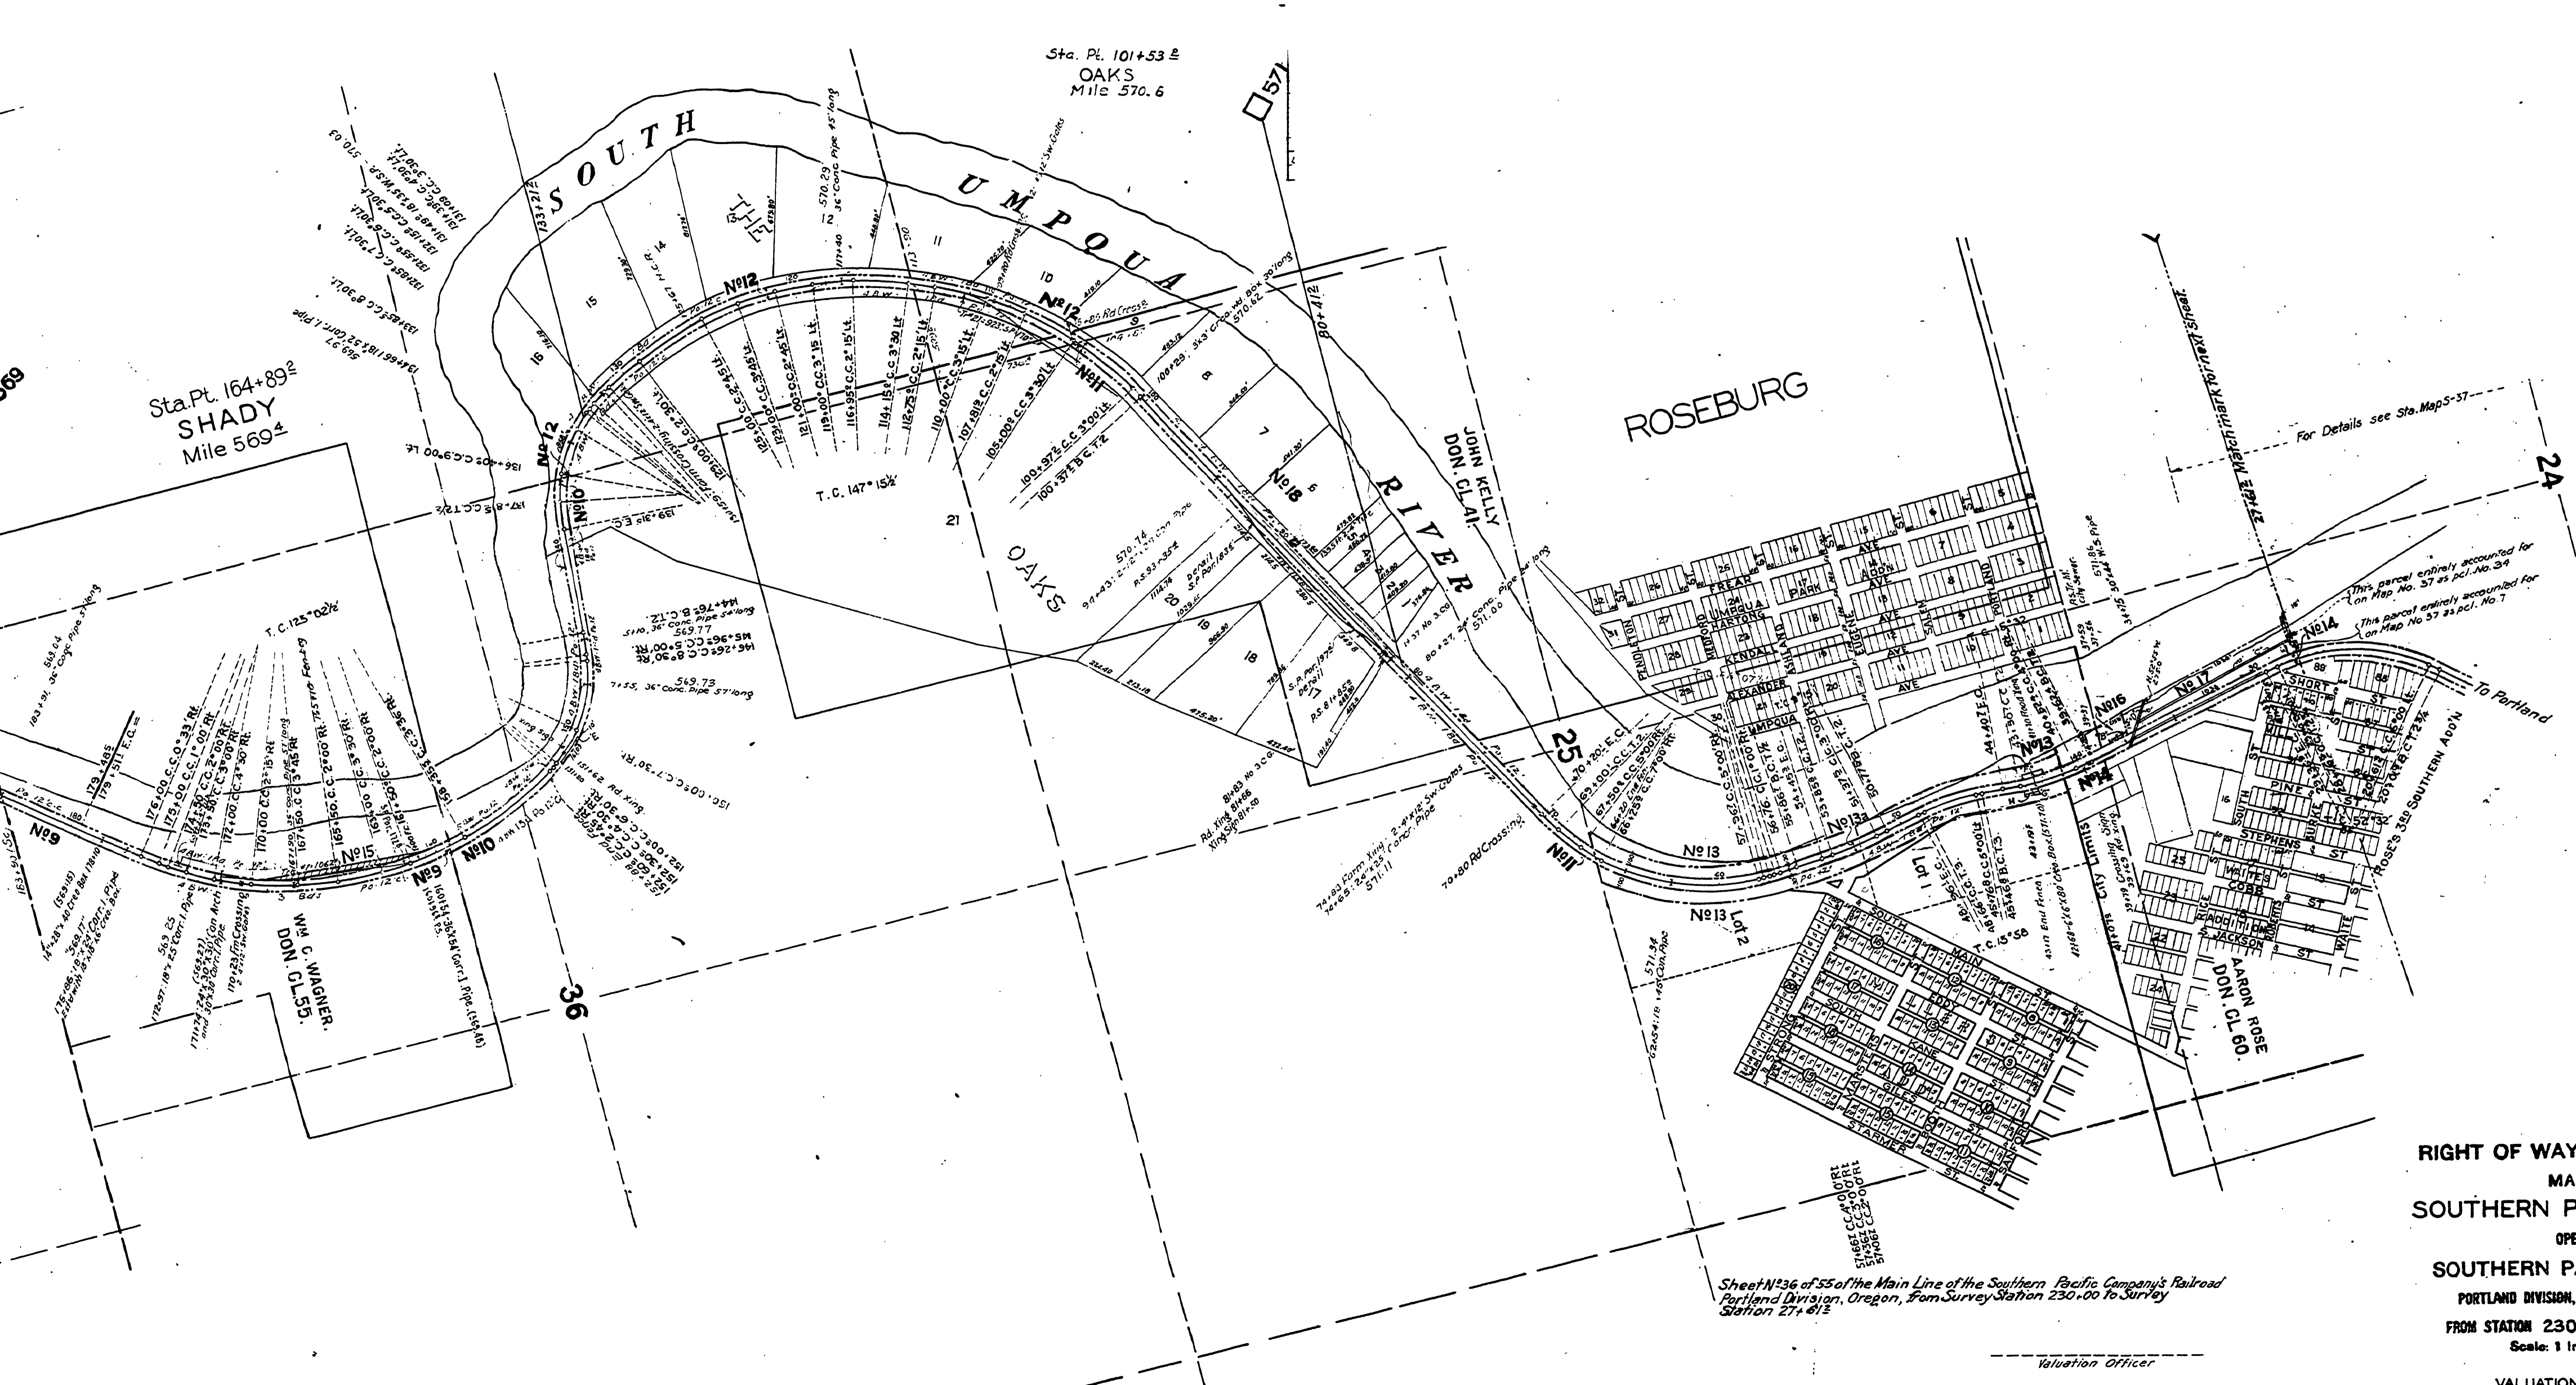

RIGHT OF WAY AND TRACK MAP
MAIN LINE
SOUTHERN PACIFIC COMPANY
OPERATED BY
SOUTHERN PACIFIC COMPANY
PORTLAND DIVISION, DOUGLAS COUNTY, OREGON
FROM STATION 230+00 TO STATION 27+61.2
Scale: 1 Inch = 400 feet
VALUATION DEPARTMENT
SAN FRANCISCO, CALIFORNIA

Sheet No. 36 of 55 of the Main Line of the Southern Pacific Company's Railroad
Portland Division, Oregon, from Survey Station 230+00 to Survey
Station 27+61.2

Valuation Officer