


OAKS
STATION PLANS
See R570571

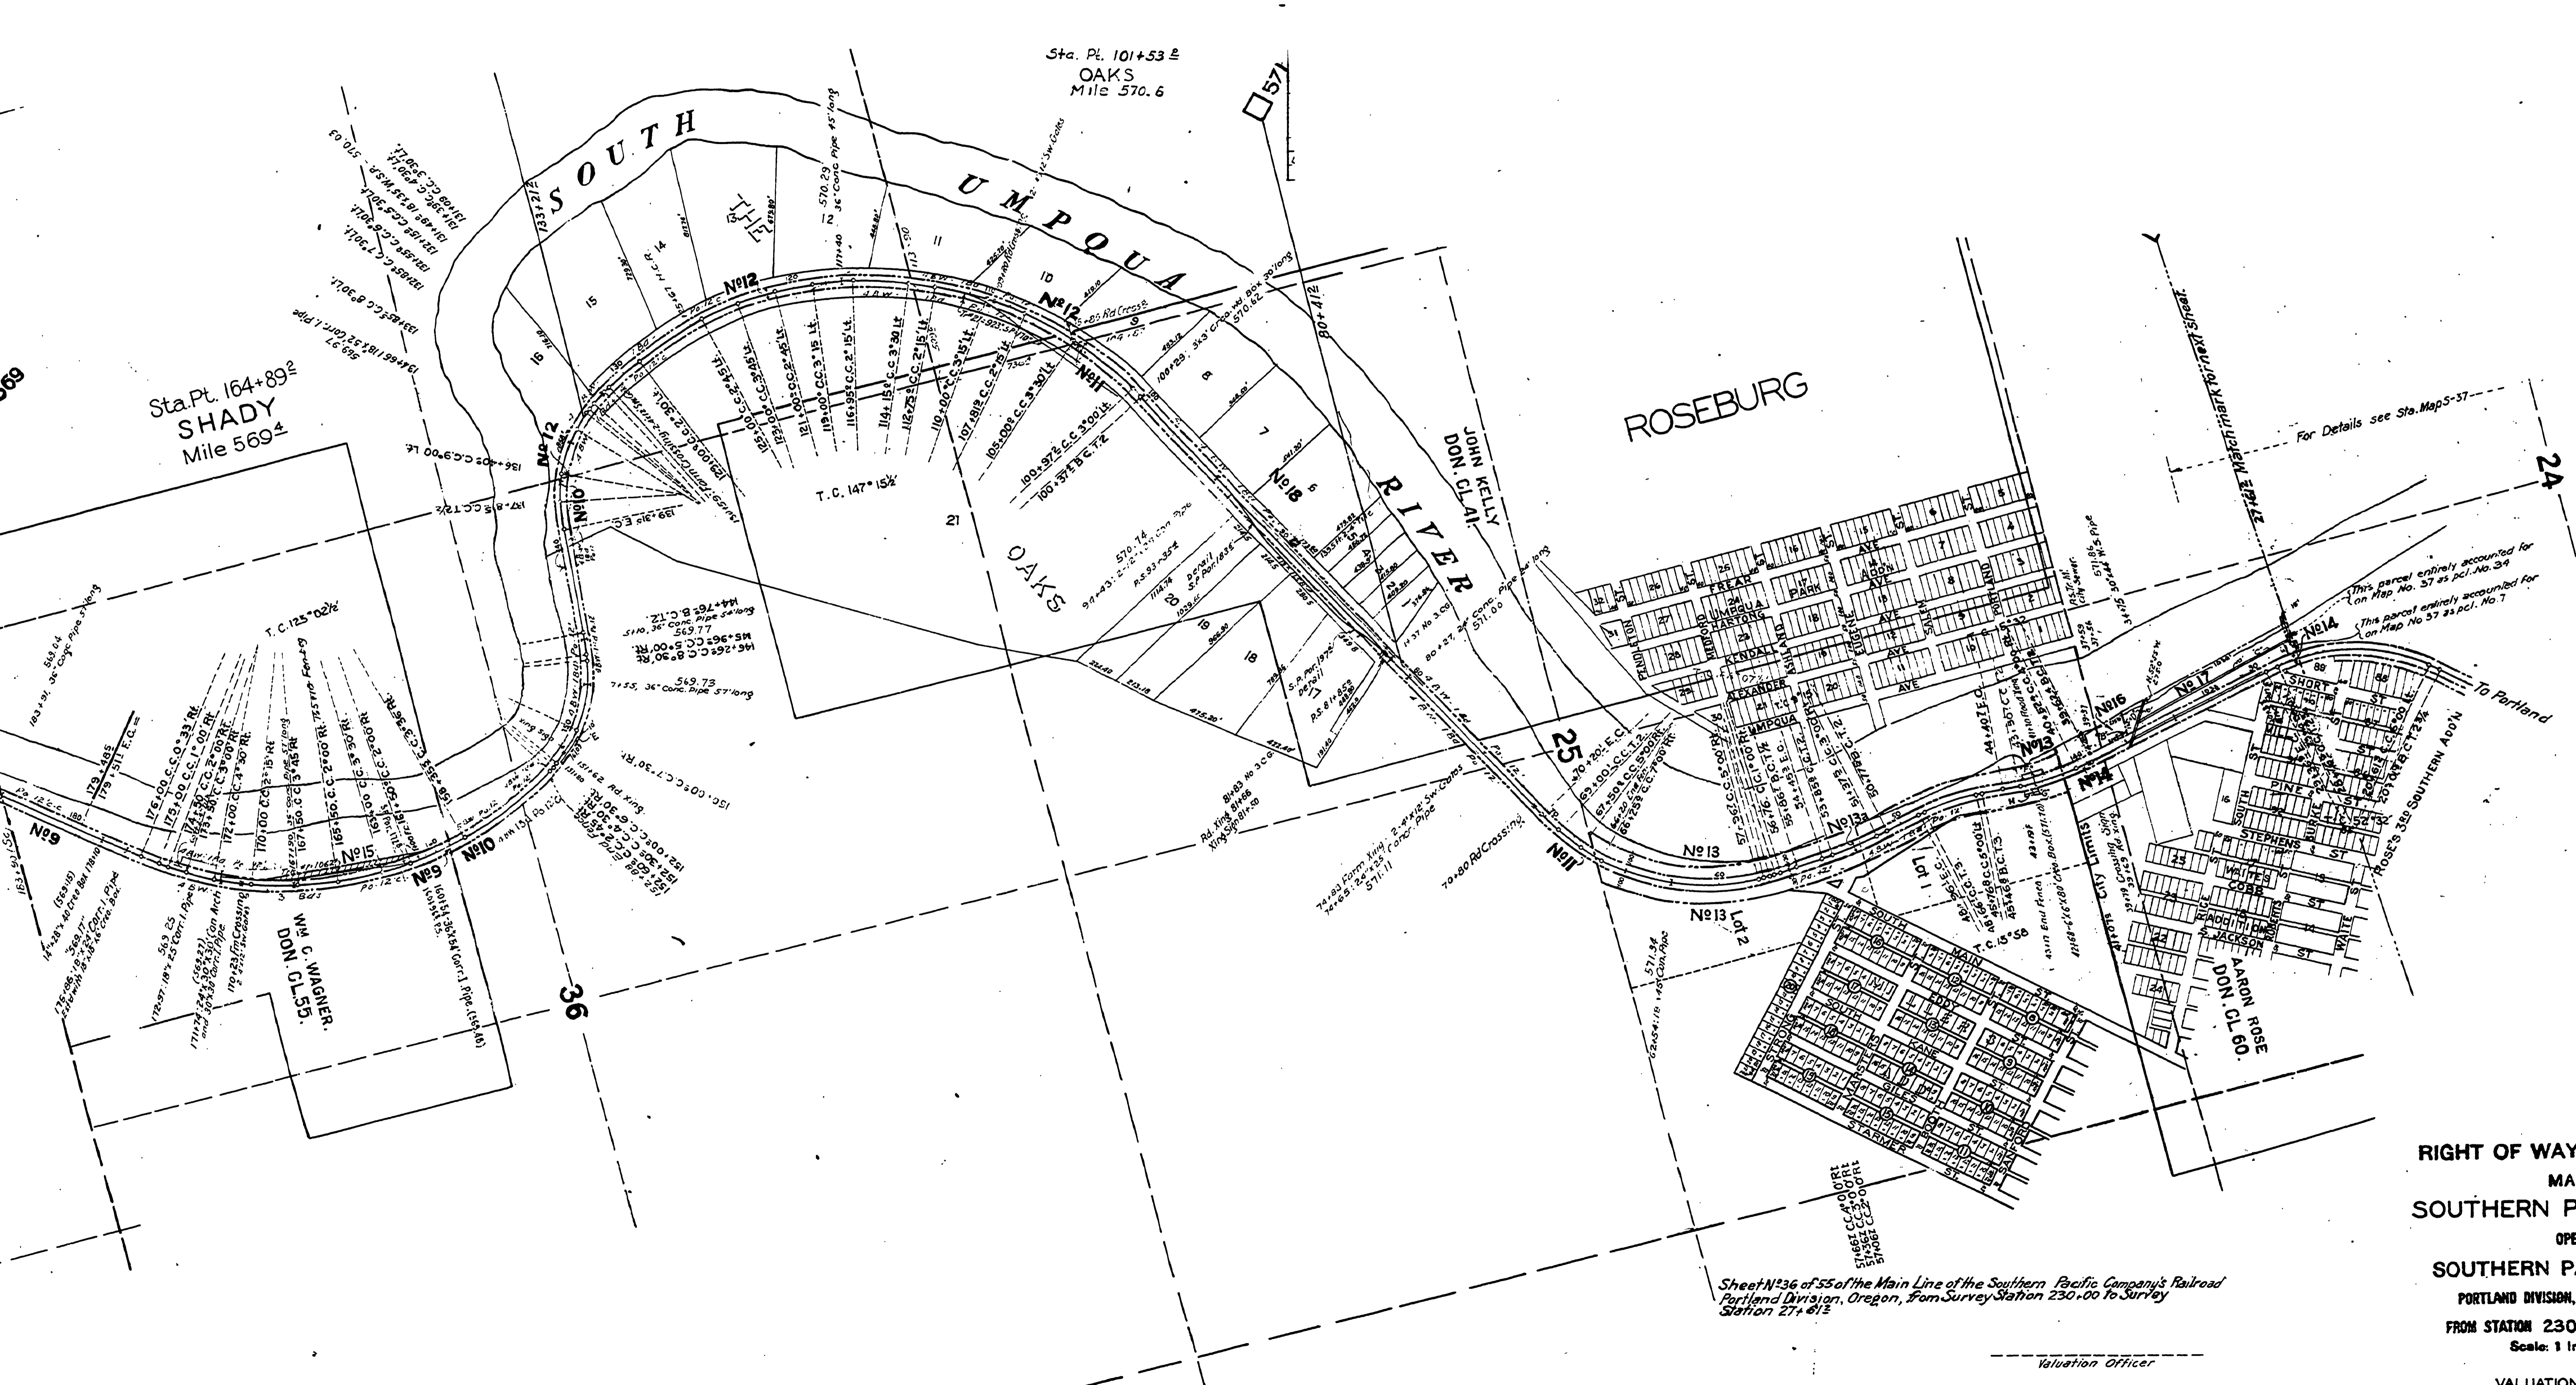

Sheet No. 36 of 55 of the Main Line of the Southern Pacific Company's Railroad
Portland Division, Oregon, from Survey Station 230+00 to Survey
Station 277+61.5

Valuation Officer

RIGHT OF WAY AND TRACK MAP
MAIN LINE
SOUTHERN PACIFIC COMPANY
OPERATED BY
SOUTHERN PACIFIC COMPANY
PORTLAND DIVISION, DOUGLAS COUNTY, OREGON
FROM STATION 230+00 TO STATION 27+61.2
Scale: 1 Inch = 400 feet
VALUATION DEPARTMENT
SAN FRANCISCO, CALIFORNIA