WILBUR
STATION PLANS
See R581581

REDBELL
STATION PLANS
See R582583

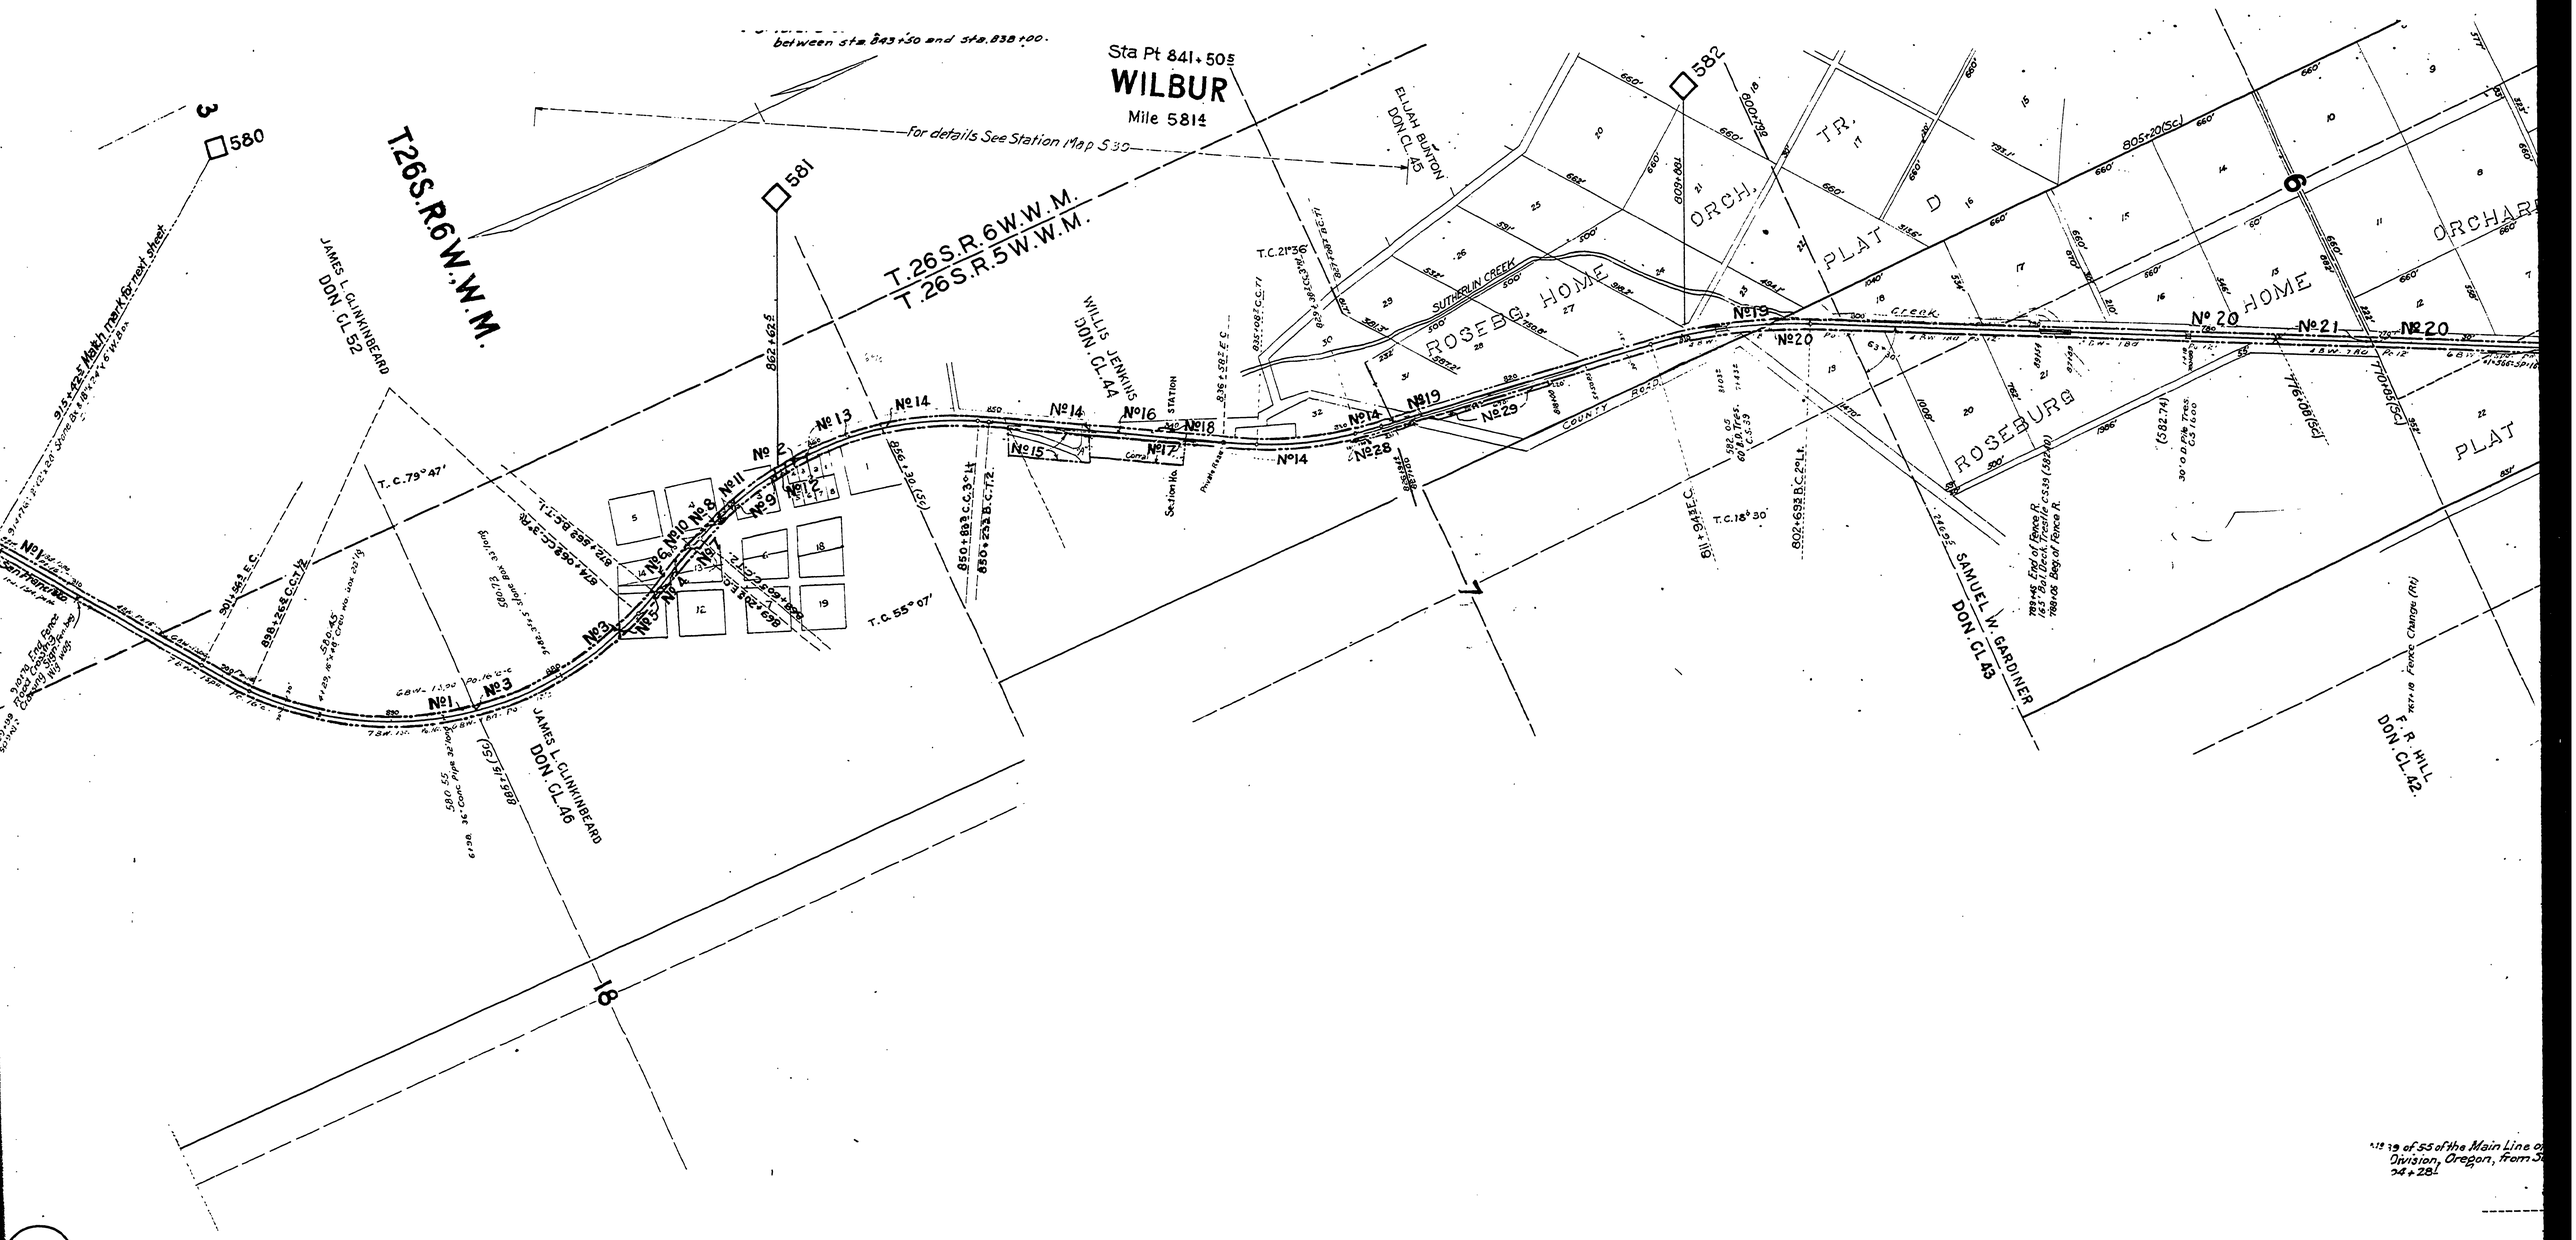

60728
39