


Note No 3 The 10.27 acs. previously shown in area cal have been decreased, acct diap of as follows: 122 acs by deed 20144.

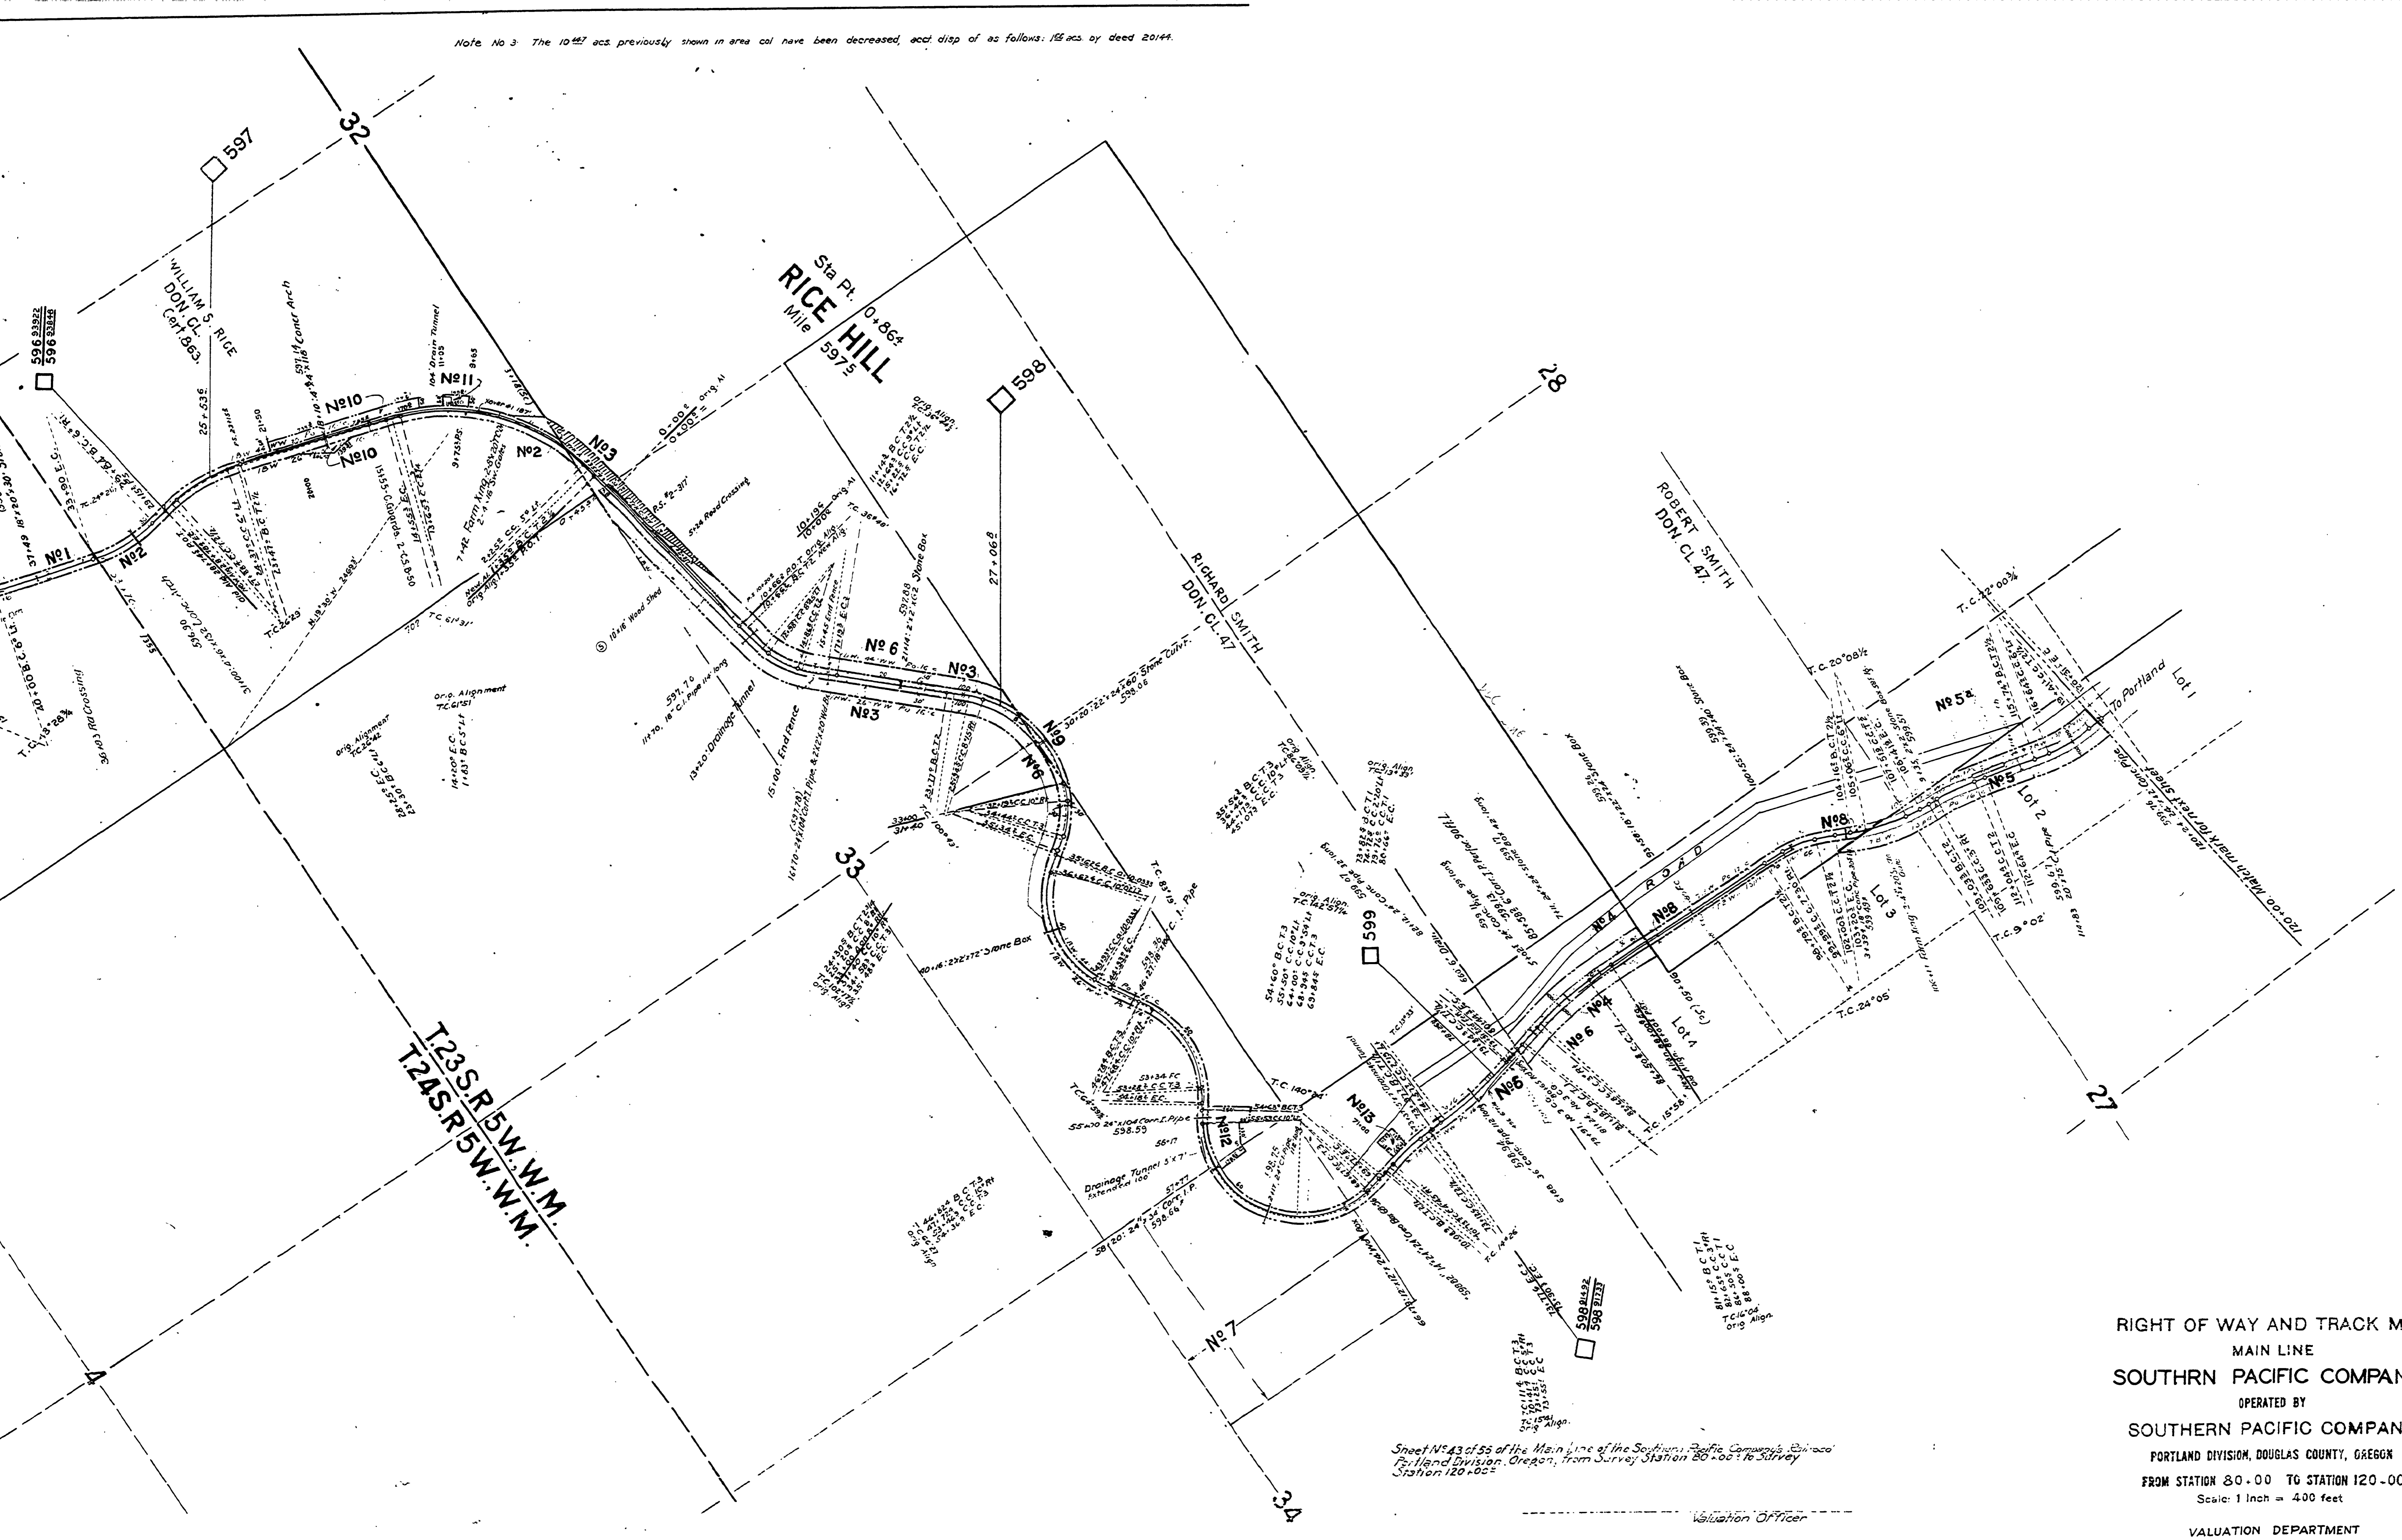

T23S.R5W.W.M.  
T24S.R5W.W.M.

Sheet No 43 of 53 of the Main Line of the Southern Pacific Company's Railroad  
Portland Division, Oregon, from Survey Station 80+00 to Survey  
Station 120+00

Valuation Officer

RIGHT OF WAY AND TRACK MAP  
MAIN LINE  
SOUTHERN PACIFIC COMPANY  
OPERATED BY  
SOUTHERN PACIFIC COMPANY  
PORTLAND DIVISION, DOUGLAS COUNTY, OREGON  
FROM STATION 80+00 TO STATION 120+00  
Scale: 1 Inch = 400 feet  
VALUATION DEPARTMENT  
SAN FRANCISCO, CALIFORNIA