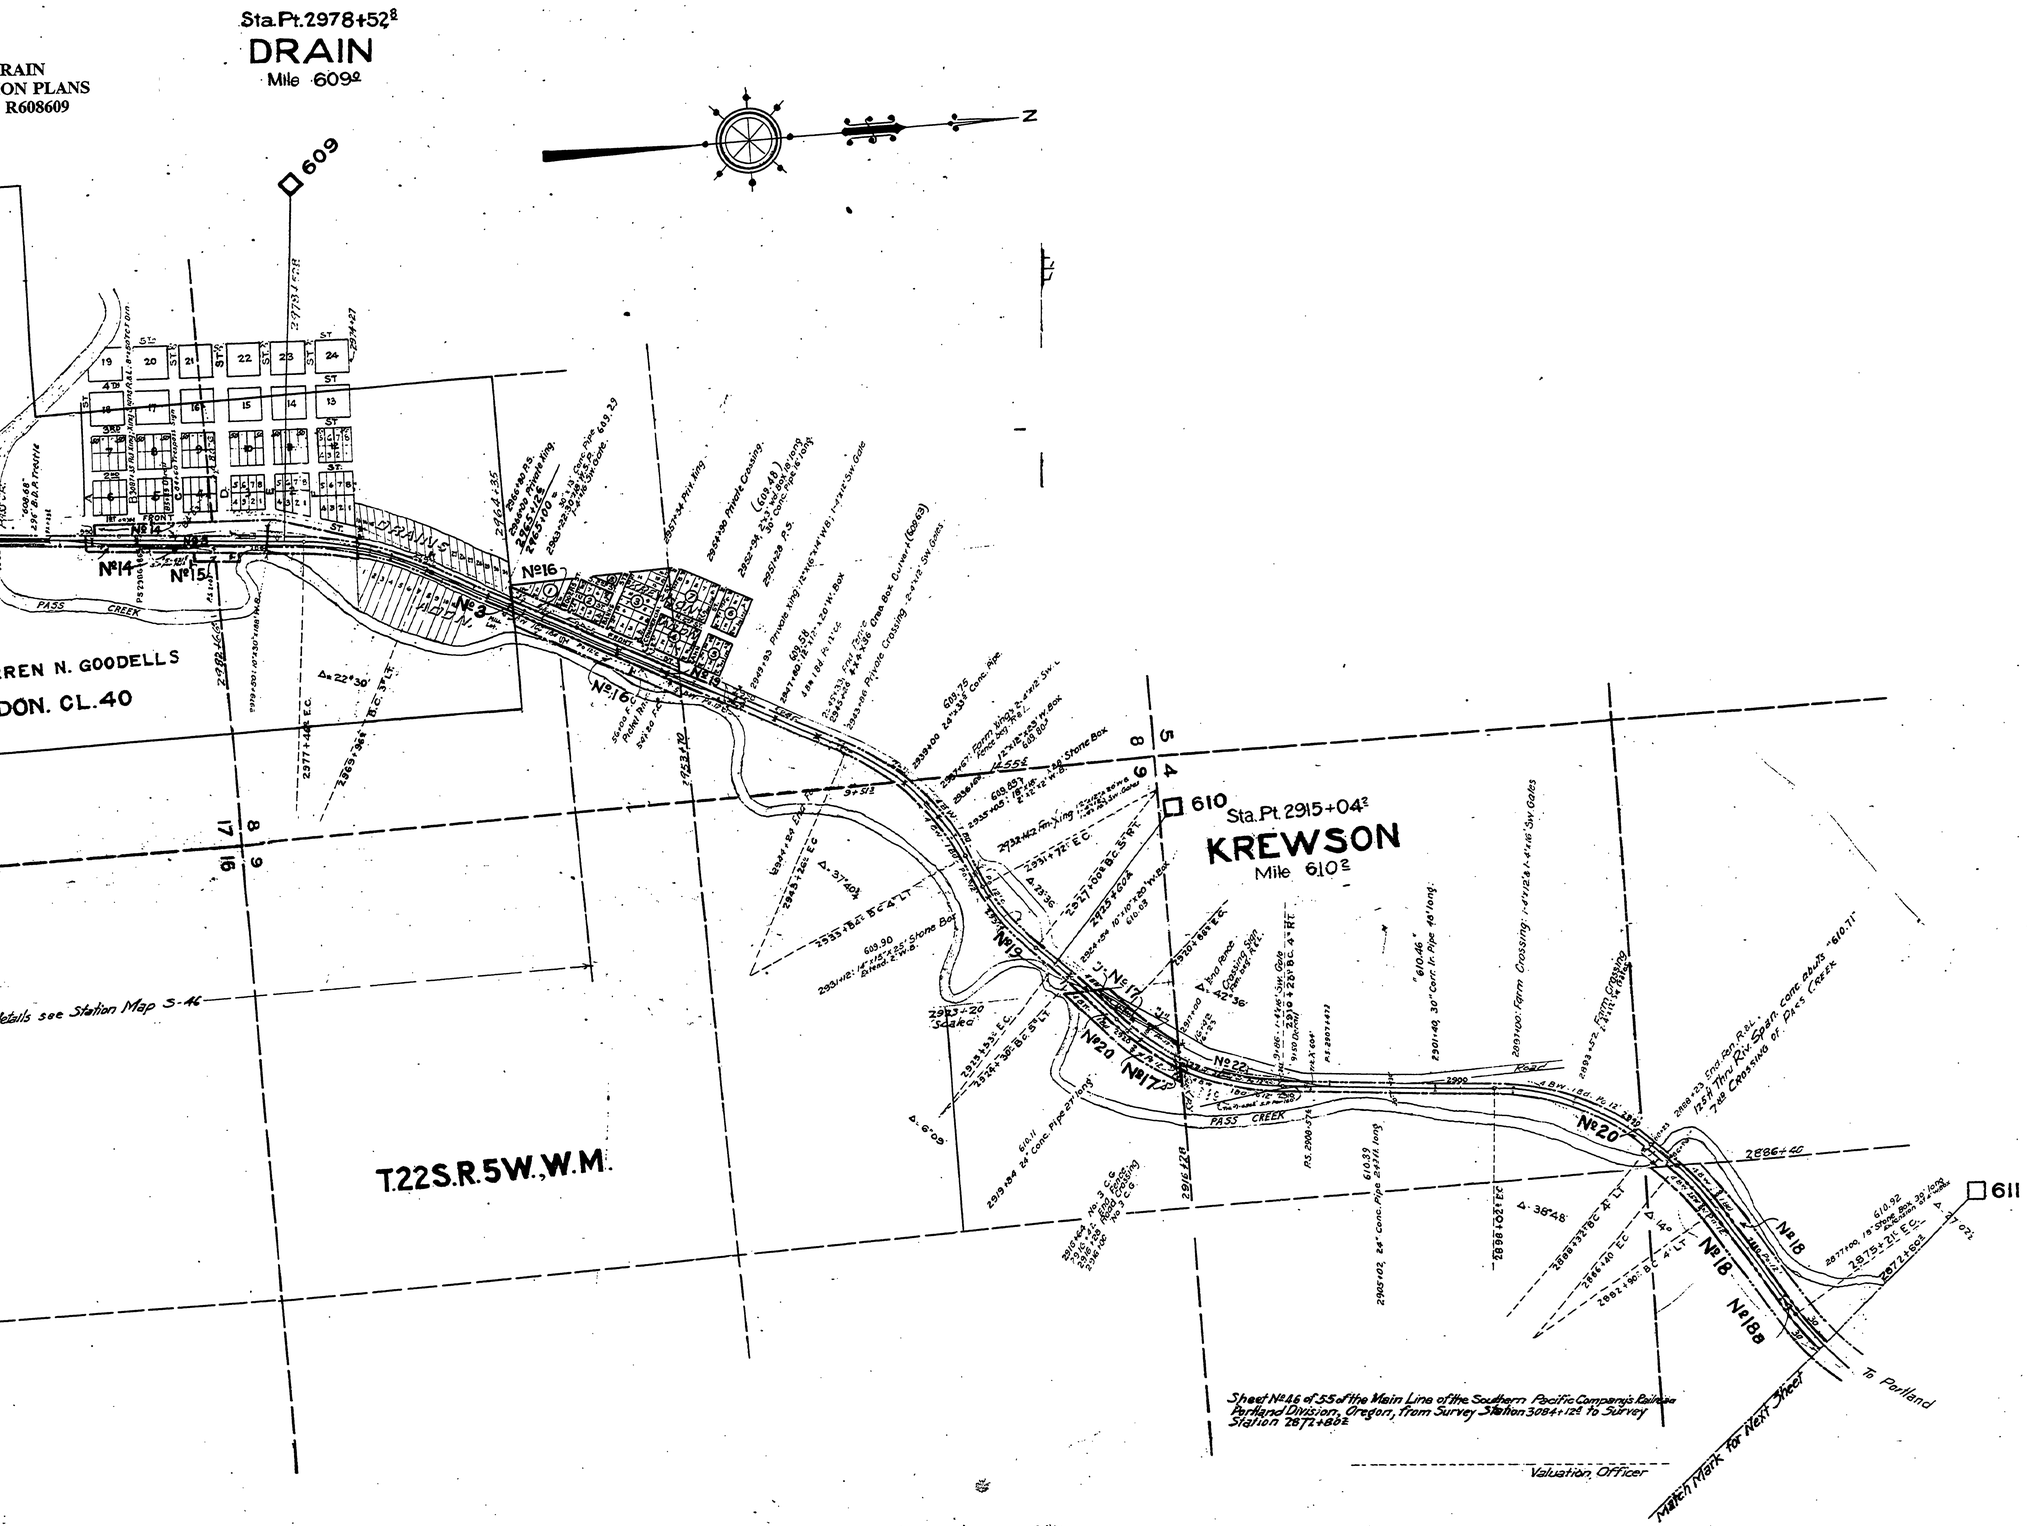

RIGHT OF WAY AND TRACK MAP

MAIN LINE

SOUTHERN PACIFIC COMPANY

OPERATED BY

SOUTHERN PACIFIC COMPANY

PORTLAND DIVISION, DOUGLAS COUNTY, OREGON

FROM STATION 3084+12.8 TO STATION 2872+80.2

Scale: 1 Inch = 400 feet

VALUATION DEPARTMENT
SAN FRANCISCO, CALIFORNIA

V-16
46