


BASS
STATION PLANS
See R730731

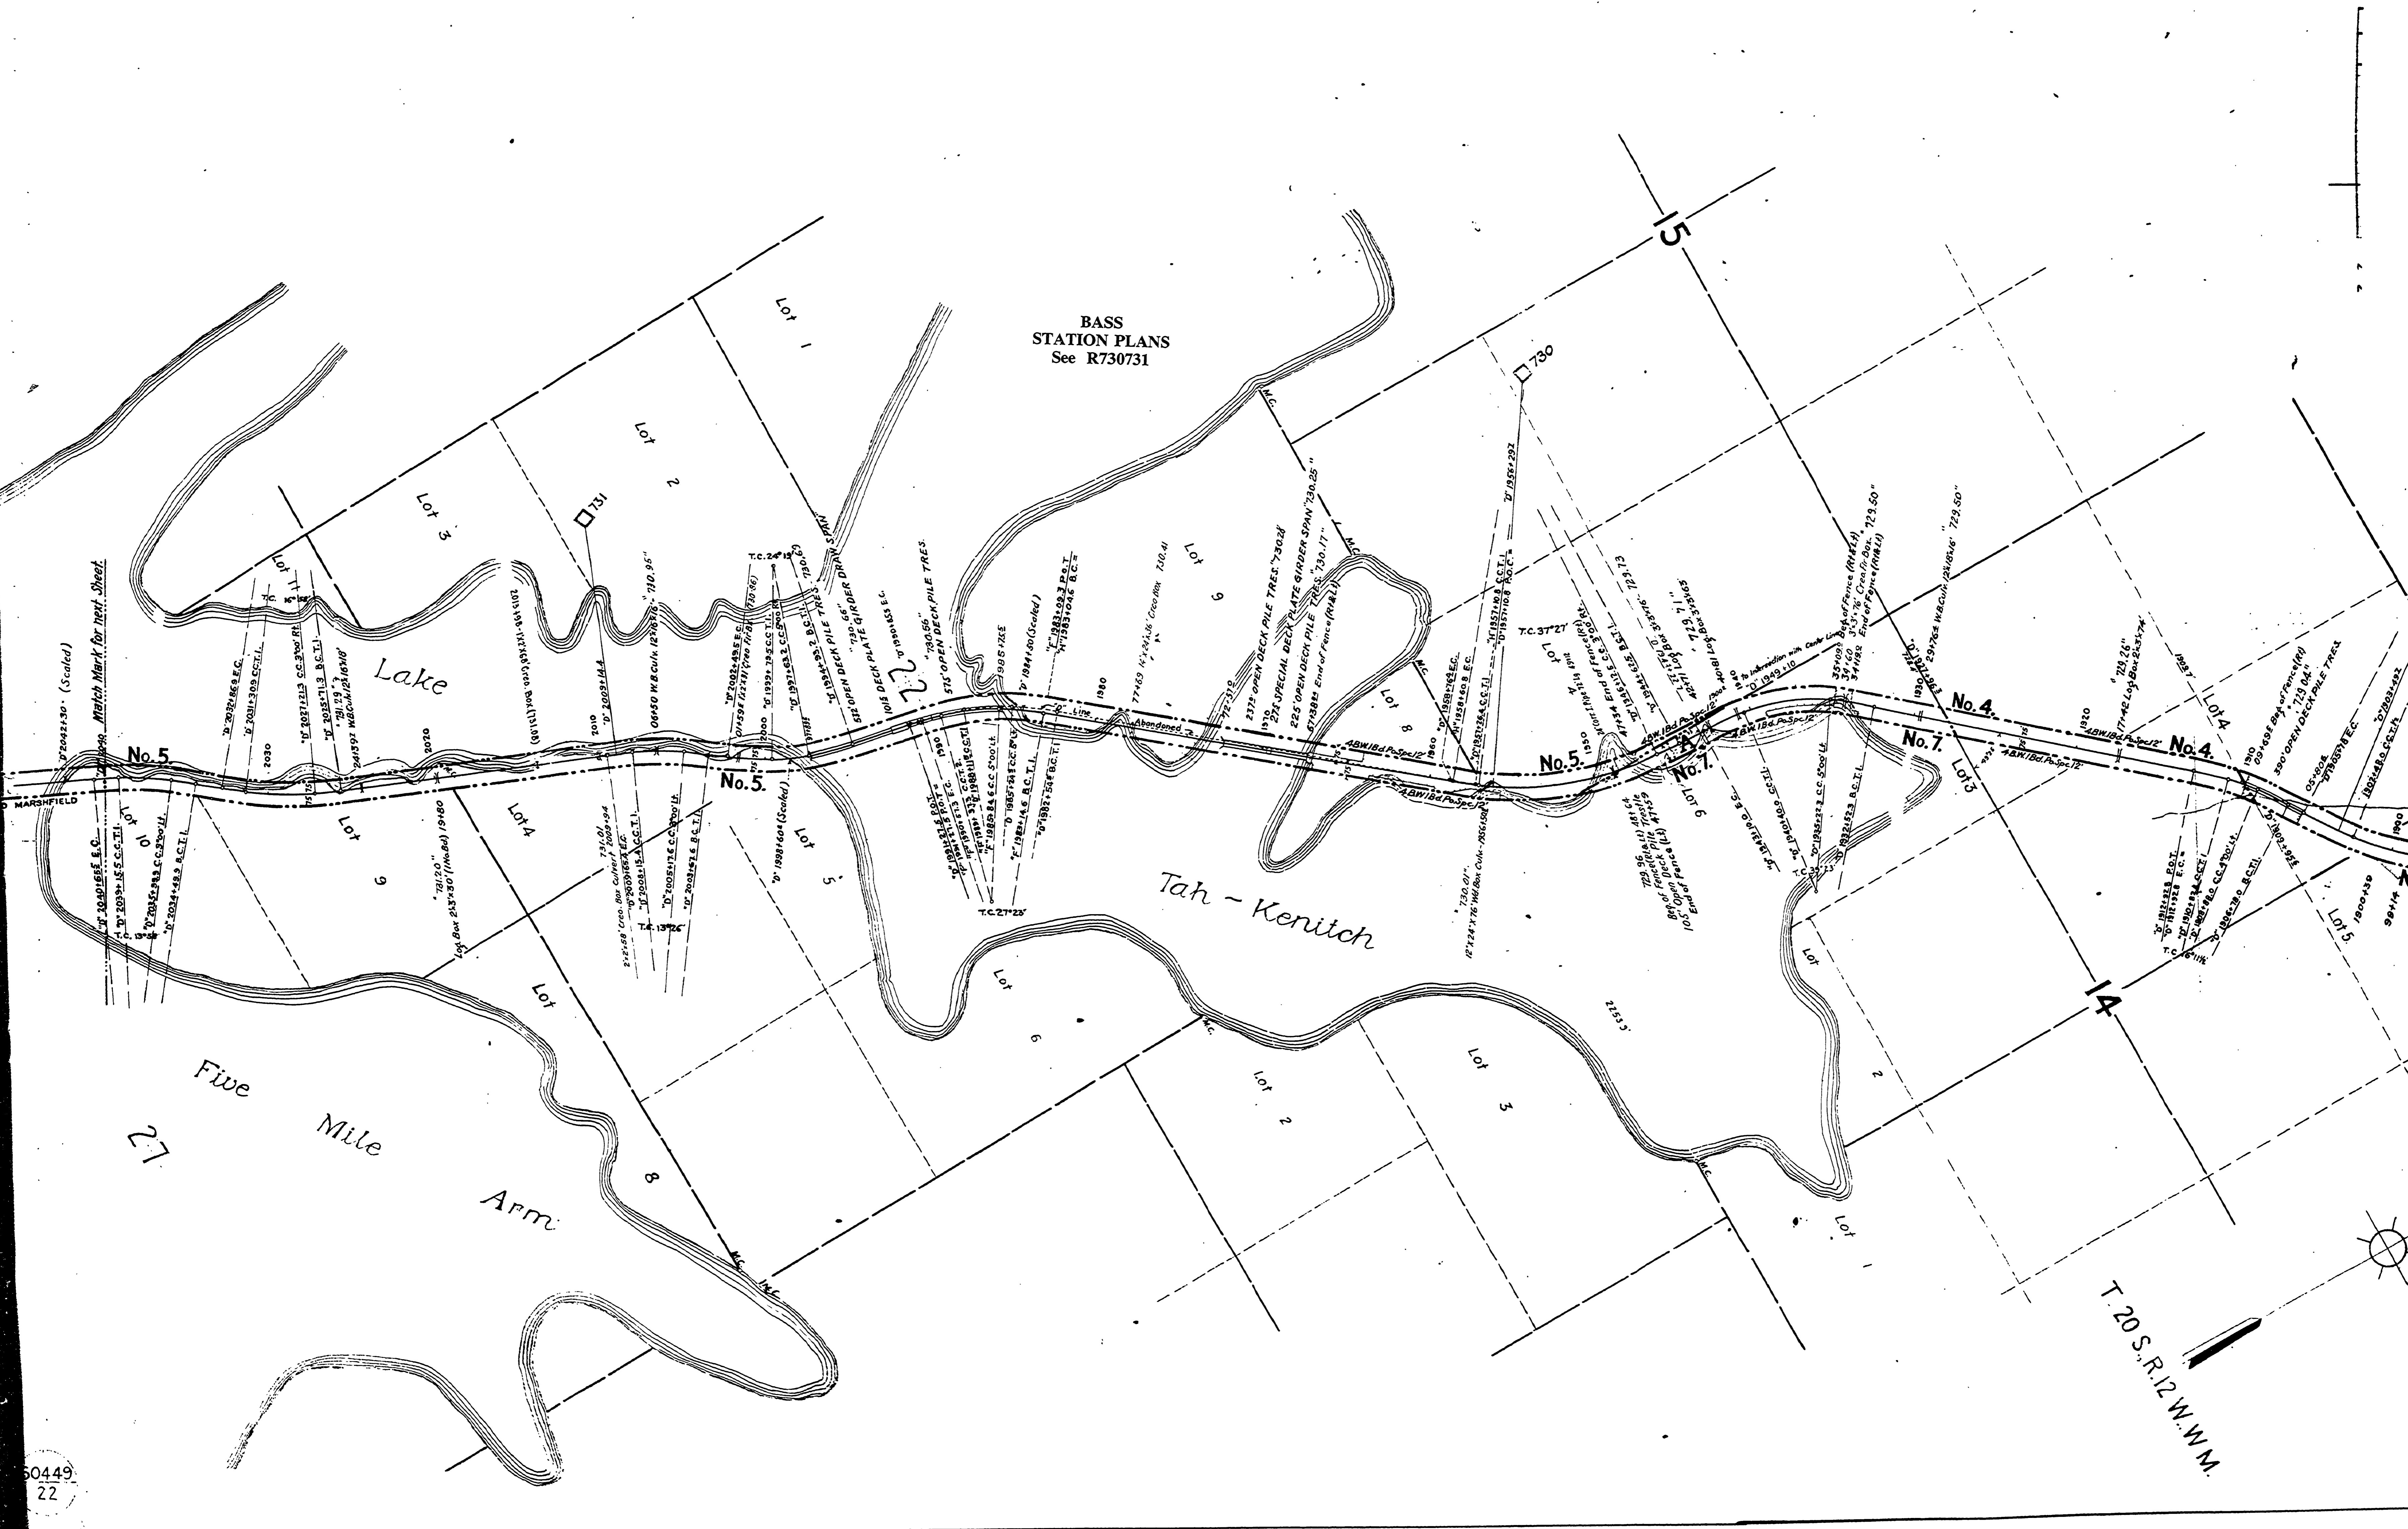

T. 20 S. R. 12 W. W.M.