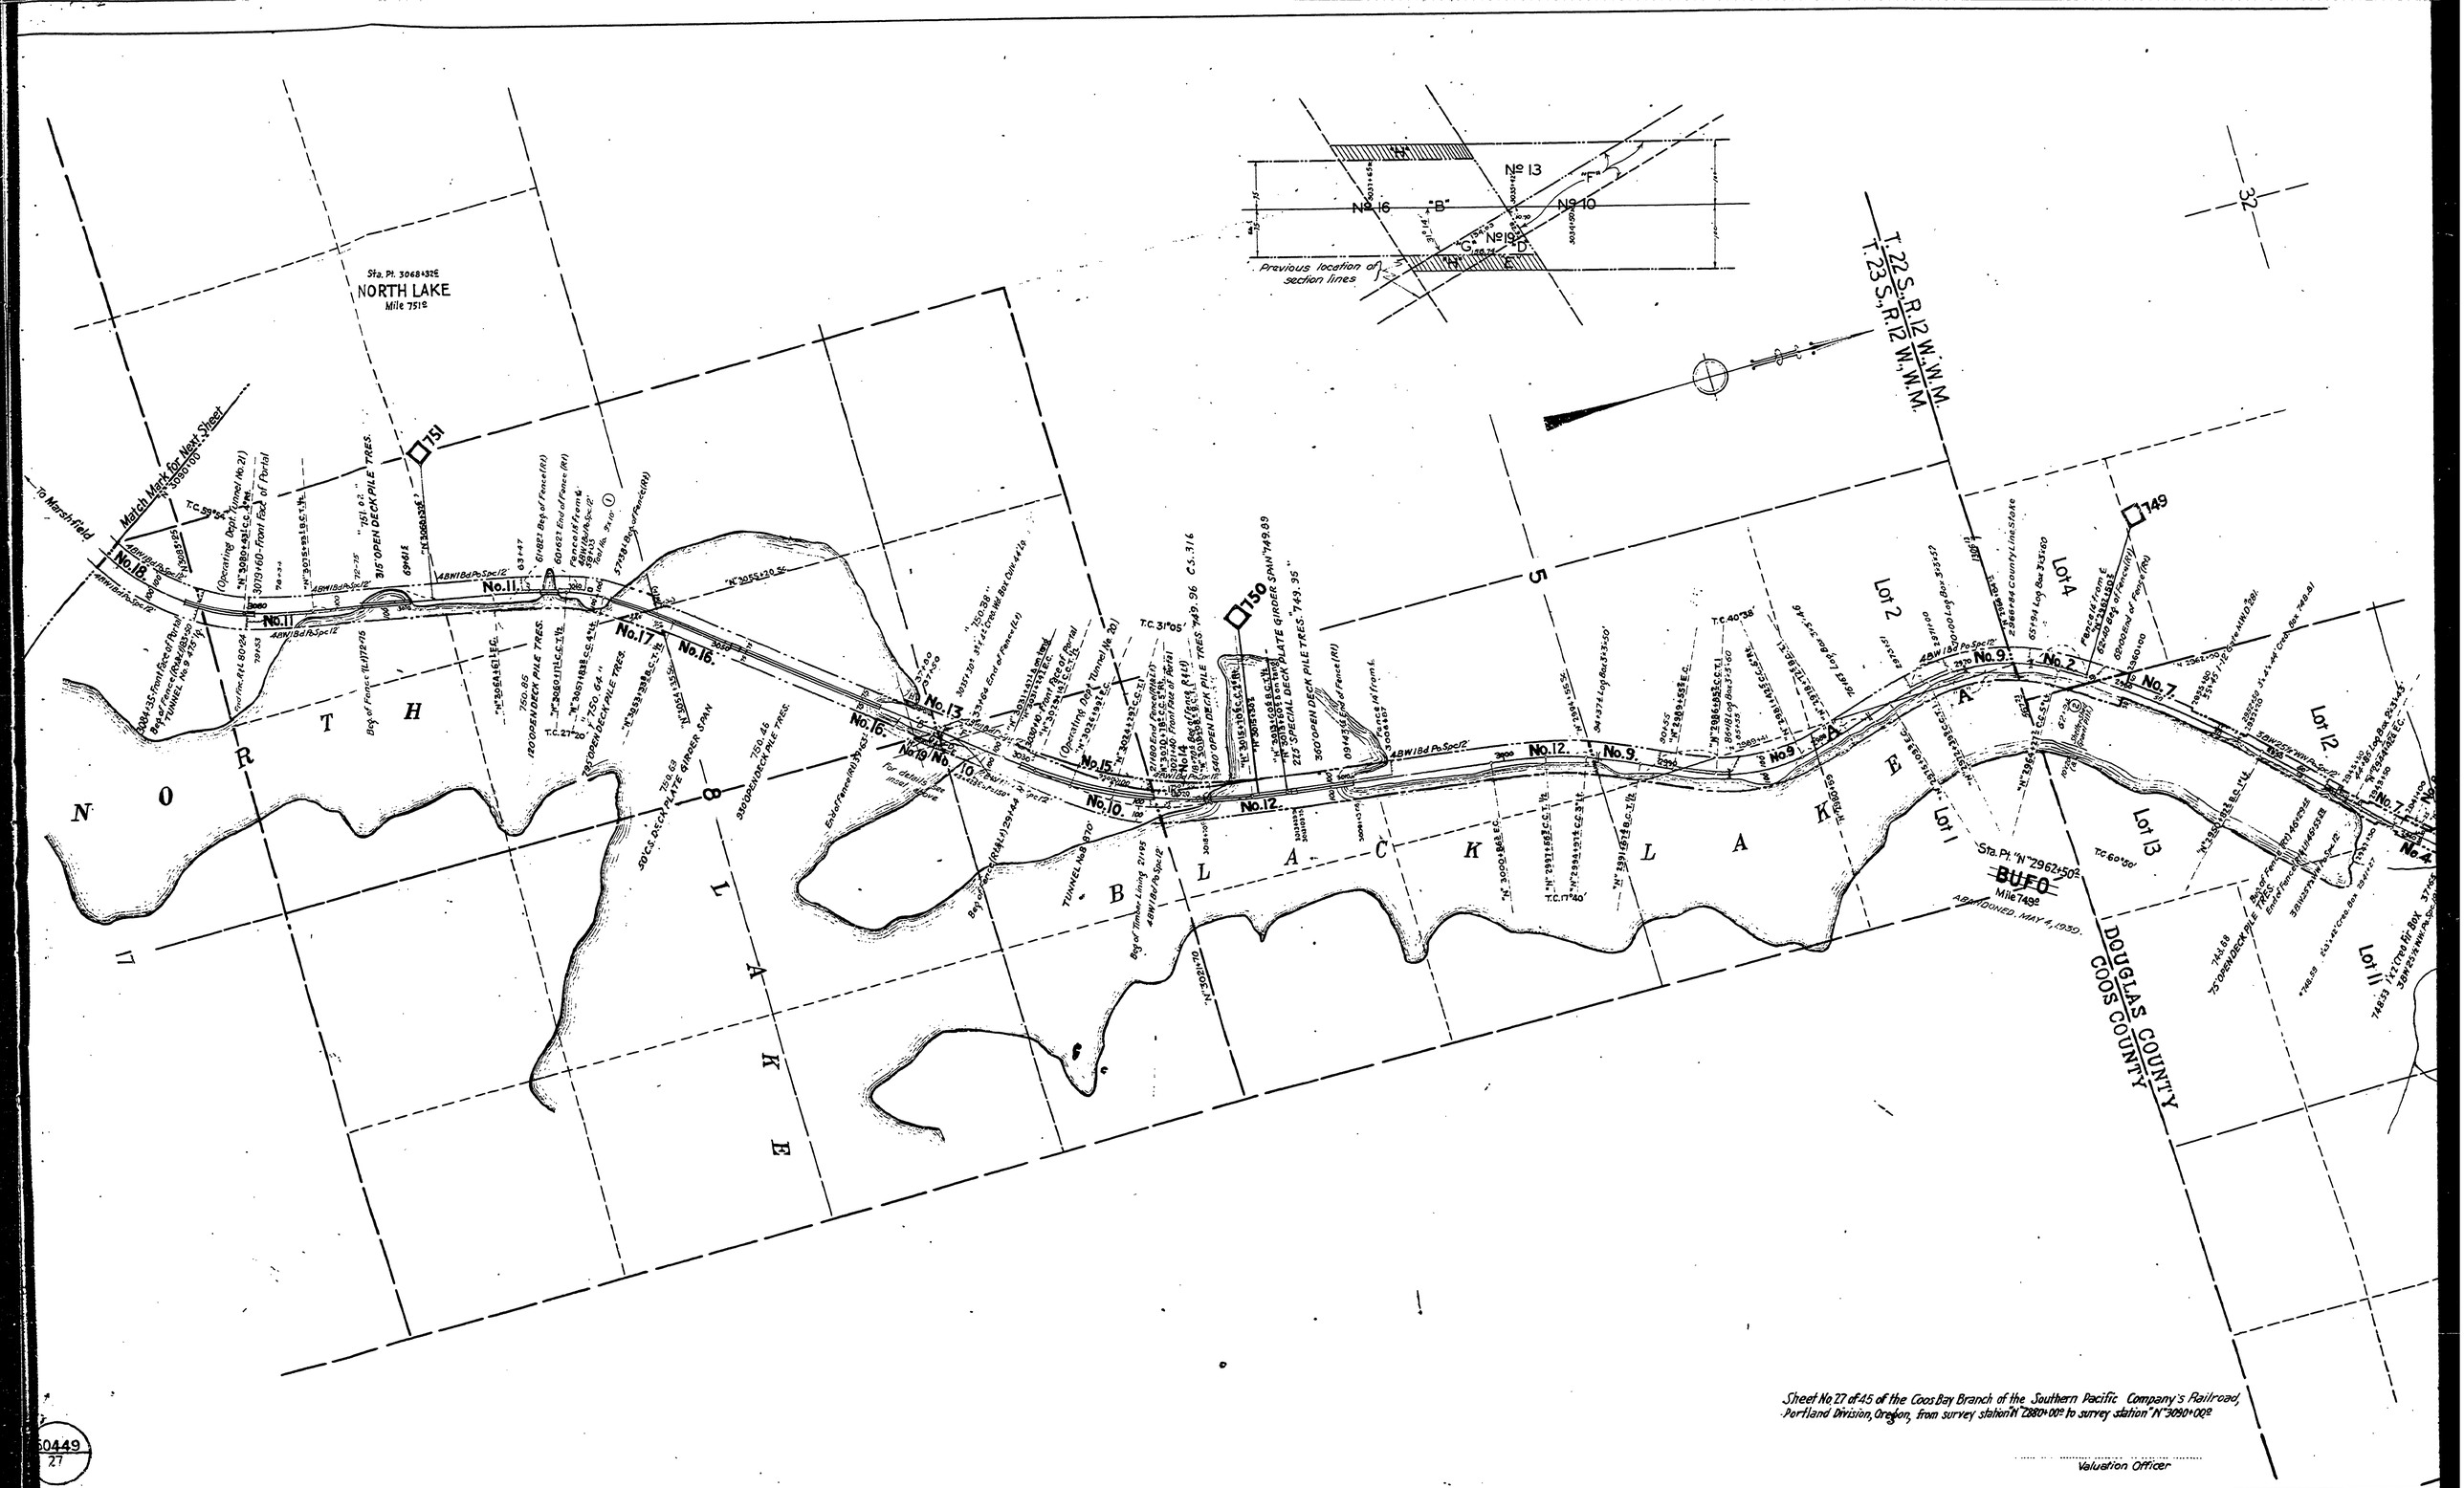
Sta. Pt. 3068+32E
NORTH LAKE
Mile 751.2
Match Mark for Next Sheet
To Marshfield
NORTH LAKE
BLACK LAKE
Previous location of section lines
No. 13
No. 16
No. 19
No. 10
"B"
"F"
"G"
"D"
T. 22 S., R. 12 W., W.M.
T. 23 S., R. 12 W., W.M.
Lot 1
Lot 2
Lot 4
Lot 11
Lot 12
Lot 13
Sta. Pt. "N" 2962+50
BUFO
Mile 749.2
ABANDONED, MAY 4, 1959.
DOUGLAS COUNTY
COOS COUNTY
Sheet No. 27 of 45 of the Coos Bay Branch of the Southern Pacific Company's Railroad, Portland Division, Oregon, from survey station "N" 2880+00 to survey station "N" 3090+00.
Valuation Officer

50449
27