LEGEND:

- ● Monuments Per Federal Highway Admin. Control Survey.
- ○ Set 5/8" x 30" Iron Rod with Plastic Cap marked "AA Surveying"
- ⊙ Found Brass Cap
- △ Calculated Point, No Monumentation
- ▫ Reference Monuments 5/8"x30" Iron Rod with Plastic Cap marked "AA Surveying"

NOTE:

Coordinates are a local coordinate system based on Federal Highway Administration control survey. Bearings are based on this Coordinate System. Record information is available from:

U.S. Department of Transportation
Federal Highway Administration
Western Federal Lands Highway Division
Vancouver, Wa. 98661

FILED
Date: 9-2-97 By: JP
This survey consists of:
Map: Co. Rd. # 1
Narrative:
Corner Rpt:
DOUGLAS COUNTY SURVEYOR

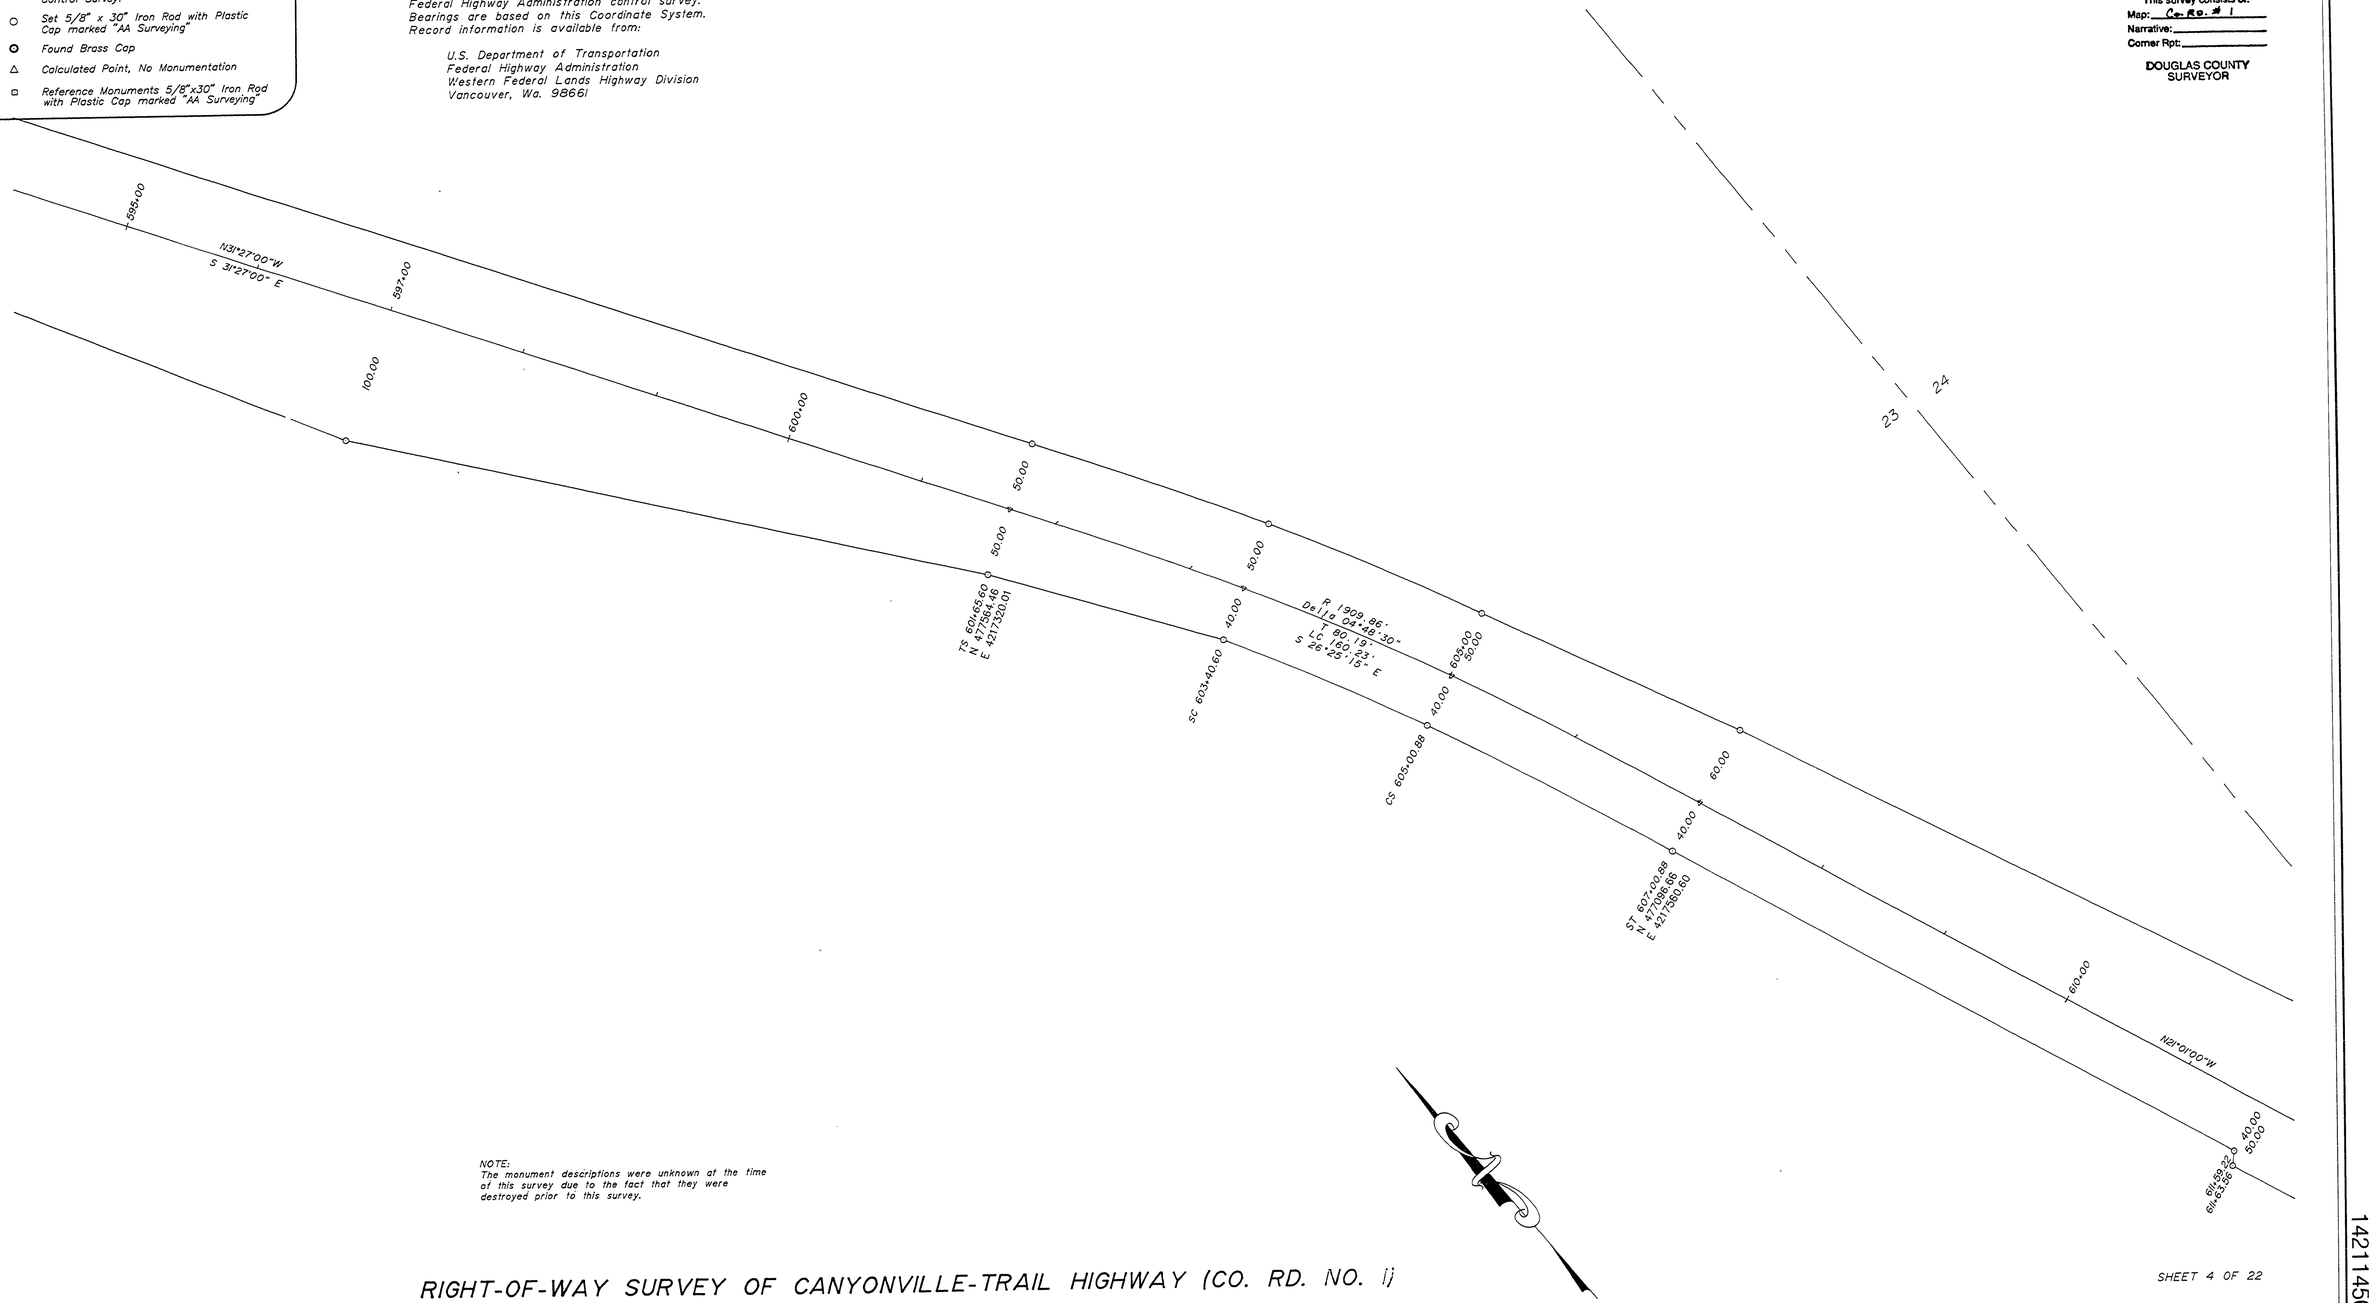

NOTE:
The manument descriptions were unknown at the time of this survey due to the fact that they were destroyed prior to this survey.

RIGHT-OF-WAY SURVEY OF CANYONVILLE-TRAIL HIGHWAY (CO. RD. NO. 1)

SECTION 23
T30S, R4W, W.M.
For Federal Highway Administration
JANUARY 1996

SCALE: 1 INCH = 50 FEET
0' 50' 100' 150'

SHEET 4 OF 22

REGISTERED PROFESSIONAL LAND SURVEYOR
OREGON
JULY 14, 1978
RONALD A. QUIMBY
1654
EXP. DATE: 12-31-98

AA SURVEYING SERVICE, INC.
3076 NE DIAMOND LAKE BLVD.
ROSEBURG, OREGON 97470
TEL (541)672-2096
FAX (541)672-0611

1758-95

14211456

~ M.P. 14.21 - 14.56

CO. RD. # 1 (4)