FILED
Date: 9-2-97 By: JP
This survey consists of:
Map: Co. Rd. # 1
Narrative:
Corner Rpt:
DOUGLAS COUNTY SURVEYOR

LEGEND:
- ● Monuments Per Federal Highway Admin. Control Survey.
- ○ Set 5/8" x 30" Iron Rod with Plastic Cap marked "AA Surveying"
- ◎ Found Brass Cap
- △ Calculated Point, No Monumentation
- ▫ Reference Monuments 5/8"x30" Iron Rod with Plastic Cap marked "AA Surveying"

NOTE:
Coordinates are a local coordinate system based on Federal Highway Administration control survey. Bearings are based on this Coordinate System. Record information is available from:

U.S. Department of Transportation
Federal Highway Administration
Western Federal Lands Highway Division
Vancouver, Wa. 98661

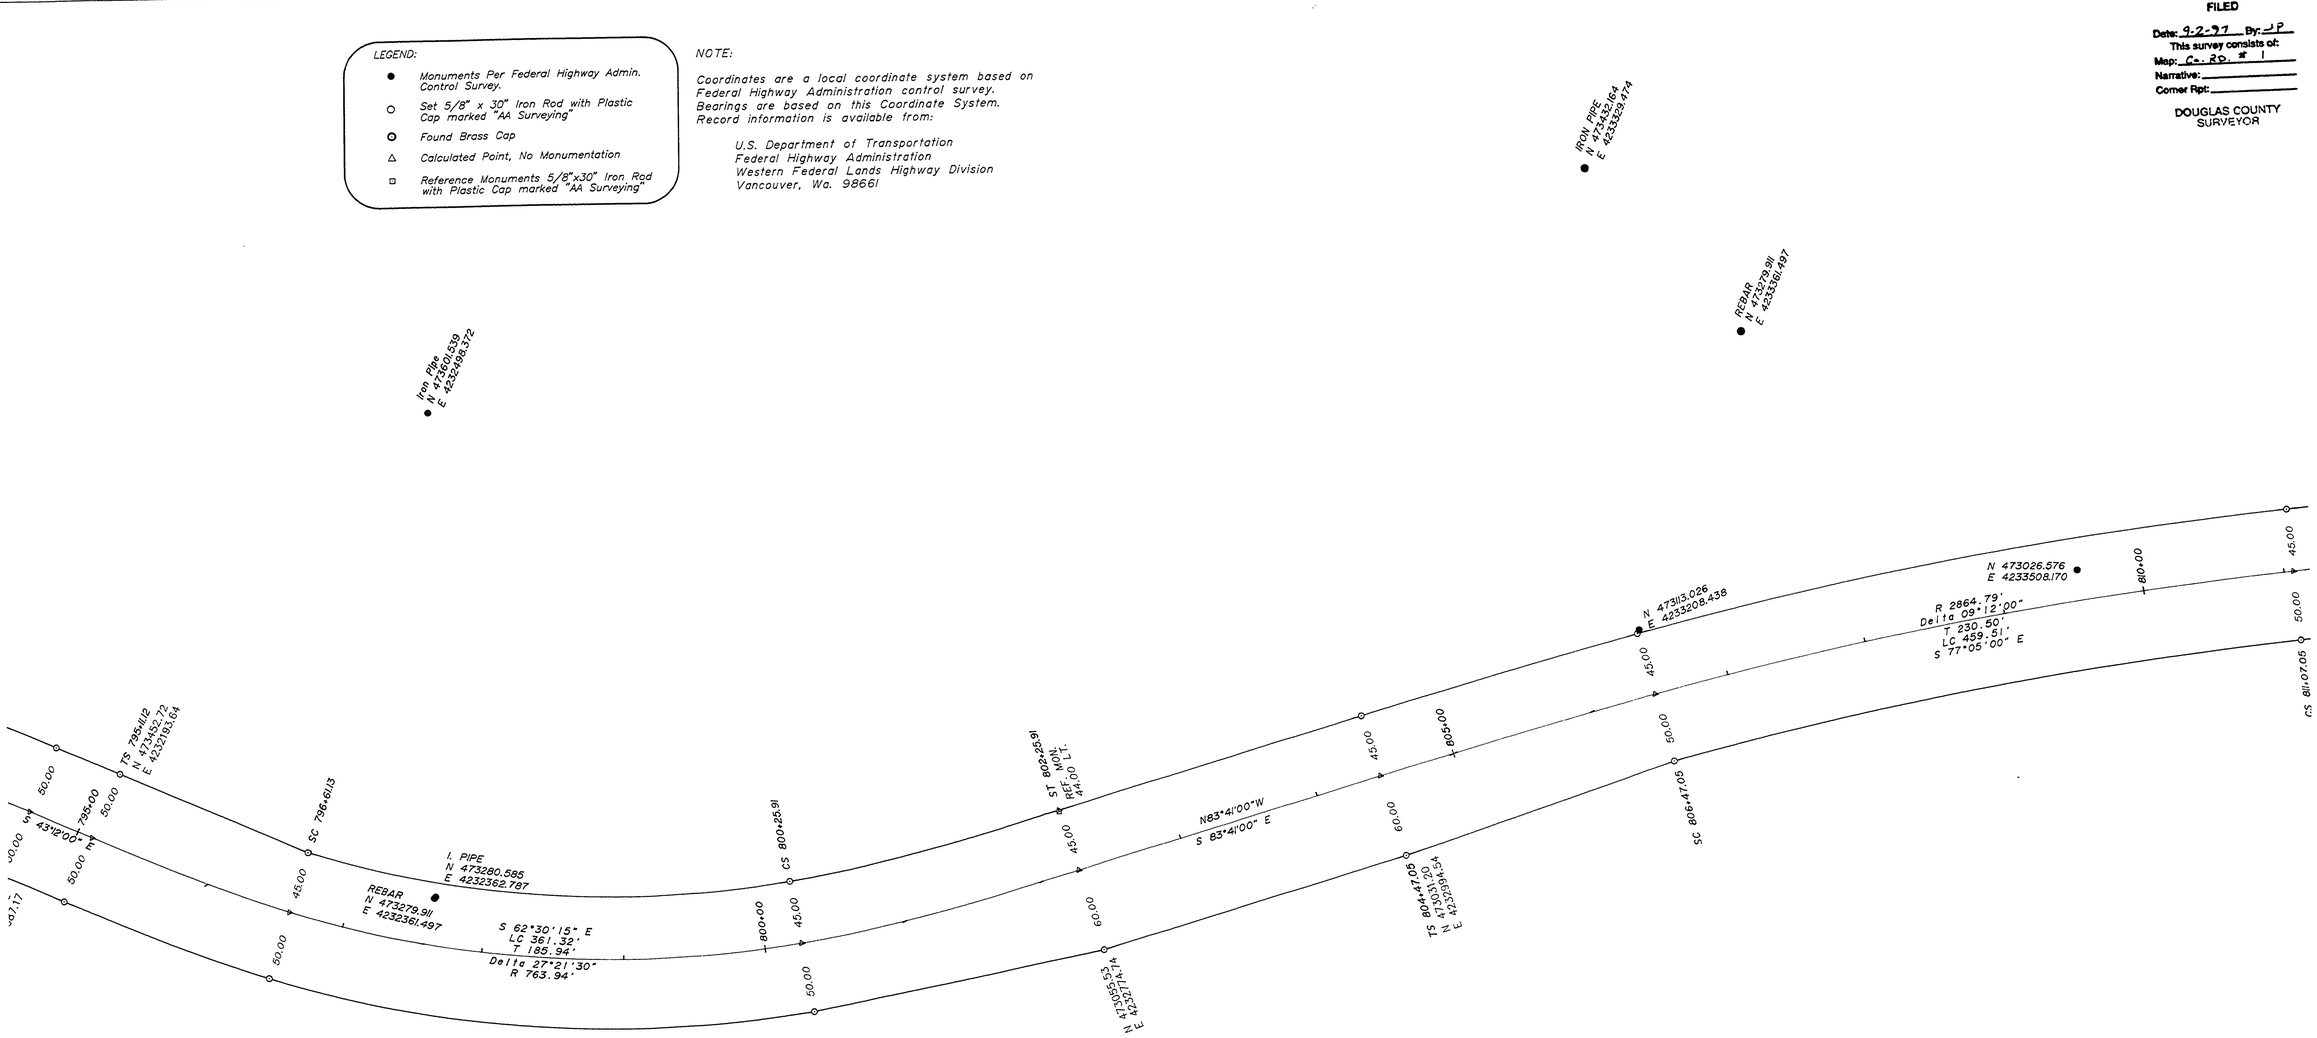

NOTE:
The monument descriptions were unknown at the time of this survey due to the fact that they were destroyed prior to this survey.

RIGHT-OF-WAY SURVEY OF CANYONVILLE-TRAIL HIGHWAY (CO. RD. NO. 1)

SECTION 28
T30S, R3W, W.M.
For Federal Highway Administration
JANUARY 1996

SCALE: 1 INCH = 50 FEET
0' 50' 100' 150'

SHEET 17 OF 22

REGISTERED PROFESSIONAL LAND SURVEYOR
OREGON
JULY 14, 1978
RONALD A. QUIMBY
1554
EXP. DATE: 12-31-98
1758-95

AA SURVEYING SERVICE, INC.
3076 NE DIAMOND LAKE BLVD.
ROSEBURG, OREGON 97470
TEL (541)672-2096
FAX (541)672-0611

18021833

~ M.P. 18.02 - 18.33

CO. RD. # 1

17