



VR
VZ
NW

"AS SET, RIGHT-OF-WAY MONUMENTS"
 OREGON FOREST HIGHWAY PROJECT FH-16-1(I)
 CANYONVILLE ~ TRAIL HIGHWAY
 UMPQUA NATIONAL FOREST
 DOUGLAS COUNTY
 LENGTH 2.2 MILES

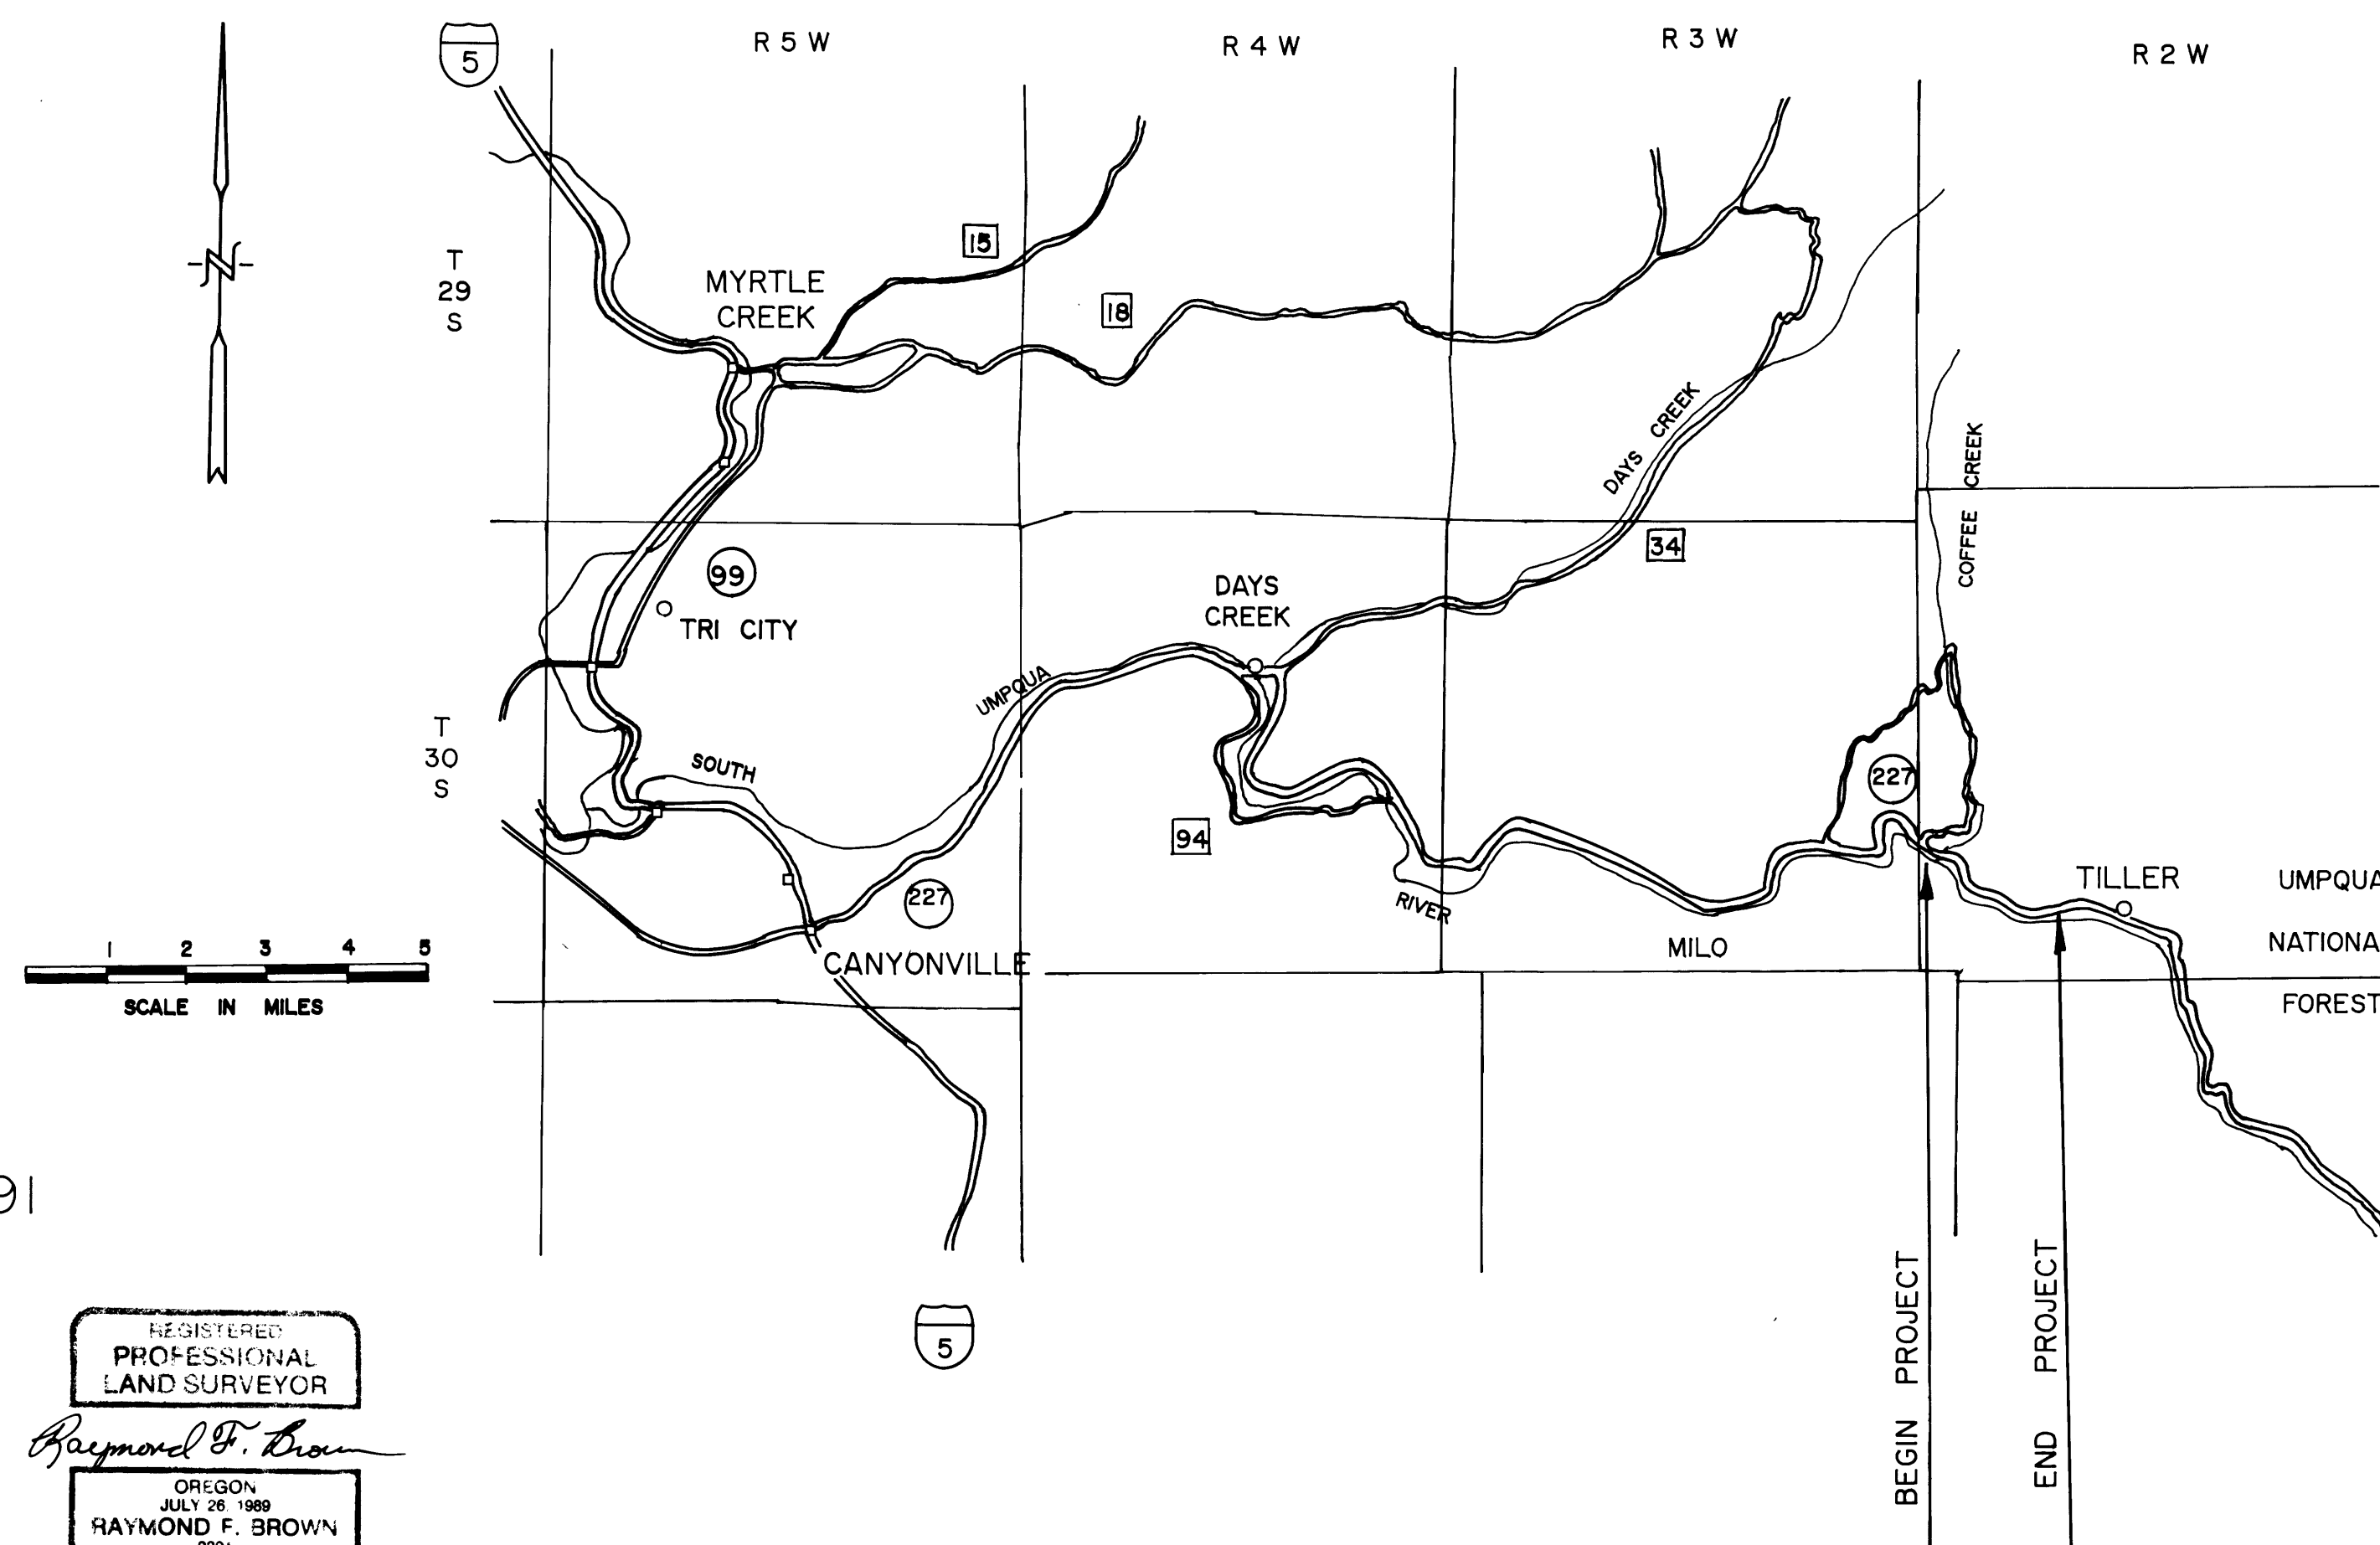

PREPARED BY:
 RAYMOND F. BROWN - P.L.S. 2391
 P.O. BOX 539
 CANYONVILLE, OREGON 97417
 Phone: (503) 839-6185
 AUGUST 1, 1992

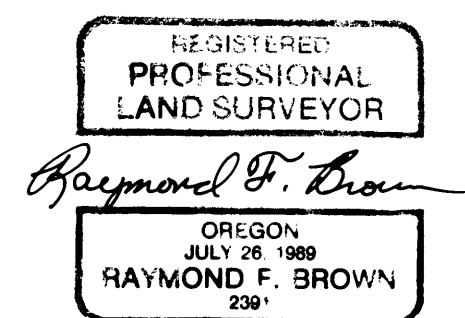

NOTE:
 NARRATIVE ON SHEET # 4.

SHEET 1 OF 5 SHEETS