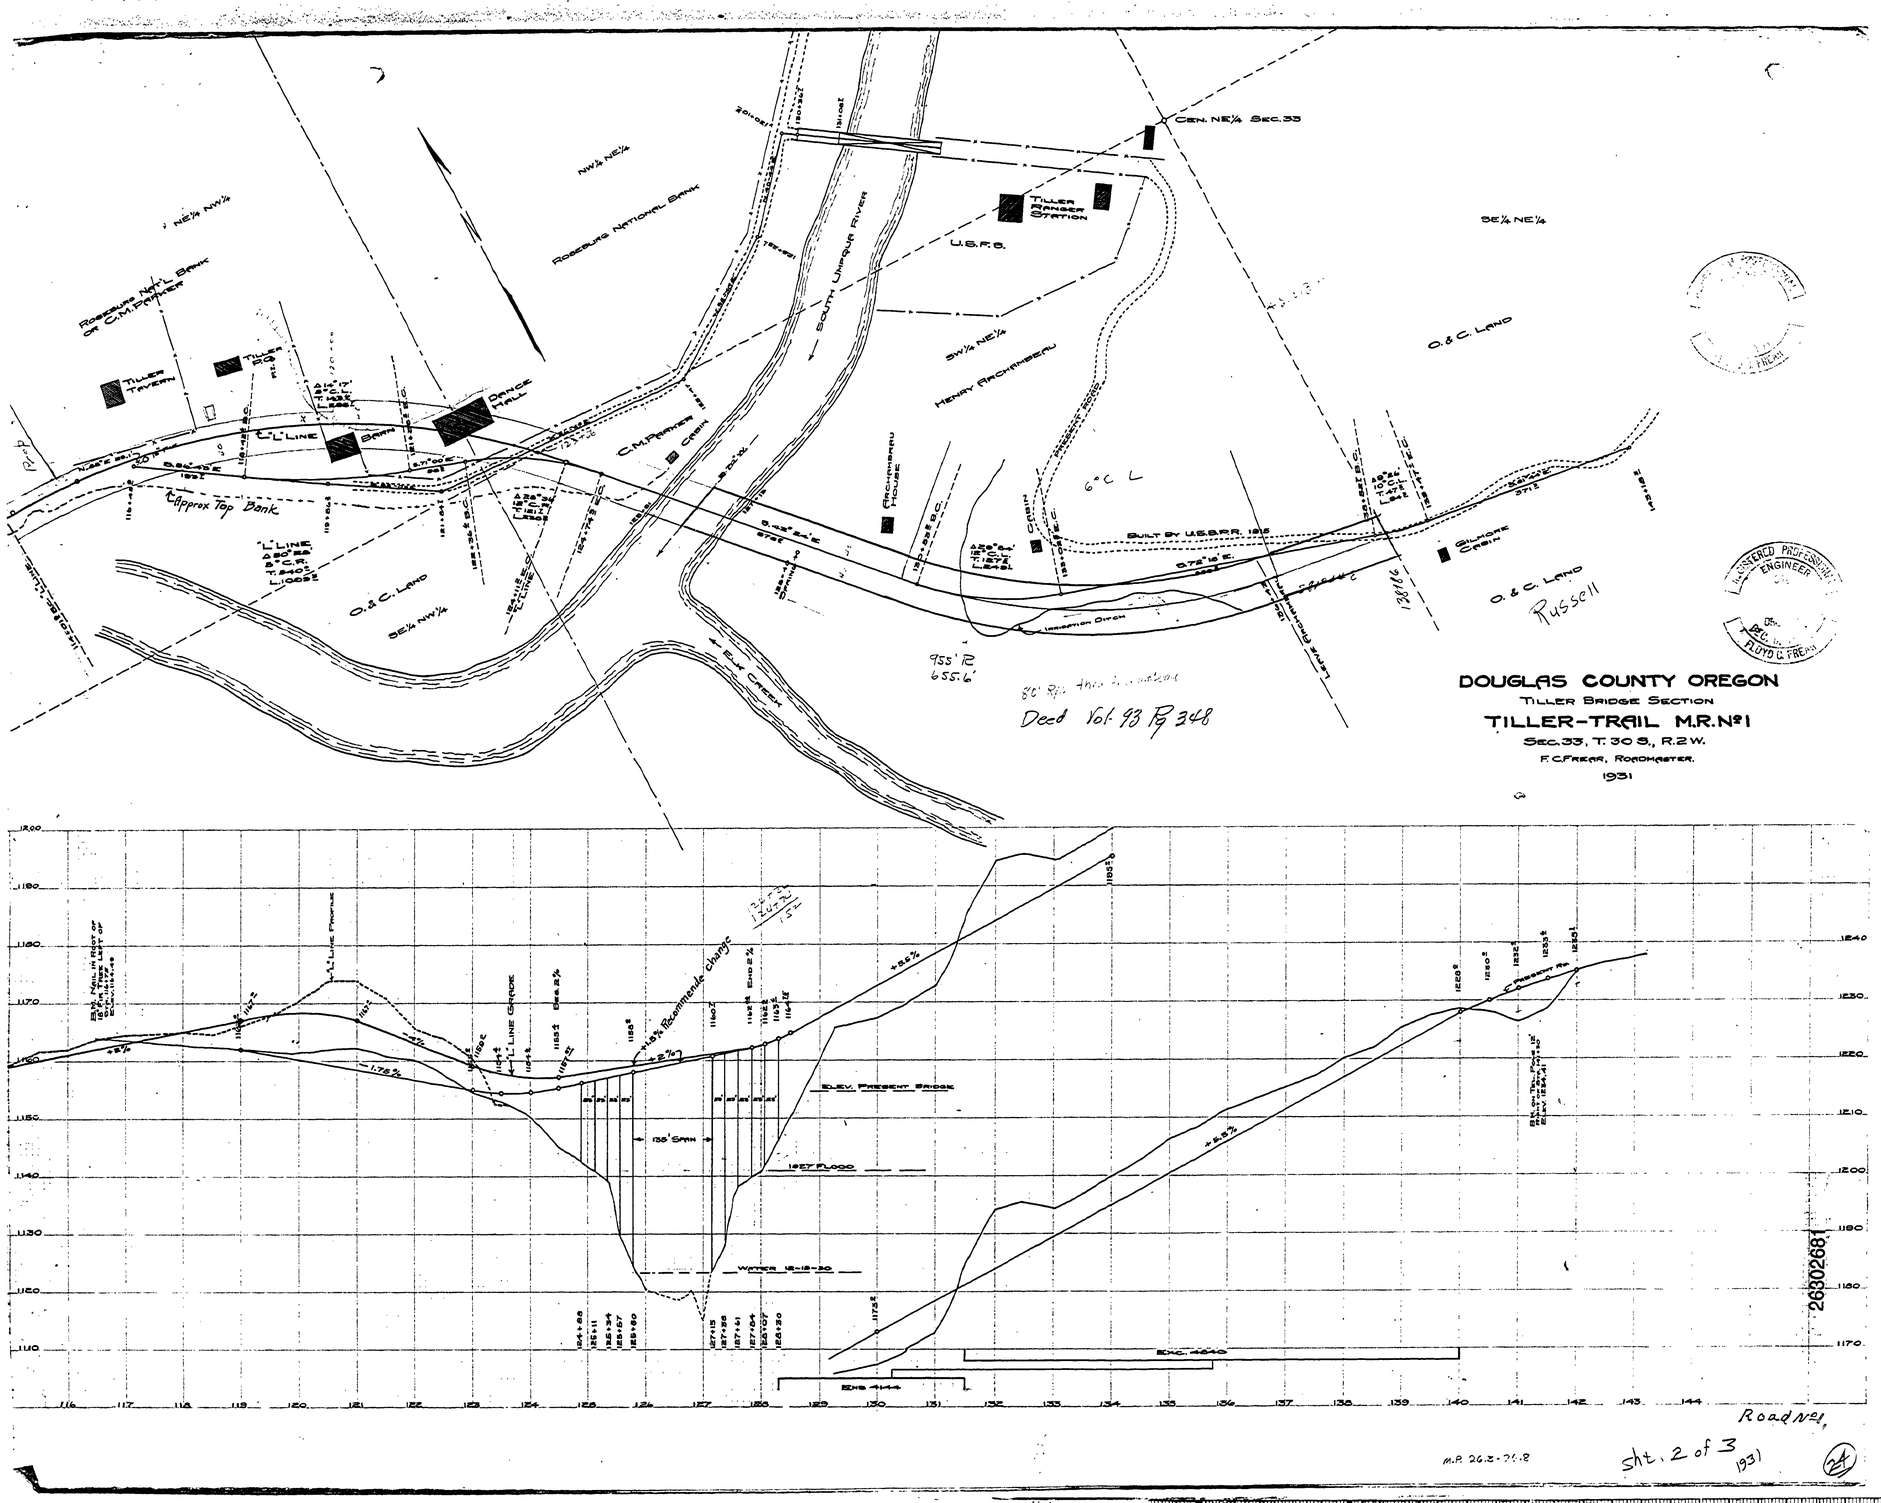
DOUGLAS COUNTY OREGON
TILLER BRIDGE SECTION
TILLER-TRAIL M.R. Nº 1
SEC. 33, T. 30 S., R. 2 W.
F. C. FREER, ROADMASTER.
1931
Deed Vol. 93 Pg 348
Russell
Roseburg National Bank
Tiller Tavern
Dance Hall
Barn
"L" Line
Approx Top Bank
O. & C. Land
South Umpqua River
Tiller Ranger Station
U.S.F.S.
Henry Archibeau
Archibeau House
Cabin
Built by U.S.B.P.R. 1925
Irrigation Ditch
Elk Creek
Gilmore Cabin
Cen. NE¼ Sec. 33
Elev. Present Bridge
1927 Flood
Water 12-12-30
Proposed Rd.
Road No. 1
Sht. 2 of 3
1931
26302681

30 X