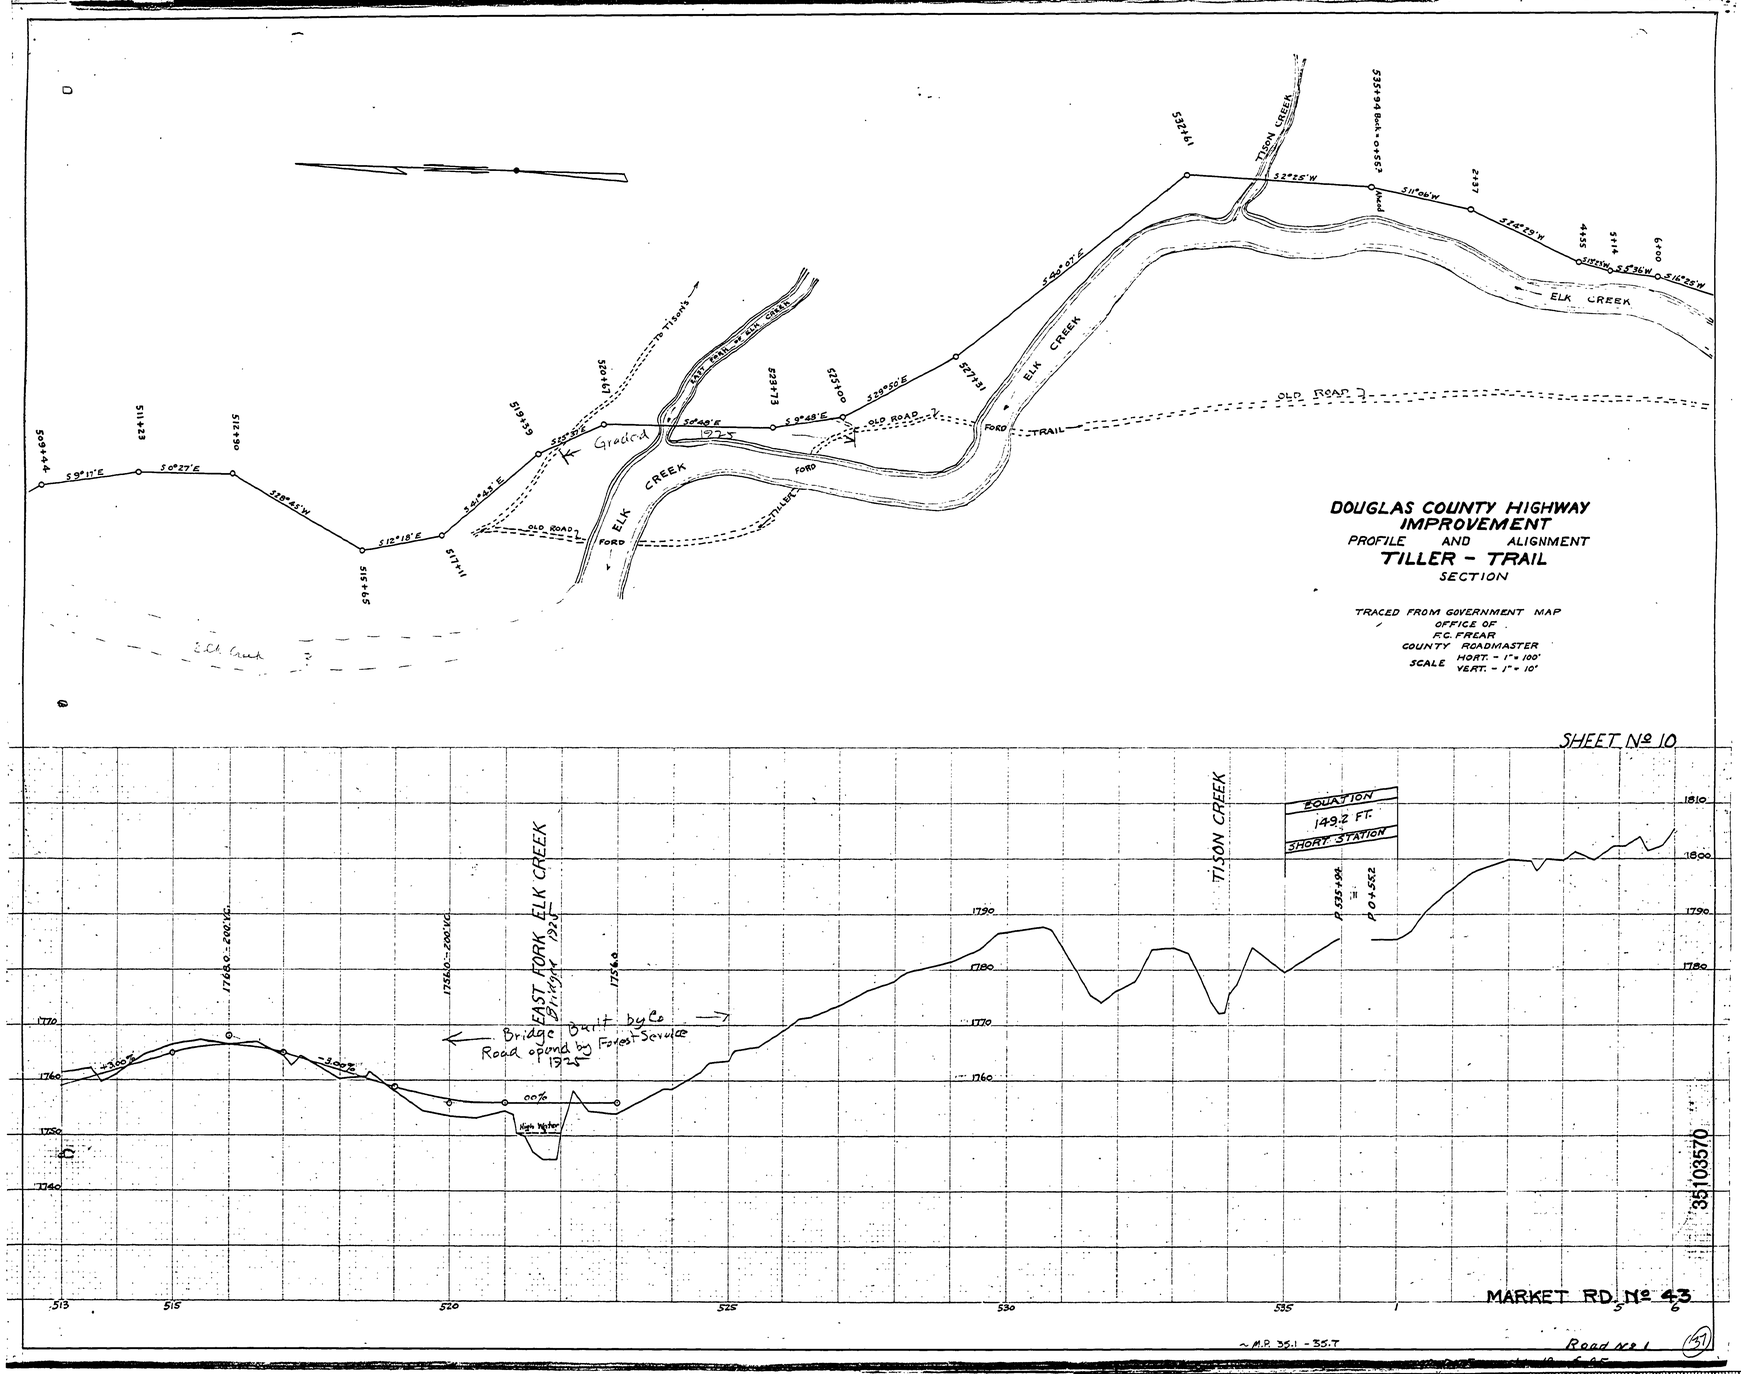
DOUGLAS COUNTY HIGHWAY IMPROVEMENT
PROFILE AND ALIGNMENT
TILLER - TRAIL
SECTION
TRACED FROM GOVERNMENT MAP
OFFICE OF
F.C. FREAR
COUNTY ROADMASTER
SCALE HORT. - 1" = 100'
VERT. - 1" = 10'
SHEET No 10
ELK CREEK
TISON CREEK
OLD ROAD
TRAIL
FORD
EQUATION
149.2 FT.
SHORT STATION
EAST FORK ELK CREEK
Bridge Built by Co
Road opened by Forest Service
MARKET RD. No 43
~ M.P. 35.1 - 35.7
35103570

30 X