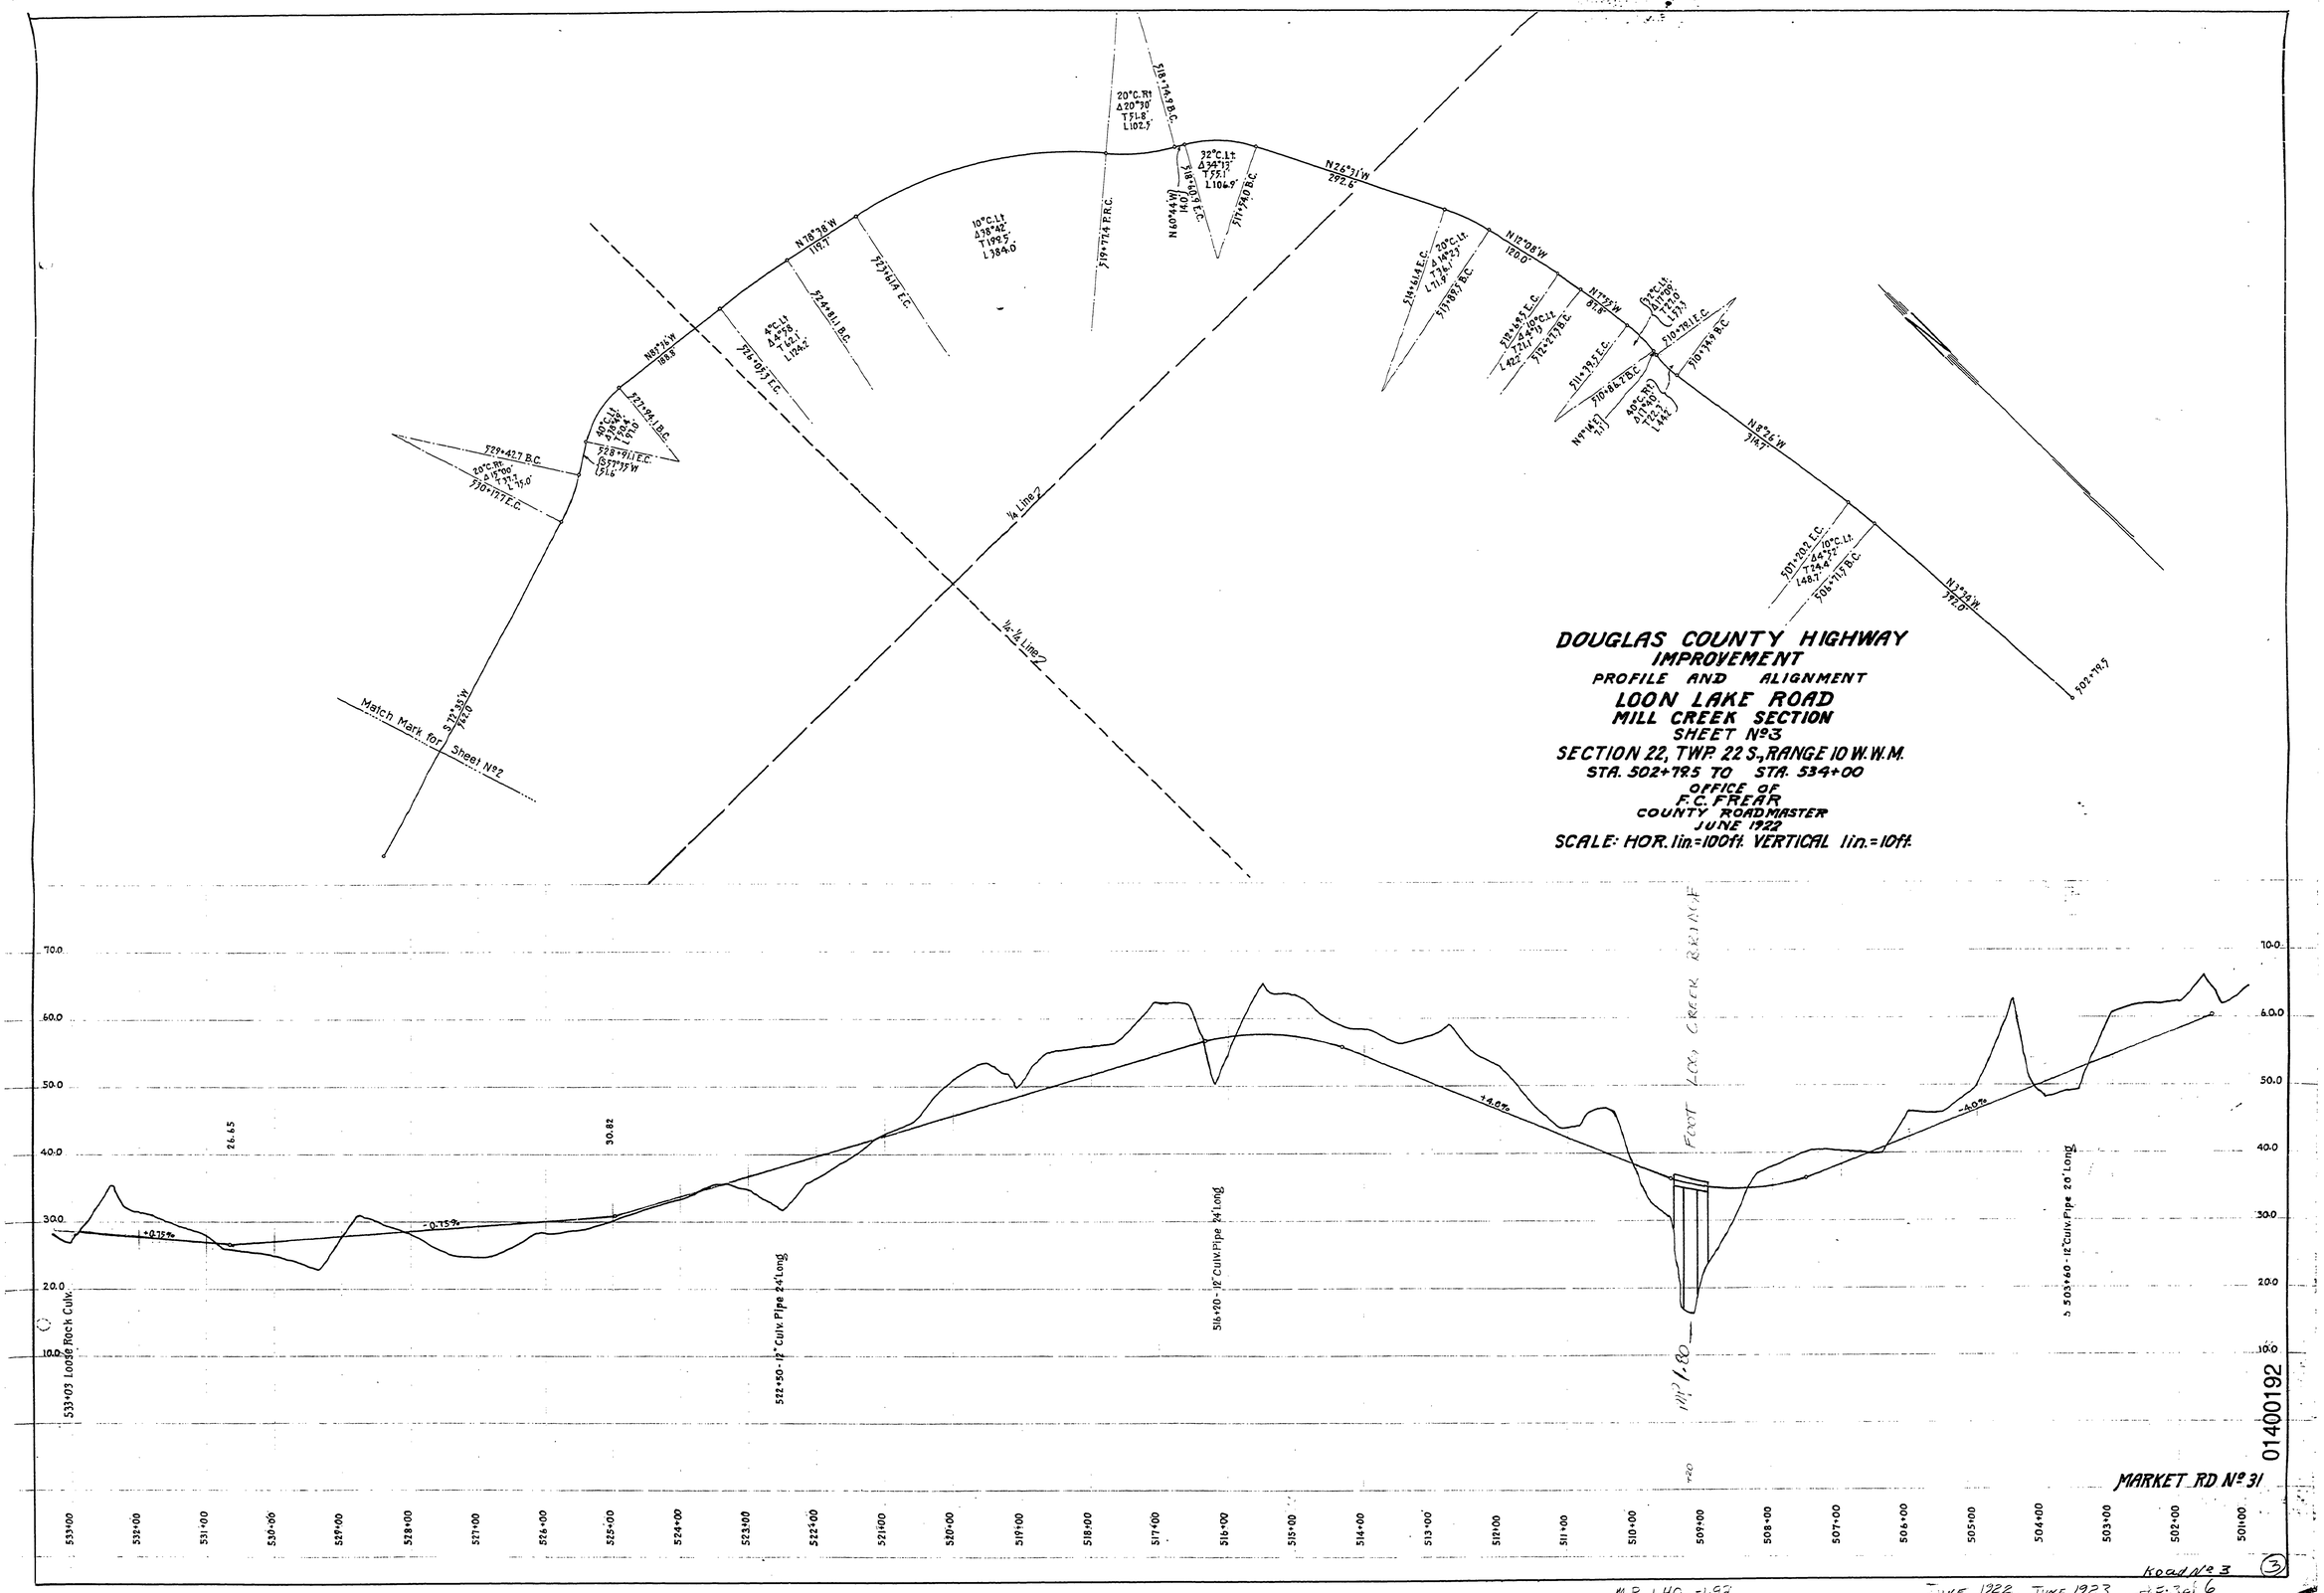
DOUGLAS COUNTY HIGHWAY
IMPROVEMENT
PROFILE AND ALIGNMENT
LOON LAKE ROAD
MILL CREEK SECTION
SHEET Nº3
SECTION 22, TWP. 22 S., RANGE 10 W.W.M.
STA. 502+79.5 TO STA. 534+00
OFFICE OF
F.C. FREAR
COUNTY ROADMASTER
JUNE 1922
SCALE: HOR. 1in.=100ft. VERTICAL 1in.=10ft.
Match Mark for Sheet Nº2
1/4 Line 2
1/4-1/4 Line 2
533+03 Loose Rock Culv.
522+50 - 12" Culv. Pipe 24' Long
516+20 - 12" Culv. Pipe 24' Long
503+60 - 12" Culv. Pipe 20' Long
FOOT LOG, CREEK BRIDGE
MARKET RD Nº 31
Road Nº 3
M.P. 1.40 - 1.92
JUNE 1922, JUNE 1923
01400192