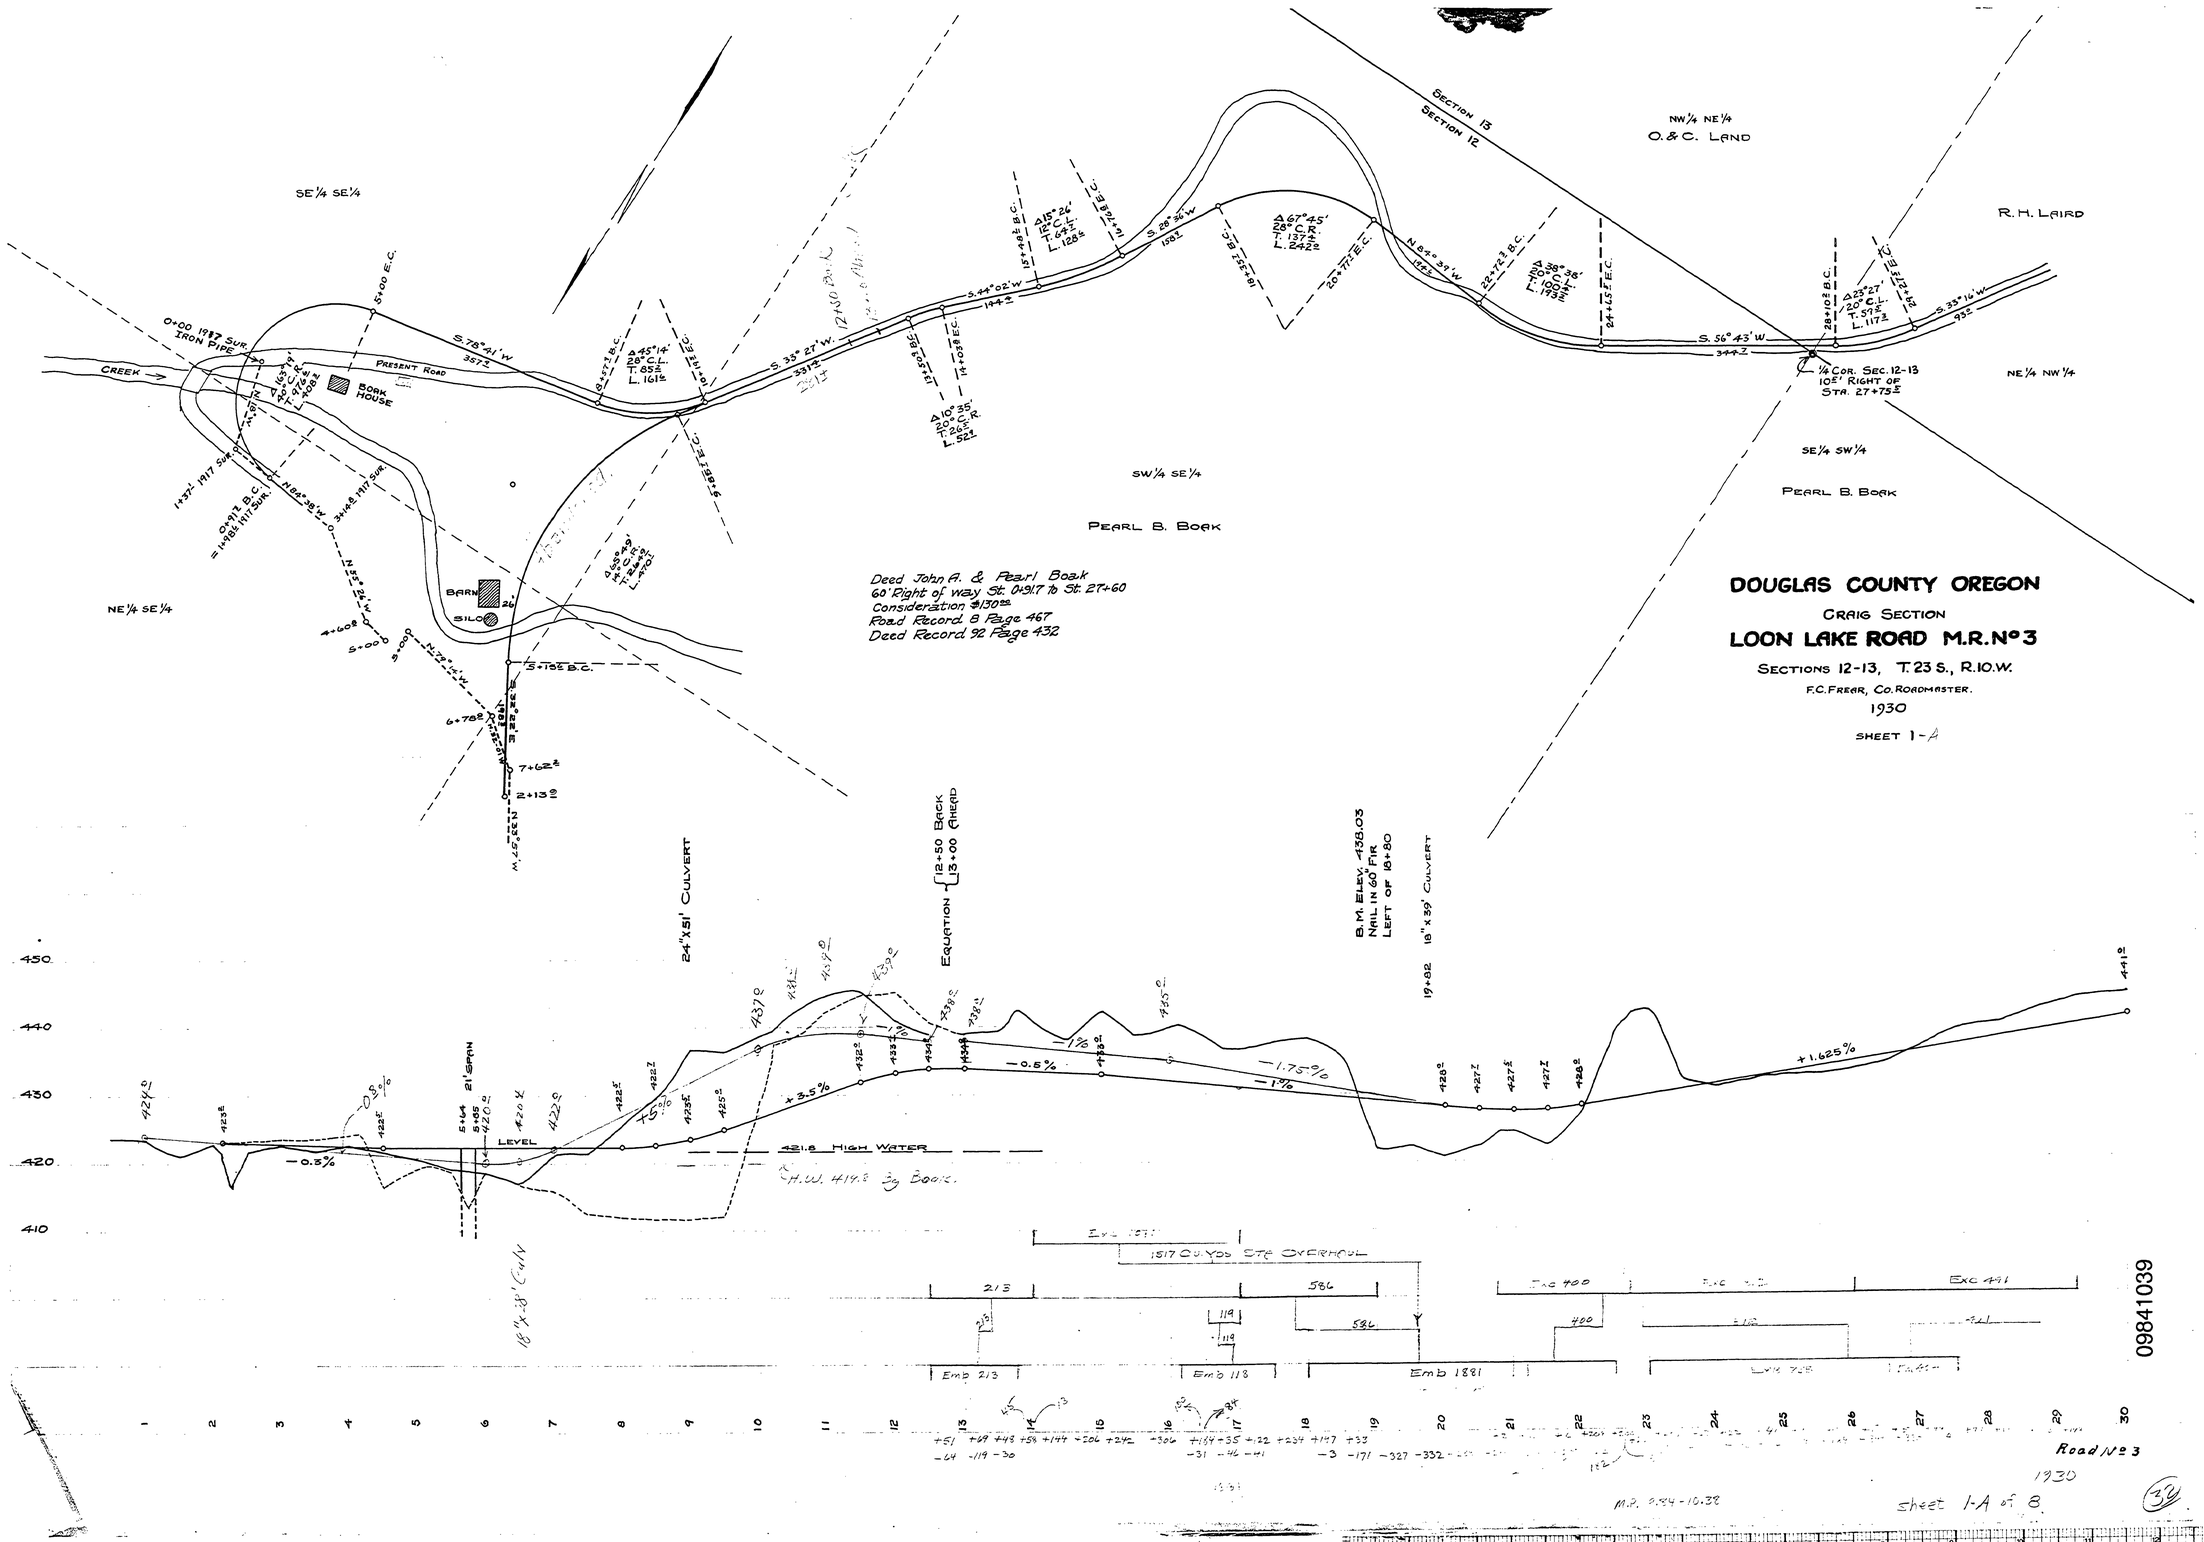
DOUGLAS COUNTY OREGON
CRAIG SECTION
LOON LAKE ROAD M.R. Nº 3
SECTIONS 12-13, T. 23 S., R. 10 W.
F.C. FREER, CO. ROADMASTER.
1930
SHEET 1-A
SECTION 13
SECTION 12
NW¼ NE¼
O. & C. LAND
R. H. LAIRD
SE¼ SE¼
NE¼ NW¼
SW¼ SE¼
SE¼ SW¼
NE¼ SE¼
PEARL B. BOAK
PEARL B. BOAK
CREEK
PRESENT ROAD
BOAK HOUSE
BARN
SILO
Deed John A. & Pearl Boak
60' Right of way St. 0+91.7 to St. 27+60
Consideration $130.00
Road Record 8 Page 467
Deed Record 92 Page 432
¼ COR. SEC. 12-13
10.0' RIGHT OF
STA. 27+75.0
24"x51' CULVERT
EQUATION 12+50 BACK 13+00 AHEAD
B.M. ELEV. 438.03
NAIL IN 60" FIR
LEFT OF 18+80
18"x39' CULVERT
421.8 HIGH WATER
H.W. 419.8 by Book.
LEVEL
18'x8' CULV
1517 CU. YDS. SITE OVERHAUL
Road Nº 3
1930
Sheet 1-A of 8
09841039