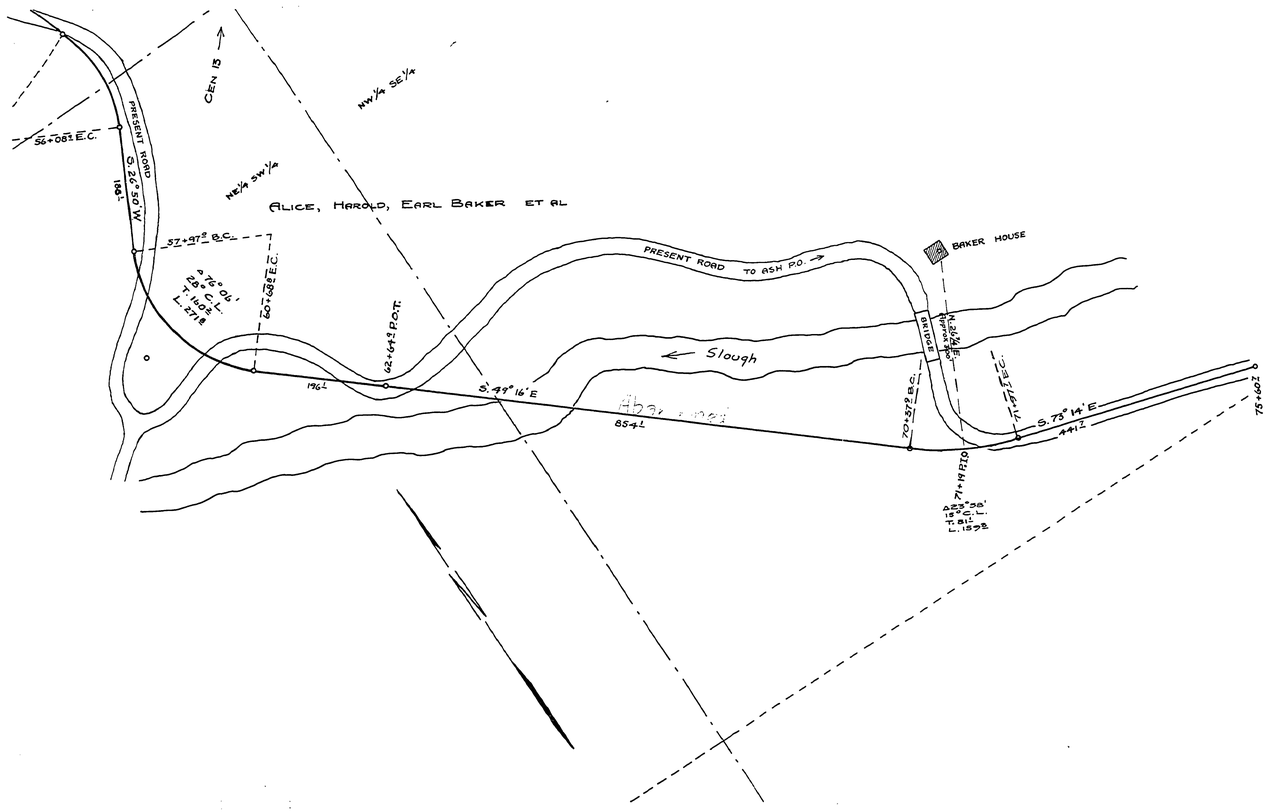

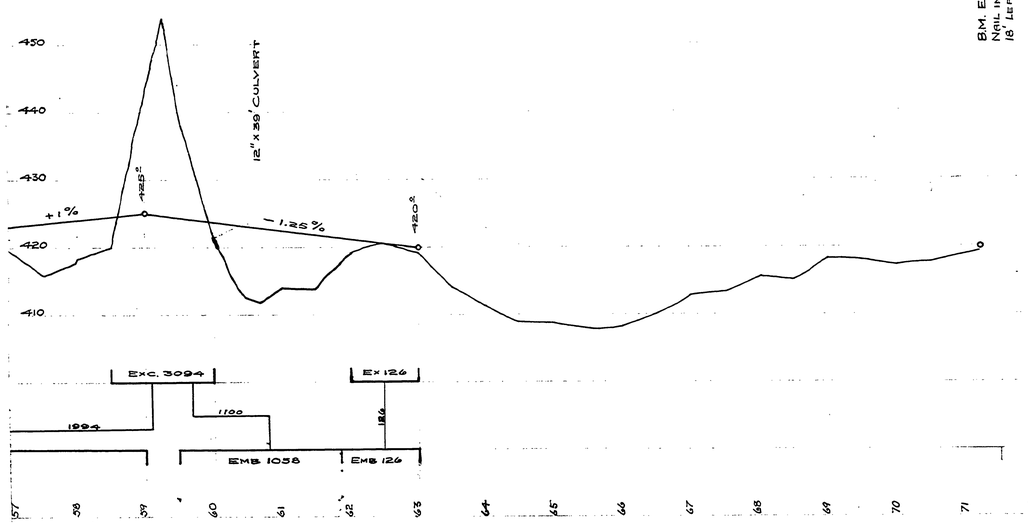

B.M. ELEV. 419.87
NAIL IN FENCE POST
18' LEFT OF 71+19

DOUGLAS COUNTY OREGON

CRAIG SECTION

LOON LAKE ROAD M.R. Nº 3

SECTIONS 12-13, T. 23 S., R. 10 W.

F.C. FREAR, CO. ROADMASTER.

1930

SHEET 3

1700' [illegible]

ORIGINAL LINE WITH FINE REVISION
STOP AT STA 68+00

EXCAVATION 14911 CU. YDS.

STA OVERHAUL 3.5

SHORTER TO BENCH AGAINST HILL

By Using Final Around Beaks House & Ending at Sta. 68 = 14911 Yds.
or Saving of 7511 Yds.

2nd Survey

Note - Stop at Sta. 52 [illegible] 6500 Yds [illegible] about 1600 Yds Line.

10921125

Road Nº 3.

1930

sht. 3 of 8

34

M.P. 10.93 - 11.05