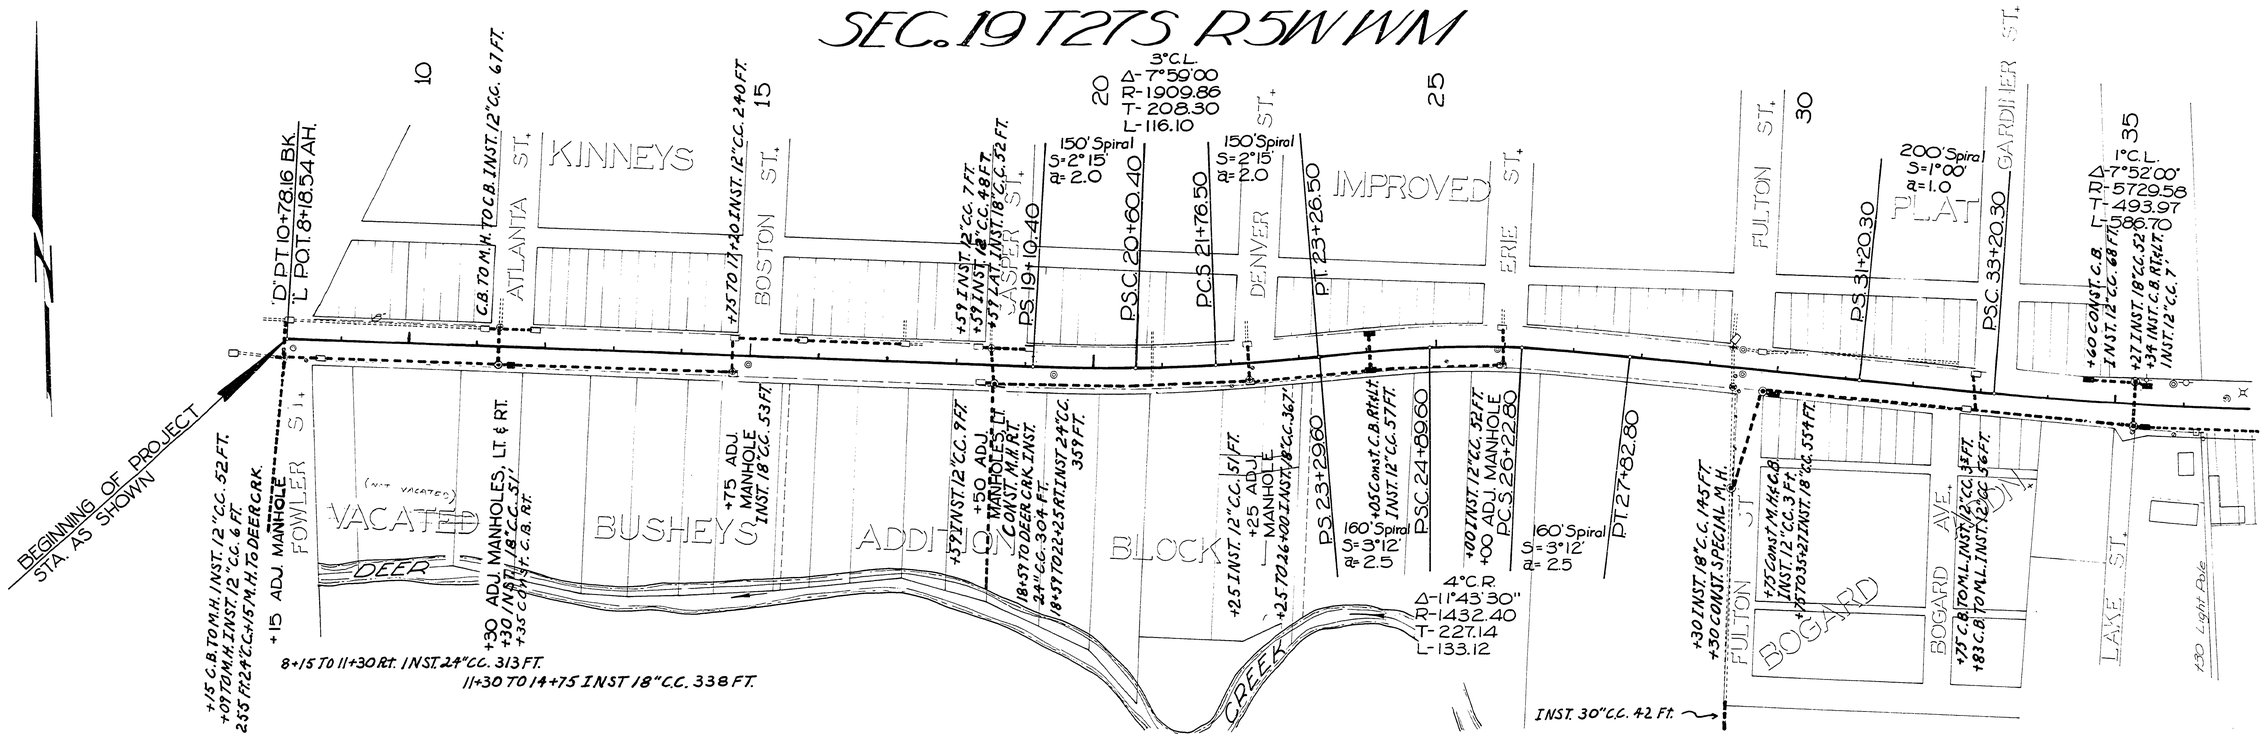

As Constructed 4-24-69 D.S.

Douglas County Road Dept.
DIAMOND LAKE BLVD. RD. #4
Date - June, 1968 Sheet 6 of 8
GEORGE E. GRUBB County Engineer

00160067

M.P. 0.16 - 0.67

Rd # 4