SEC 15 T26S R4W W.M.

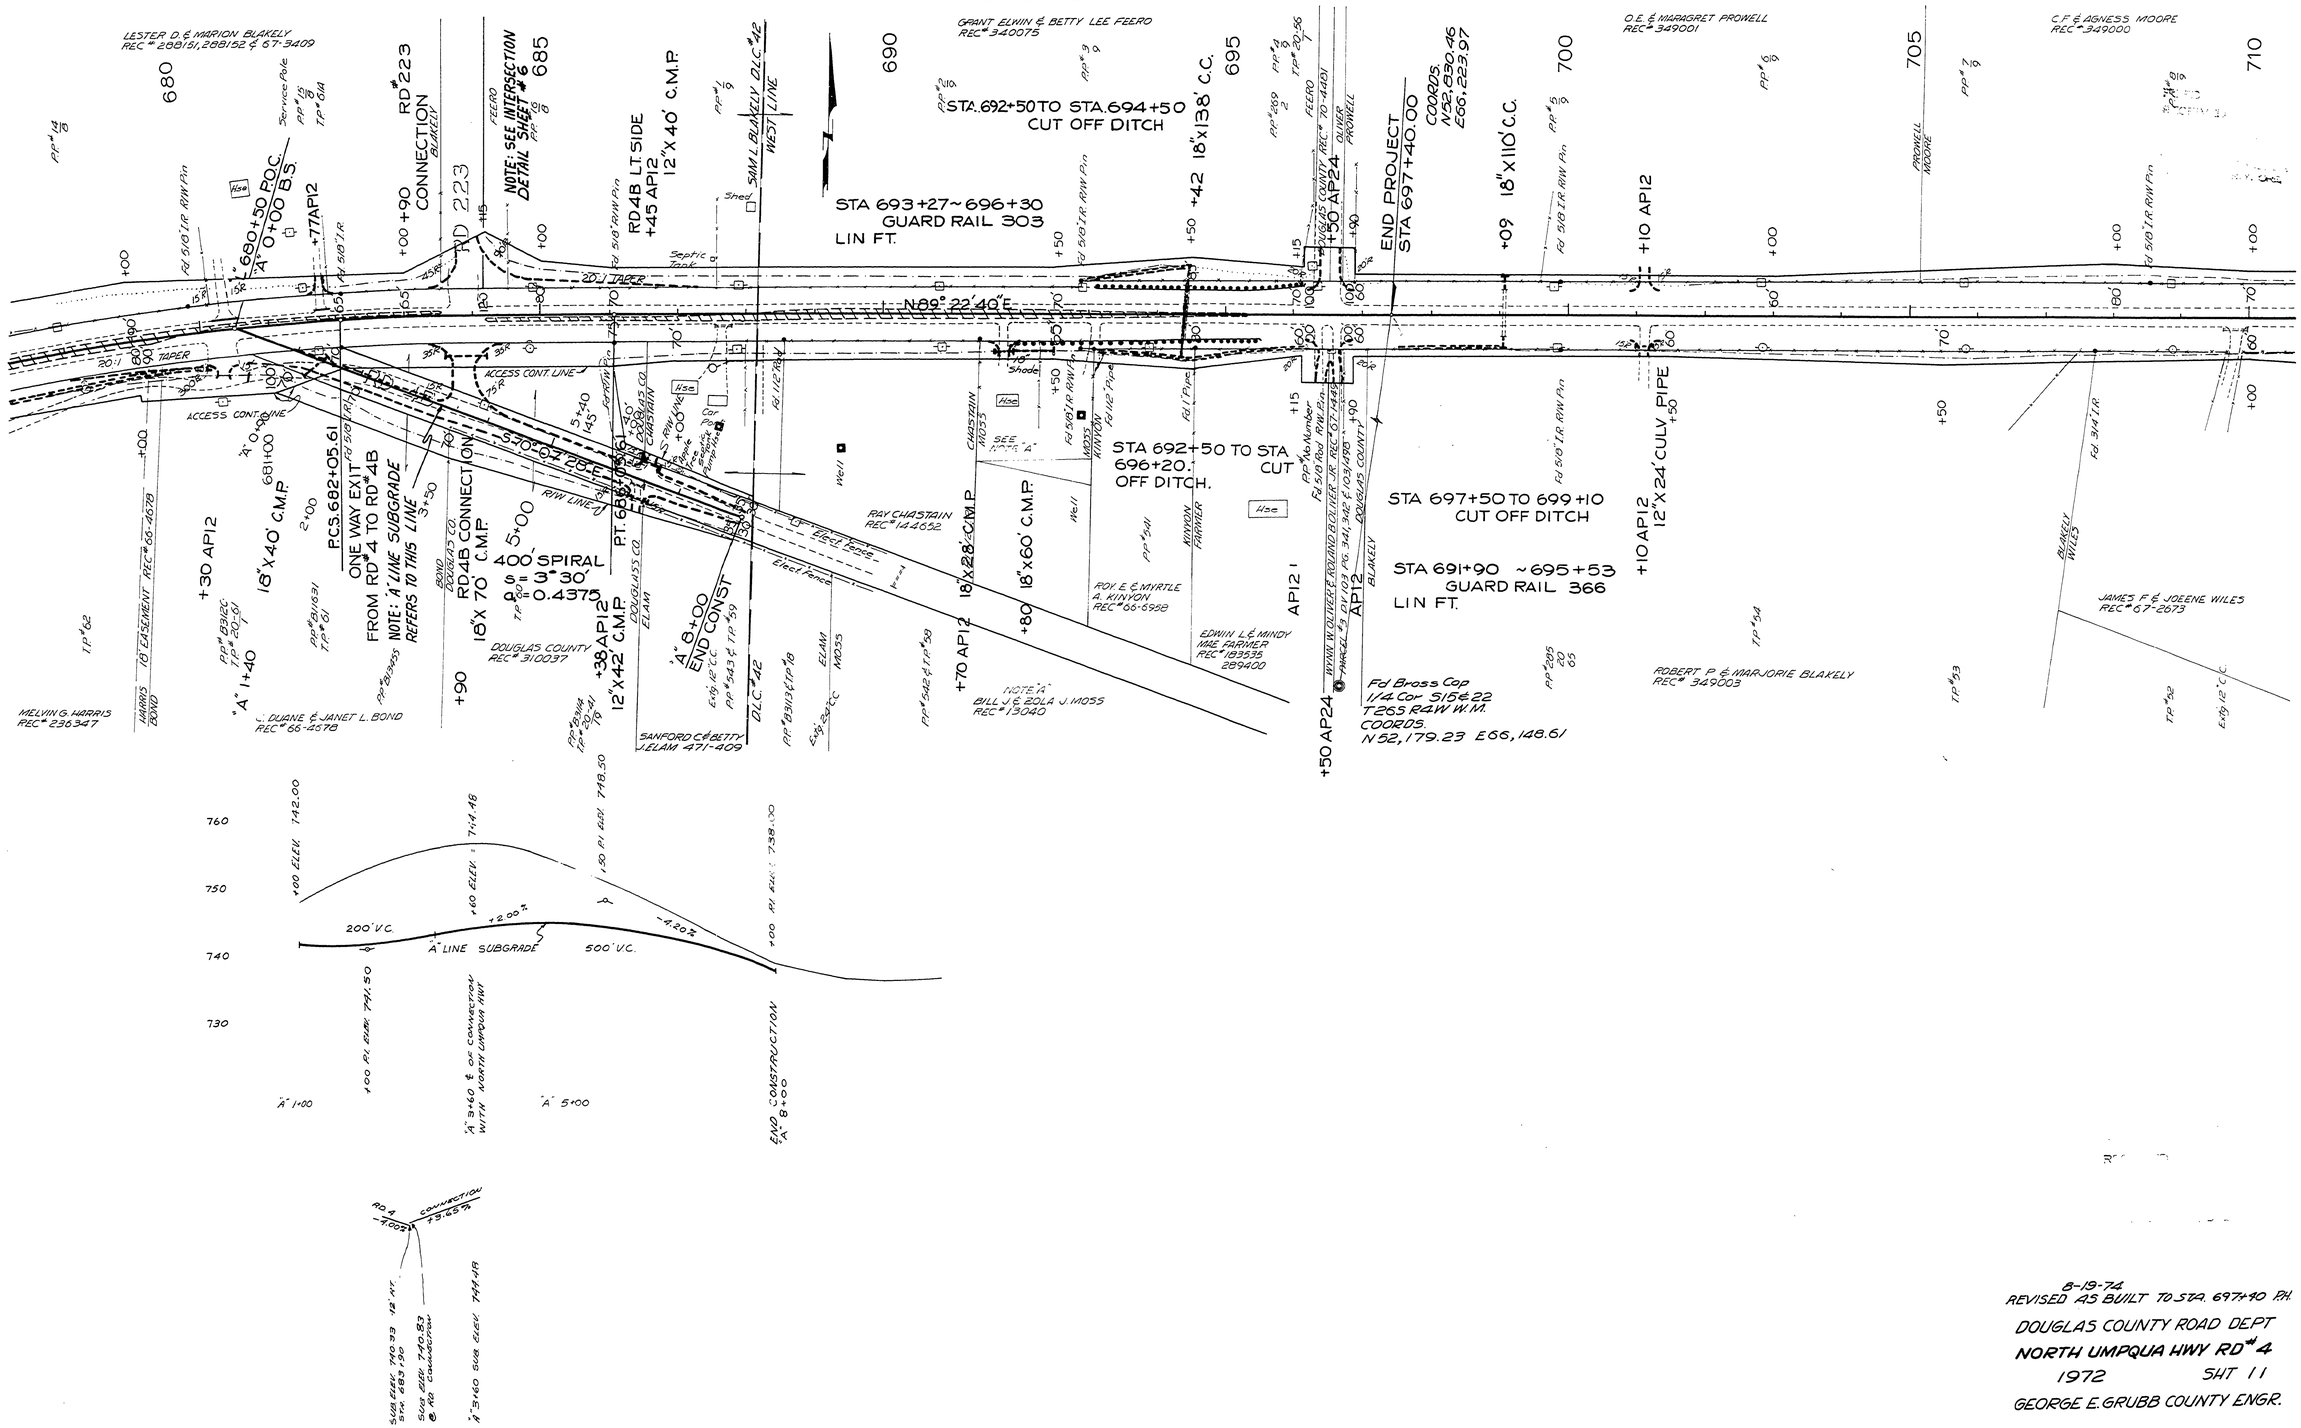

8-19-74
REVISED AS BUILT TO STA. 697+40 P.H.

DOUGLAS COUNTY ROAD DEPT
NORTH UMPQUA HWY RD# 4
1972 SHT 11
GEORGE E. GRUBB COUNTY ENGR.

13081361