SEC. 19 & SEC. 24 T 26 S R 3 & R 4 W W.M.

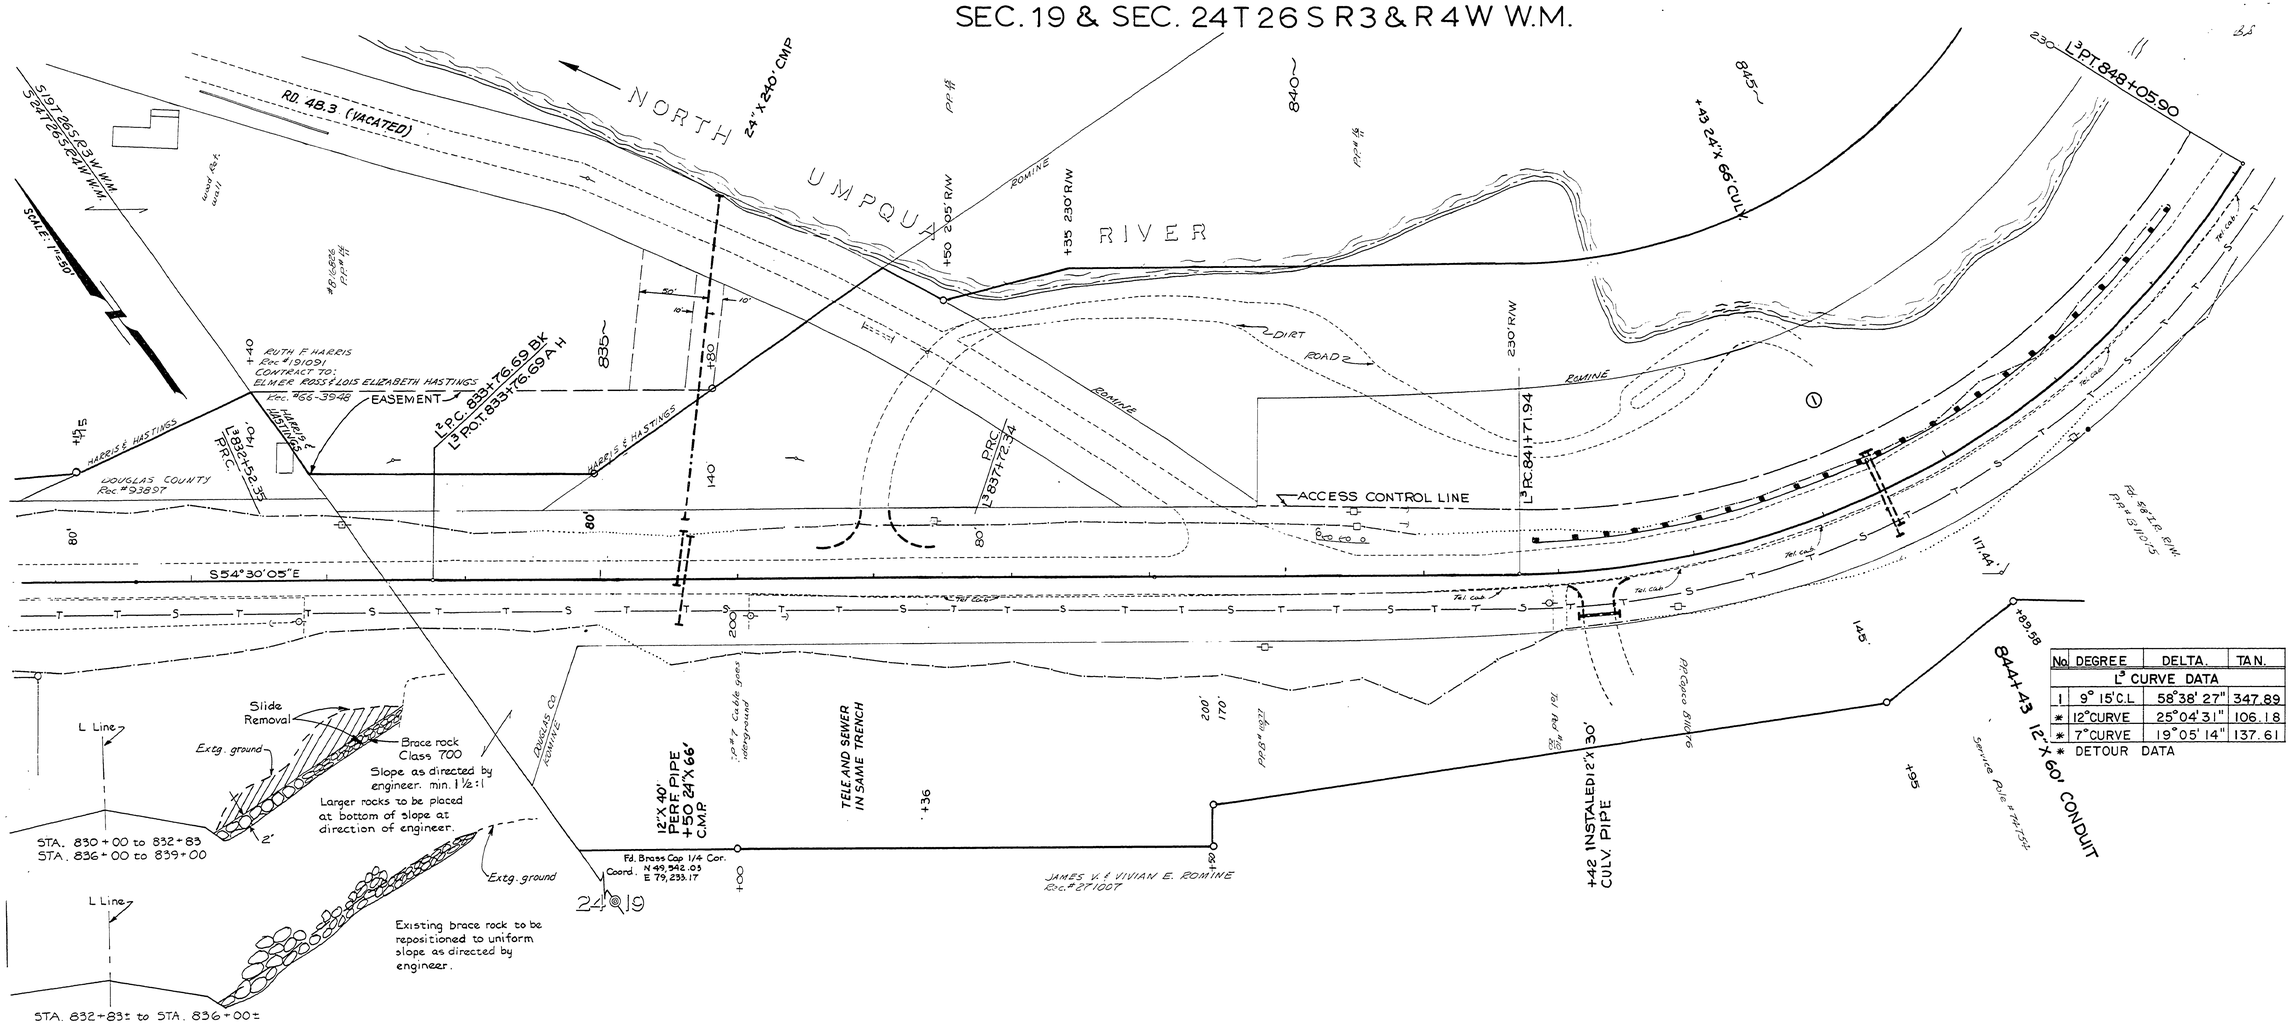

No.	DEGREE	DELTA.	TAN.
L³ CURVE DATA			
1	9° 15' C.L.	58°38' 27"	347.89
*	12° CURVE	25°04' 31"	106.18
*	7° CURVE	19°05' 14"	137.61

* * DETOUR DATA

15921624

DOUGLAS COUNTY
PUBLIC WORKS DEPARTMENT
NORTH UMPQUA HWY. ROAD 4
1977 SHT. 7
GEORGE E. GRUBB, DIRECTOR

M.P. 15.92 - 16.24

1977
Rd. # 4 Sht. 7 of 14

(103)