SEC. 17 T 26 S R 3 W W.M.

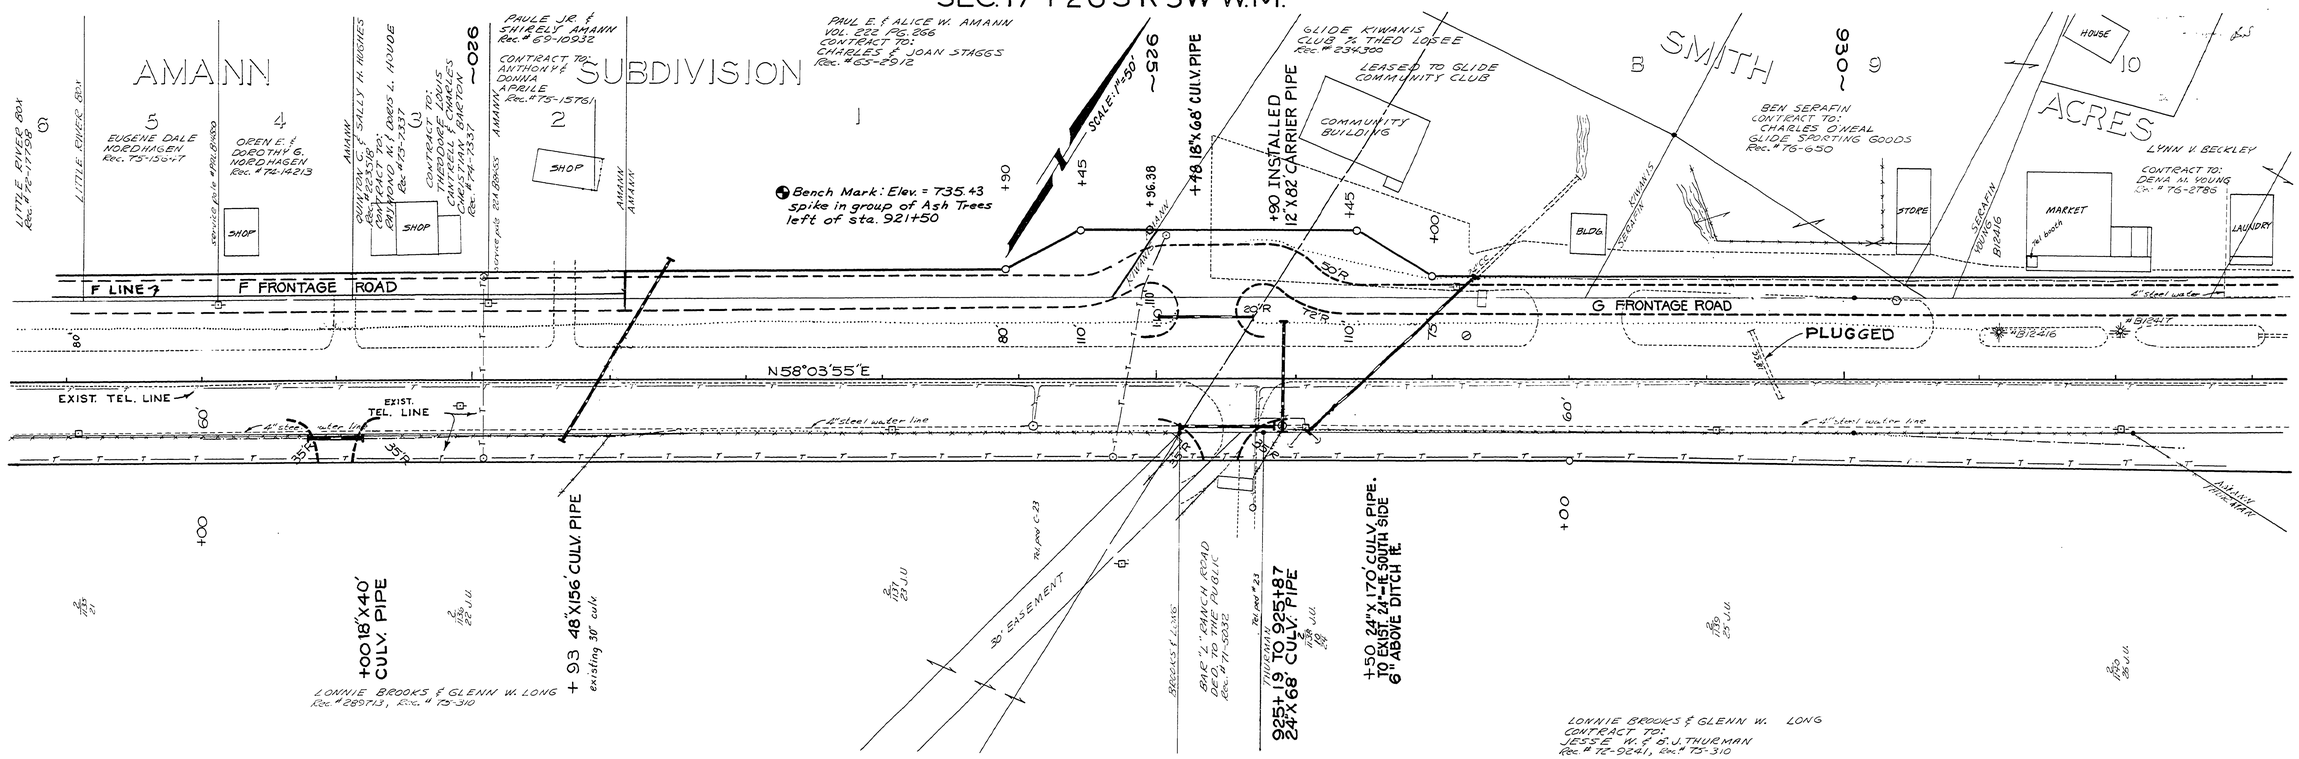
AMANN SUBDIVISION
LITTLE RIVER BOX
Rec. #72-17758
LITTLE RIVER BOX
5
EUGENE DALE NORDHAGEN
Rec. 75-1304-7
4
OREN E. & DOROTHY G. NORDHAGEN
Rec. #72-14213
SHOP
AMANN
QUINTON C. & SALLY H. HUGHES
Rec. #23308
ROBERT W. & RAYMOND W. & OREN L. HOUDE
Rec. #75-2337
3
SHOP
CONTRACT TO:
THEODORE LOUIS CONTRELL & DONALD LEE EARTON
Rec. #74-2337
~920
PAULE JR. & SHIRELY AMANN
Rec. # 69-10932
CONTRACT TO:
ANTHONY & DONNA APBLE
Rec. # 75-15761
2
SHOP
AMANN
PAUL E. & ALICE W. AMANN
VOL. 222 PG. 266
CONTRACT TO:
CHARLES & JOAN STAGGS
Rec. #63-2912
1
SCALE: 1" = 50'
~925
Bench Mark: Elev. = 735.43
spike in group of Ash Trees
left of sta. 921+50
+90
+45
+36.38
+48.18" X 68' CULV. PIPE
+90 INSTALLED
12" X 82' CARRIER PIPE
+45
+00
GLIDE KIWANIS CLUB % THEO LOSEE
Rec. # 234300
LEASED TO GLIDE COMMUNITY CLUB
COMMUNITY BUILDING
B SMITH
~930
9
BEN SERAFIN
CONTRACT TO:
CHARLES O'NEAL
GLIDE SPORTING GOODS
Rec. # 76-690
BLDG.
STORE
MARKET
LAUNDRY
HOUSE
10
ACRES
LYNN V. BECKLEY
CONTRACT TO:
DENA M. YOUNG
Rec. # 76-2786
F LINE
F FRONTAGE ROAD
G FRONTAGE ROAD
PLUGGED
N 58°03'55"E
EXIST. TEL. LINE
EXIST. TEL. LINE
4" steel water line
+00
+00
+00